



Oregon Water Resources Department Notice of Exempt Reservoir

For reservoirs built before January 1, 1995, that:

- Store less than 9.2 acre-feet of water, or
- Have a dam less than 10 feet high.

The deadline for submitting a Notice of Exempt Reservoir is January 31, 1997. WATER RESOURCES DEPT. SALEM, OREGON

RECEIVED

JUL 22 1996

Landowner: COLE, THOMAS "OE."
Last name First name MI

Authorized Agent: _____
Last name First name MI

Address: 40969 ROWE CREEK RD

MITCHELL OR 97750
City State Zip

Phone: 541 462-3234

SEP 03 1996

FAX: 541 462-3236 Home Work

E-Mail Address: _____ WATER RESOURCES DEPT. SALEM, OREGON

RECEIVED

A. County of use: WHEELER B. River basin (see reverse): NO 6

C. Legal description of reservoir location:

Township	Range	Section	Quarter/Quarter	Tax Lot #
<u>9S</u>	<u>21E</u>	<u>15</u>	<u>SE</u>	<u>100</u>

D. Name, if any, of reservoir: N.A. E. Reservoir in existence since: 11/1/85
MM DD YY

F. Source of water: ROWE CR. which flows into JOHN DAY RIVER
Name of river or creek Name of river or creek

G. Maximum height of dam: N.A. feet (POND)

H. Quantity of water stored in reservoir at maximum capacity (see reverse): 4,000 ^{0.09} acre-feet
CUBIC FEET

I. Water stored in reservoir is used for (see reverse): WATER IS NOT USED FLOWS FROM ROWE CR THROUGH POND & BACK INTO ROWE CR

J. Rate and area of use—Refer to chart on the back of this form. For each type of water use listed in Item I., show the quantity of water used and, if applicable, the number of acres on which water is used.

BEFORE YOU SIGN AND SUBMIT THIS APPLICATION . . . HAVE YOU:

- ☒ Answered each question on this form as completely as possible?
- ☒ Attached a legible map showing township, section, range, quarter-quarter & tax lot number?

By my signature below, I swear that all statements made and information provided in this application are true to the best of my knowledge.

Thomas Cole
(Signature of Landowner/Agent)

THOMAS COLE OWNER
(Printed name and title)

(Date)

For Department Use

9-815111


File #

Date received

10-95

Oregon's major river basins:

- | | | |
|---------------|-----------------|--------------|
| 1-North Coast | 8-Grande Ronde | 15-Rogue |
| 2-Willamette | 9-Powder | 16-Umpqua |
| 3-Sandy | 10-Malheur | 17-S. Coast |
| 4-Hood | 11-Owyhee | 18-Mid Coast |
| 5-Deschutes | 12-Malheur L. | 19-Columbia |
| 6-John Day | 13-Goose/Summer | 20-Snake |
| 7-Umatilla | 14-Klamath | |

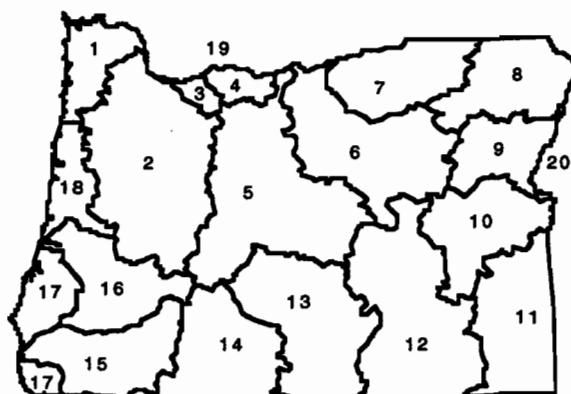

One acre-foot is the volume of water that would cover one acre with one foot of water. To find out how much water your pond stores, multiply the surface area by the average depth. This will give you a rough estimate of cubic feet. One acre-foot equals 43,560 cubic feet. You can submit a Notice of Exempt Reservoir if your pond stores less than 400,752 cubic feet—43,560 X 9.2.

Rate and Area of Use

cfs—cubic feet per second

gpm—gallons per minute

Agriculture, Land Management

Gen. Agriculture	cfs/gpm	# acres	Cranberry	cfs/gpm	# acres
Irrigation	cfs/gpm	# acres	Nursery Operatr.	cfs/gpm	# acres
Stockwater	cfs/gpm	# acres	Temp. Control	cfs/gpm	# acres
Aquatic Life	cfs/gpm	# acres	Forest/Range Mgt	cfs/gpm	# acres
Other:	cfs/gpm	# acres	Other:	cfs/gpm	# acres

Industrial/Commercial Uses

Industrial	cfs/gpm	_____	Commercial	cfs/gpm	_____
Fire Protection	cfs/gpm	_____	Mining	cfs/gpm	_____
Power Dev.	cfs/gpm	_____	Other:	cfs/gpm	_____

Drinking Water Supply

Human Consumption	cfs/gpm	_____	Domestic	cfs/gpm	_____
Domestic	cfs/gpm	_____	Other:	cfs/gpm	_____
Expanded	cfs/gpm	_____			

Community Water Supply

Municipal	cfs/gpm	_____	Quasi-Municipal	cfs/gpm	_____
Group Domestic	cfs/gpm	_____	Storm Water Mgt	cfs/gpm	_____
Other:	cfs/gpm	_____	Other:	cfs/gpm	_____

Environmental Benefits

Pollution Abatement	cfs/gpm	_____	Recreation	cfs/gpm	_____
Wetland Enhancement	cfs/gpm	_____	Wildlife ✓	cfs/gpm	NO USE
Other:	cfs/gpm	_____	Other: LANDSCAPING	cfs/gpm	NO USE



Oregon Water Resources Department Notice of Exempt Reservoir

For reservoirs built before January 1, 1995, that:

- Store less than 9.2 acre-feet of water, or
- Have a dam less than 10 feet high.

The deadline for submitting a Notice of Exempt Reservoir is January 31, 1997.

RECEIVED

JUL 22 1996

WATER RESOURCES DEPT.
SALEM, OREGON

Landowner: COLE, THOMAS D.E.
Last name First name MI

Authorized Agent: _____
Last name First name MI

Address: 40969 ROWE CR RD

MITCHELL OR. 97750
City State Zip

Phone: 541 462-3234 _____
Home Work

FAX: 541 462-3236 E-Mail Address: _____

RECEIVED

SEP 03 1996

WATER RESOURCES DEPT.
SALEM, OREGON

A. County of use: WHEELER B. River basin (see reverse): NO 6

C. Legal description of reservoir location:

Township	Range	Section	Quarter/Quarter	Tax Lot #
<u>8S</u>	<u>21E</u>	<u>15</u>	<u>SE</u>	<u>100</u>

D. Name, if any, of reservoir: _____ E. ^{POND} Reservoir in existence since: 1/1/80
MM DD YY

F. Source of water: ROWE CR. which flows into JOHN DAY
Name of river or creek Name of river or creek

G. Maximum height of dam: N.A. feet. (POND)

H. Quantity of water stored in reservoir at maximum capacity (see reverse): 1,200 ^{0.03} CUBIC ~~acre~~-feet.
WATER IS NOT USED, FLOWS FROM ROWE CR.

I. Water stored in reservoir is used for (see reverse): THROUGH POND & BACK INTO ROWE CR.

J. Rate and area of use—Refer to chart on the back of this form. For each type of water use listed in Item I., show the quantity of water used and, if applicable, the number of acres on which water is used.

BEFORE YOU SIGN AND SUBMIT THIS APPLICATION . . . HAVE YOU:

- ☒ Answered each question on this form as completely as possible?
- ☒ Attached a legible map showing township, section, range, quarter-quarter & tax lot number?

By my signature below, I swear that all statements made and information provided in this application are true to the best of my knowledge.

Thomas Cole
(Signature of Landowner/Agent)

THOMAS COLE OWNER
(Printed name and title)

(Date)

For Department Use


File #

Date received

10-95

Oregon's major river basins:

- | | | |
|---------------|-----------------|--------------|
| 1-North Coast | 8-Grande Ronde | 15-Rogue |
| 2-Willamette | 9-Powder | 16-Umpqua |
| 3-Sandy | 10-Malheur | 17-S. Coast |
| 4-Hood | 11-Owyhee | 18-Mid Coast |
| 5-Deschutes | 12-Malheur L. | 19-Columbia |
| 6-John Day | 13-Goose/Summer | 20-Snake |
| 7-Umatilla | 14-Klamath | |

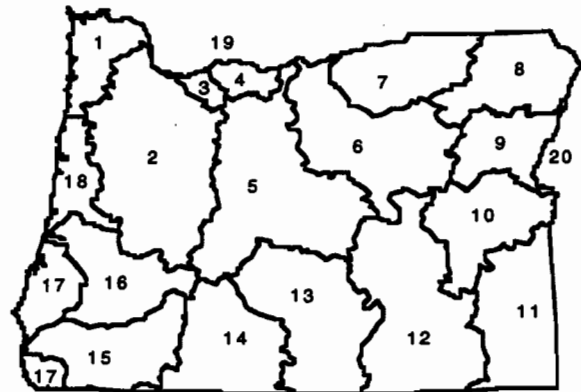

One acre-foot is the volume of water that would cover one acre with one foot of water. To find out how much water your pond stores, multiply the surface area by the average depth. This will give you a rough estimate of cubic feet. One acre-foot equals 43,560 cubic feet. You can submit a Notice of Exempt Reservoir if your pond stores less than 400,752 cubic feet-43,560 X 9.2.

Rate and Area of Use

cfs-cubic feet per second

gpm-gallons per minute

Agriculture, Land Management

Gen. Agriculture	cfs/gpm	# acres	Cranberry	cfs/gpm	# acres
Irrigation	cfs/gpm	# acres	Nursery Operatn.	cfs/gpm	# acres
Stockwater	cfs/gpm	# acres	Temp. Control	cfs/gpm	# acres
Aquatic Life	cfs/gpm	# acres	Forest/Range Mgt	cfs/gpm	# acres
Other:	cfs/gpm	# acres	Other:	cfs/gpm	# acres

Industrial/Commercial Uses

Industrial	cfs/gpm	_____	Commercial	cfs/gpm	_____
Fire Protection	cfs/gpm	_____	Mining	cfs/gpm	_____
Power Dev.	cfs/gpm	_____	Other:	cfs/gpm	_____

Drinking Water Supply

Human Consumption	cfs/gpm	_____	Domestic	cfs/gpm	_____
Domestic	cfs/gpm	_____	Other:	cfs/gpm	_____
Expanded	cfs/gpm	_____			

Community Water Supply

Municipal	cfs/gpm	_____	Quasi-Municipal	cfs/gpm	_____
Group Domestic	cfs/gpm	_____	Storm Water Mgt	cfs/gpm	_____
Other:	cfs/gpm	_____	Other:	cfs/gpm	_____

Environmental Benefits

Pollution Abatement	cfs/gpm	_____	Recreation	cfs/gpm	_____
Wetland Enhancement	cfs/gpm	_____	Wildlife	cfs/gpm	<u>NO USE</u>
Other:	cfs/gpm	_____	Other: LANDSCAPING	cfs/gpm	<u>NO USE</u>

September 27, 1996

Oregon

THOMAS COLE

40969 ROWE CR RD
MITCHELL, OR 97750

WATER
RESOURCES
DEPARTMENT

REFERENCE: File # P-81511;

Notice of Exempt Reservoir (Pond)

This is to let you know that we have received your Notice of Exempt Reservoir and assigned it the number listed above. Please refer to this number if you need to contact us about the notice. As required by law, your Notice of Exempt Reservoir filing will appear in our weekly public notice within 90 days from the time it was filed.

We have determined that your reservoir appears to meet the general criteria for exemption from the requirement to obtain a permit. However, we feel it is important to tell you that the Department must accept comments until August 1, 1997 on whether the reservoir poses a threat to fishery resources or existing water right holders. After the August 1, 1997 deadline, the Department has 180 days to assess comments. Any such comments will be reviewed and you will be notified only if any action on your part is necessary.

If no comments are received or the Department's assessment shows your pond does not cause injury, your pond will be considered exempt. You are advised that this exemption is limited to the amount of water that had been stored prior to January 1, 1995. Any increase in the storage or use of the stored water after that date must be authorized under a permit issued by this Department.

If you have any questions, please write to use at the address below, or call the Water Rights Information Group at (503)378-8455 ext. 499 or toll free in Oregon, 1-800-624-3199 ext. 499.

Sincerely,



Anita McLoud
Water Rights Specialist
Water Rights Division

cc: Watermaster District #4



Commerce Building
158 12th Street NE
Salem, OR 97310-0210
(503) 378-3739
FAX (503) 378-8130

July 29, 1996

RECEIVED

Oregon

SEP 03 1996

WATER RESOURCES DEPT.
SALEM, OREGON

Mr. Thomas O. E. Cole
40969 Rowe Cr. Rd.
Mitchell, OR 97750

WATER
RESOURCES
DEPARTMENT

Dear Mr. Cole,

We have received your Notice of Exempt Reservoir, however we are unable to accept and file the Notice at this time. A preliminary review of your Notice of Exempt Reservoir indicates the following item(s) were not included on or with your application:

- ▶ A map showing the Township, Range, Section, Quarter-Quarter and Tax Lot. (A copy of an assessors plat map is a very good map to use.) The map is required before we can accept the Notice. The ponds need to be drawn in on a map and referenced on both the form and the map such as #1 and #2. You may put the ponds on the enlarged map I made for you or use the map that you sent originally. Everything else appears to be in order.

Should you have any questions regarding the information listed above, please call the Water Rights Information Group at 1-800-624-3199, extension 499.


Sincerely,



BOB GEISLER
Water Rights Specialist
Enclosures



Commerce Building
158 12th Street NE
Salem, OR 97310-0210
(503) 378-3739
FAX (503) 378-8130

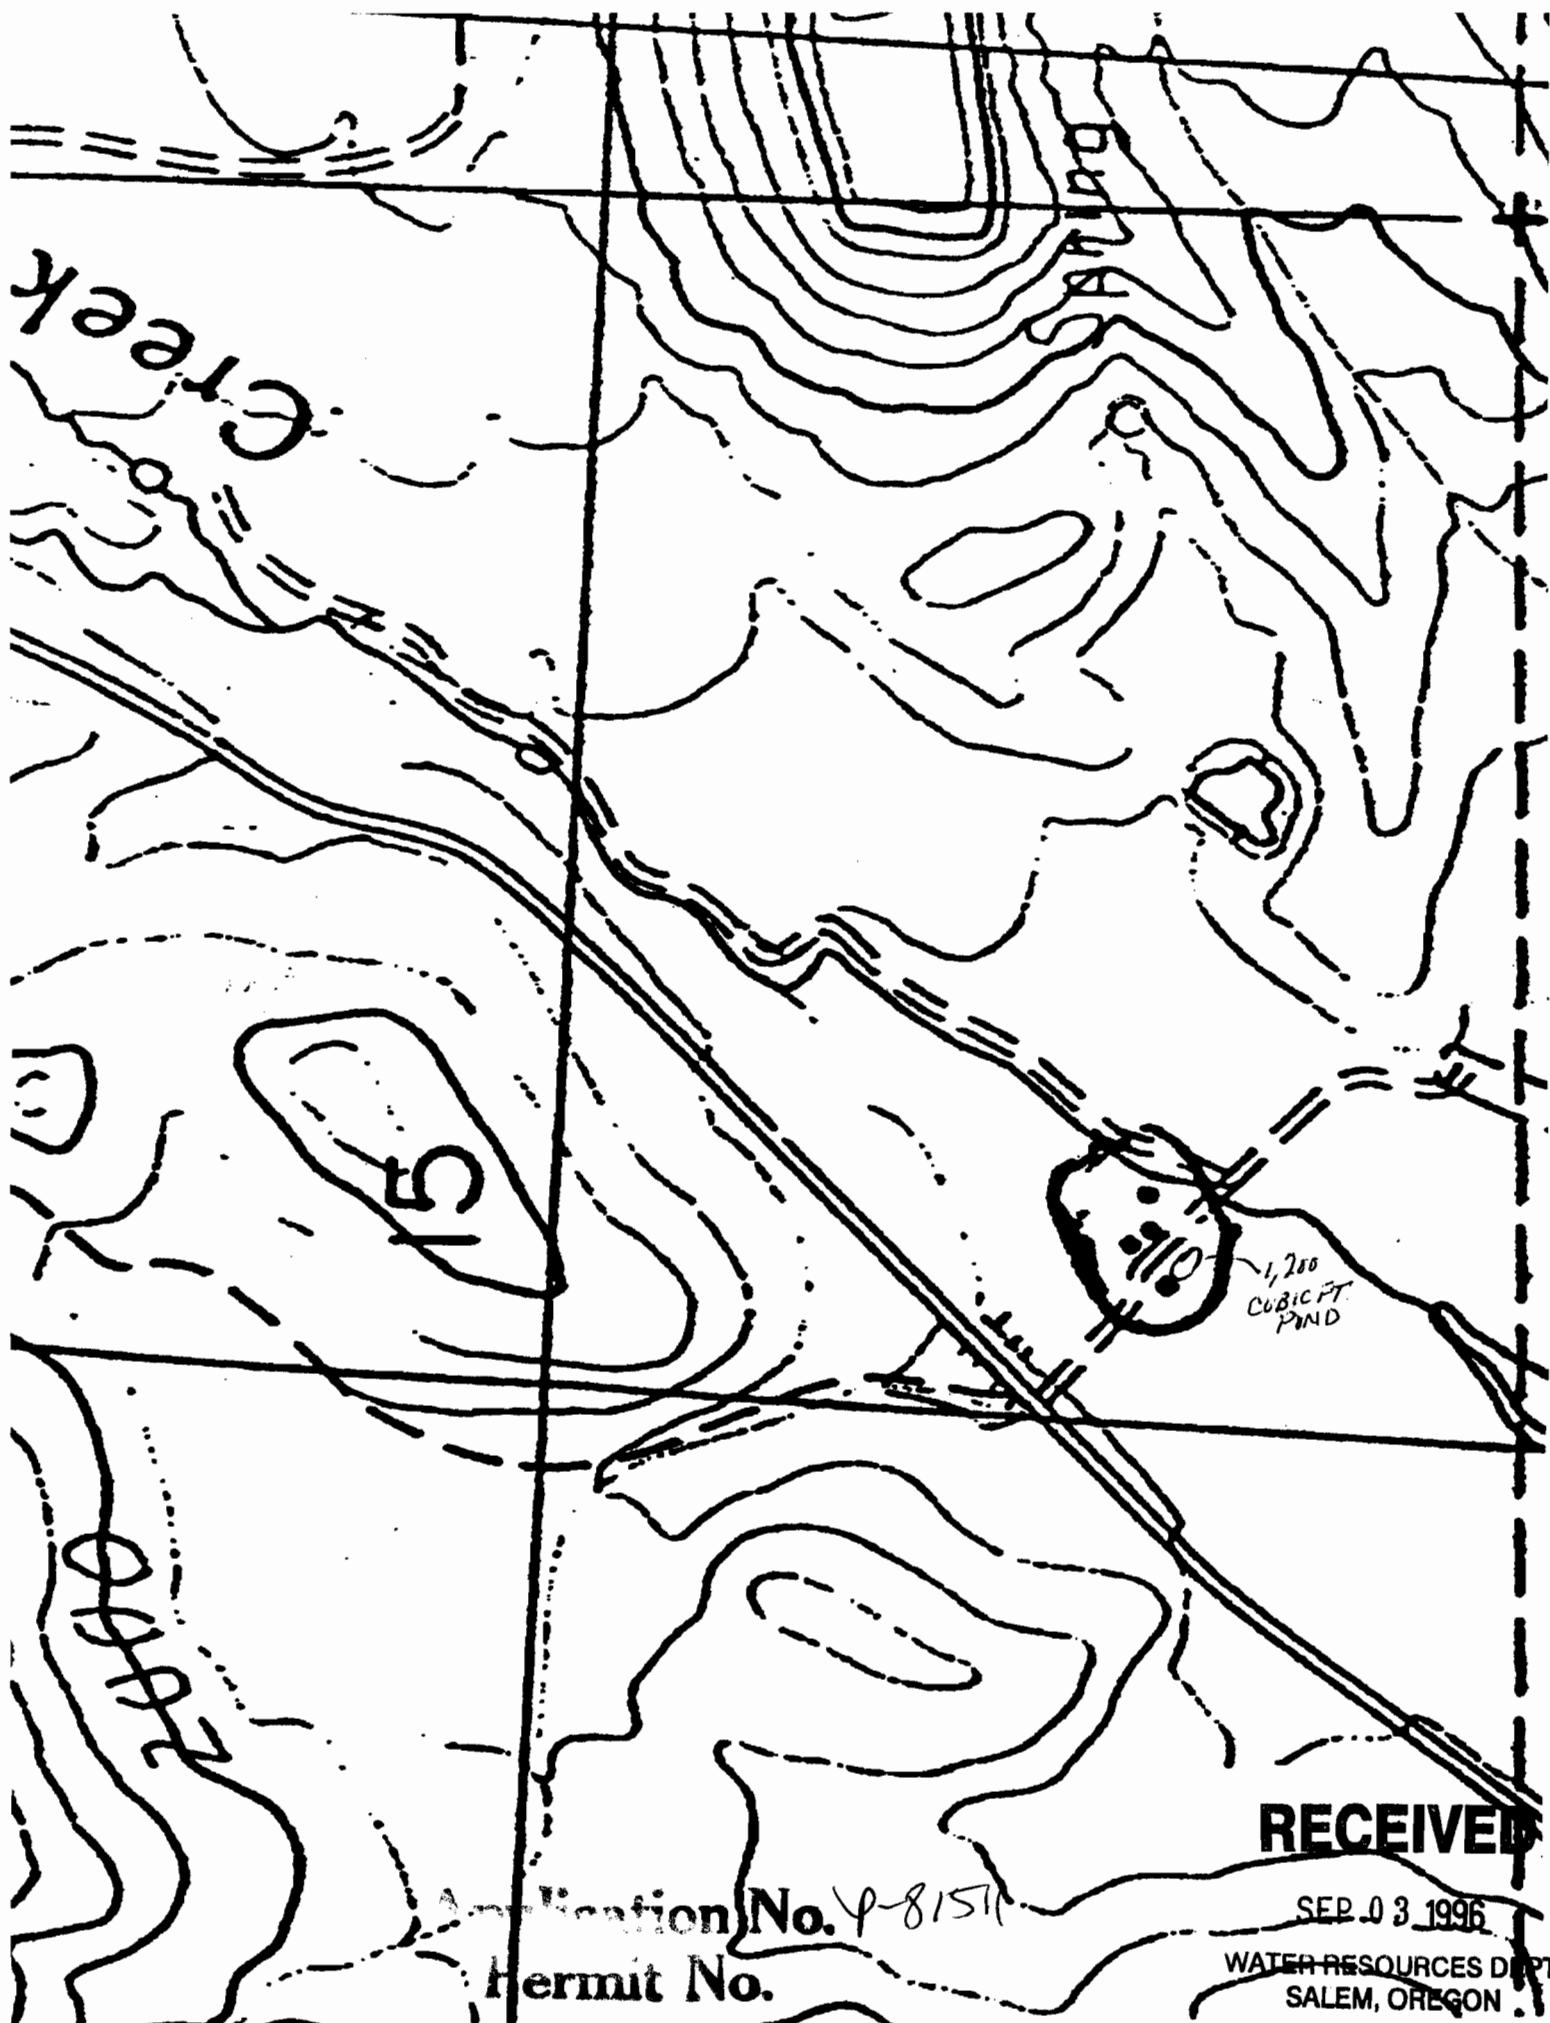

RECEIVED

SEP 03 1996

WATER RESOURCES DIV.
SALEM, OREGON

Application No. 4-81511

Hermit No.

4,000 CUBIC FT
POND

Application No. 81511
Permit No.

Creek
RECEIVED

SEP 03 1996
WATER RESOURCES DEPT.
SALEM, OREGON