


Application for a Permit to Use Groundwater In the Name of: Taylor Northwest

Deschutes County, Oregon

Section 22, Township 17 South, Range 11 East (W.M.)

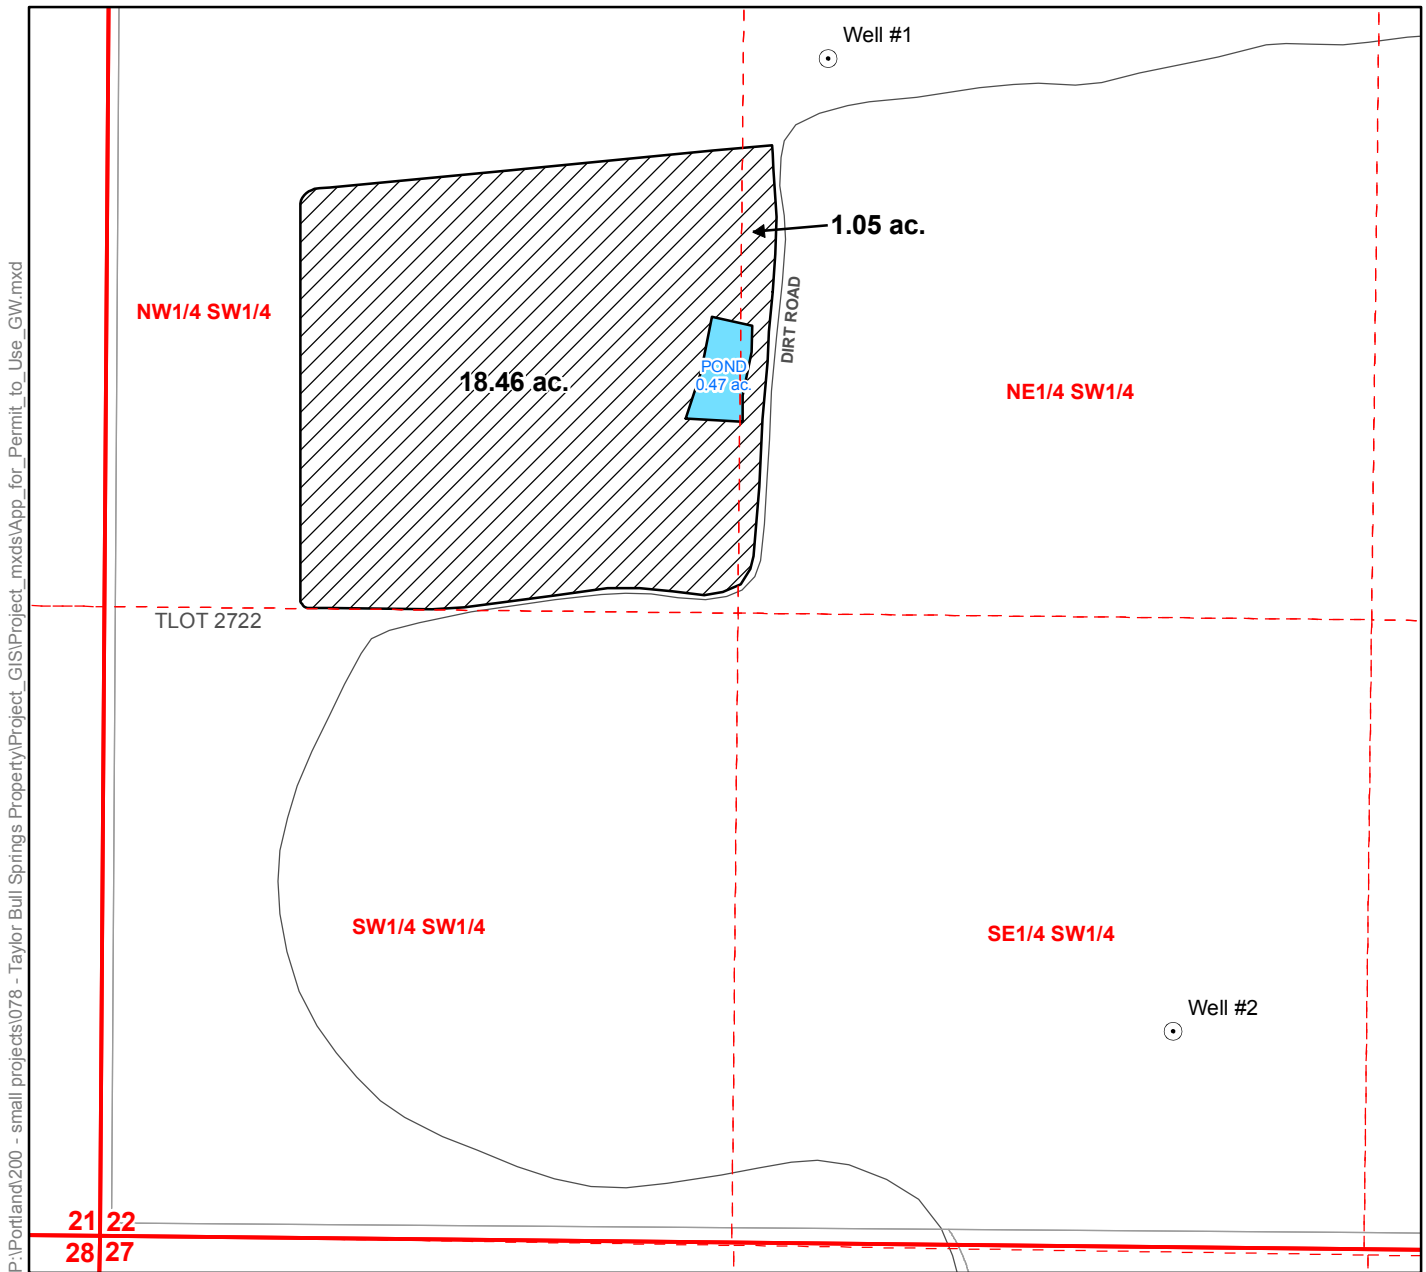

Legend

- Proposed Point of Appropriation (POA)
- Proposed Place of Use (POU)
- Pond
- Tax Lots

POA Location Descriptions

Well #1

Located 2,465 feet North and 1,500 feet East from the SW corner of Section 22, Township 17S, Range 11E (W.M.)

Well #2

Located 445 feet North and 2,240 feet East from the SW corner of Section 22, Township 17S, Range 11E (W.M.)

Map Information


Projection: Oregon State Plane South Zone
Datum: North American Datum of 1983
Date: January 4, 2010
Prepared By: GSI Water Solutions, Inc.

Data Sources

Deschutes County GIS, Oregon Geospatial Data Clearinghouse

Disclaimer

This map was prepared for the purpose of identifying the location of a water right only and it is not intended to provide legal dimensions or location of property ownership lines.

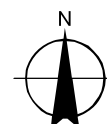

Scale
0 200 400
1 inch equals 400 feet





Water Solutions, Inc.

December 21, 2009

Jeana Eastman
Oregon Water Resources Department
725 Summer Street NE, Suite A
Salem, OR 97301-1266

Subject: Groundwater Right Application G-17093
Revision to the Place of Use

Dear Jeana,

GSI Water Solutions, Inc. is submitting the attached revision to groundwater application G-17093, in the name of Taylor Northwest, LLC. Between the submittal of the original application and the Departments recent completion of the Initial Review, Mr. Taylor's has altered the lands he wishes to irrigate from that shown in his original application. Attached is a map showing a revised place of use. This revised irrigated area is identical in size to the area in the original application (19.51 acres). In addition, the location of Well 1 was also refined on this new map.

If you have any questions regarding this revision please contact me at (541) 678-5117.

Sincerely,

A handwritten signature in blue ink that reads "Bruce Brody-Heine".

Bruce Brody-Heine, RG, CWRE
Principal Hydrogeologist

Enclosures:


Revise POU Map

Cc Todd Taylor

Application for a Permit to Use Groundwater In the Name of: Taylor Northwest

Deschutes County, Oregon

Section 22, Township 17 South, Range 11 East (W.M.)

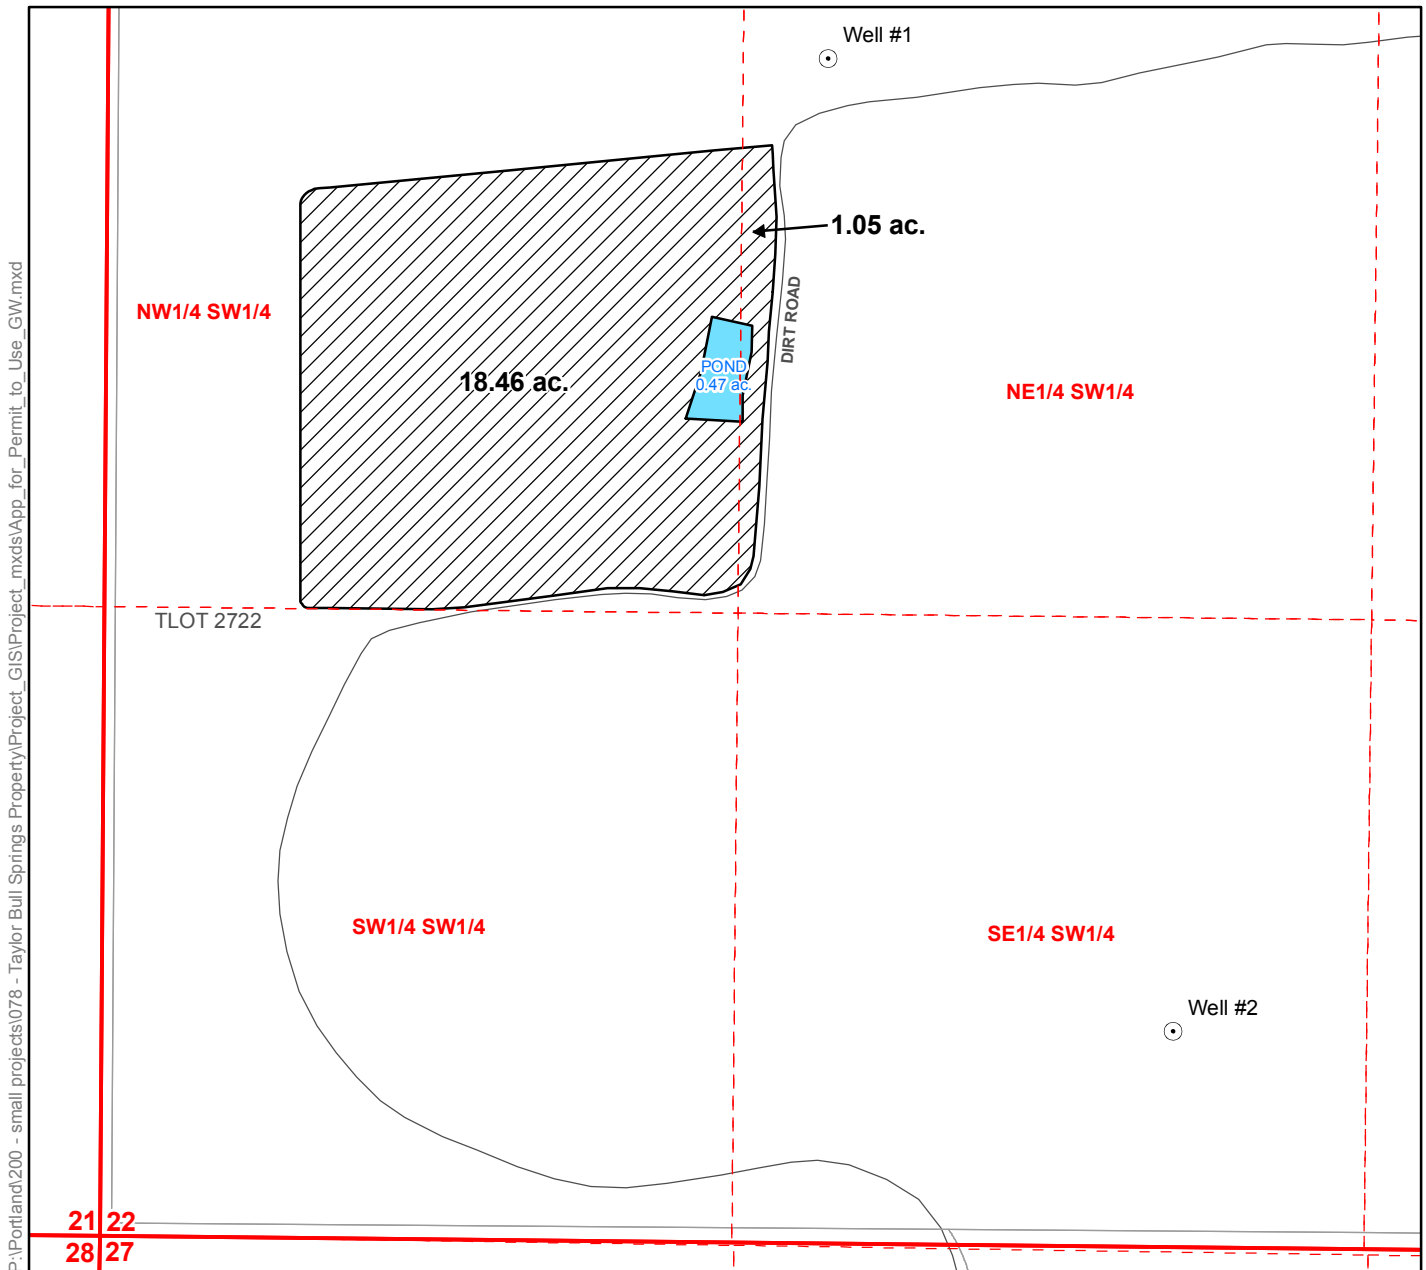

Legend

- Proposed Point of Appropriation (POA)
- ▨ Proposed Place of Use (POU)
- ☞ Pond
- Tax Lots

POA Location Descriptions

Well #1

Located 2,465 feet North and 1,500 feet East from the SW corner of Section 22, Township 17S, Range 11E (W.M.)

Well #2

Located 445 feet North and 2,230 feet East from the SW corner of Section 22, Township 17S, Range 11E (W.M.)

Map Information


Projection: Oregon State Plane South Zone
Datum: North American Datum of 1983
Date: December 17, 2009
Prepared By: GSI Water Solutions, Inc.

Data Sources

Deschutes County GIS, Oregon Geospatial Data Clearinghouse

Disclaimer

This map was prepared for the purpose of identifying the location of a water right only and it is not intended to provide legal dimensions or location of property ownership lines.

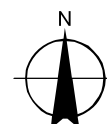

Scale
0 200 400
1 inch equals 400 feet




Application for a Permit to Use Groundwater

In the Name of: Taylor Northwest

Deschutes County, Oregon

Section 22, Township 17 South, Range 11 East (W.M.)

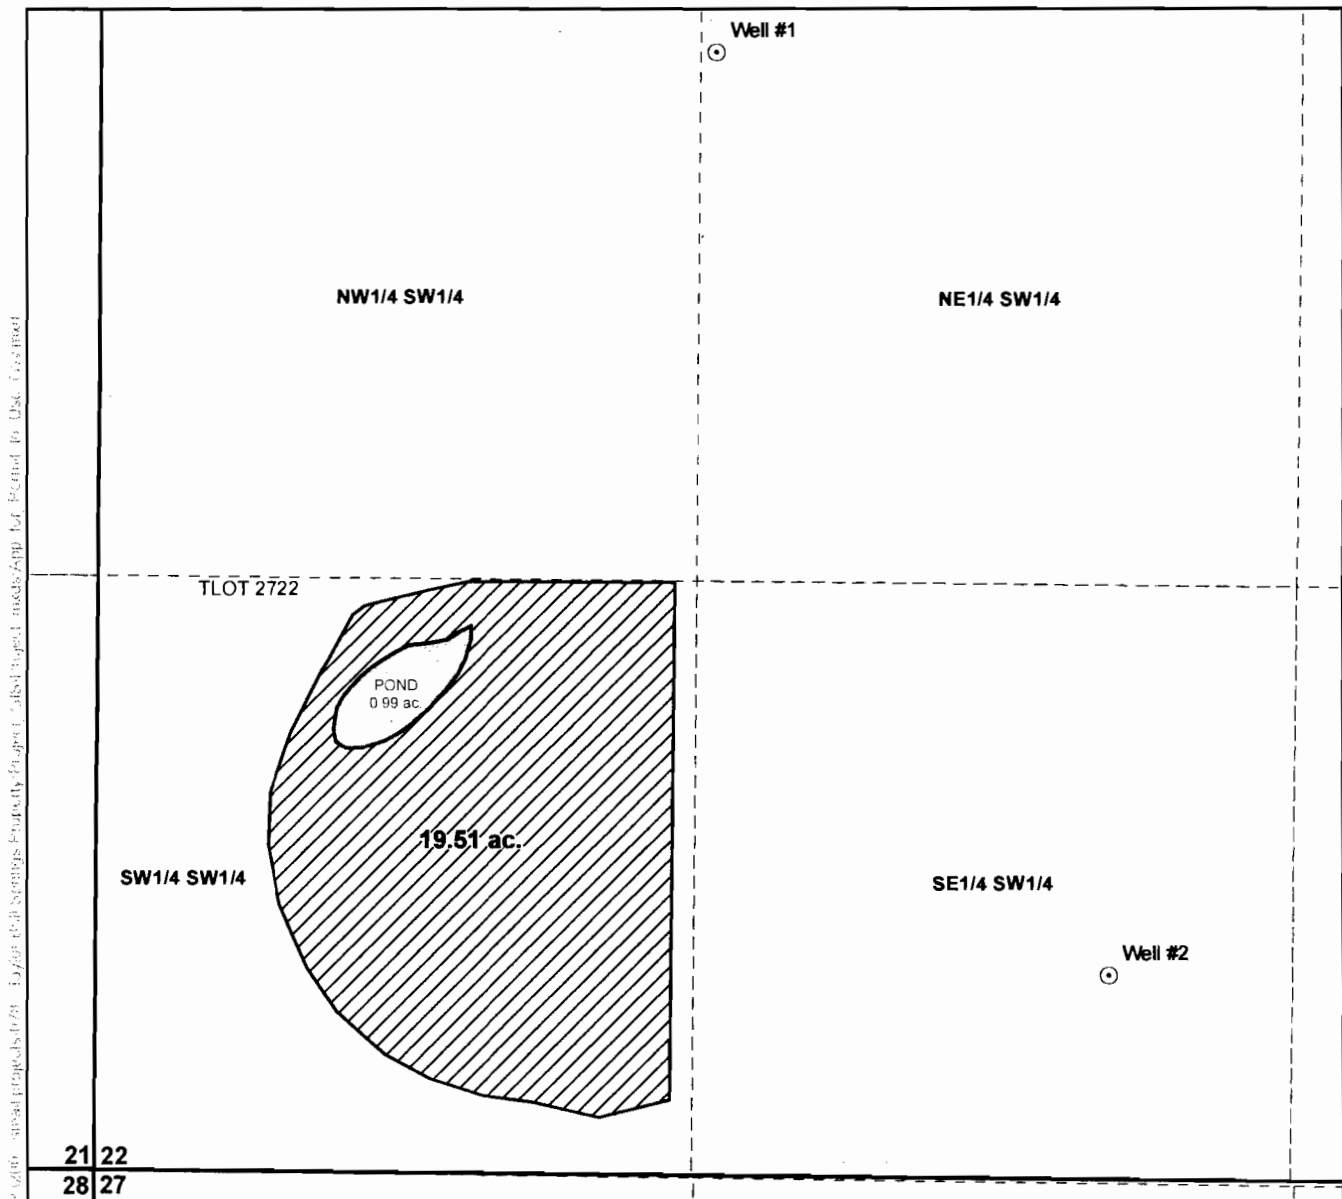

Legend

○ Proposed Point of Appropriation (POA)

▨ Proposed Place of Use (POU)

Pond

Tax Lots

POA Location Descriptions

Well #1

Located 2,480 feet North and 1,365 feet East from the SW corner of Section 22, Township 17 South, Range 11 East (W.M.)

Well #2

Located 445 feet North and 2,240 feet East from the SW corner of Section 22, Township 17 South, Range 11 East (W.M.)

Map Information

Projection: Oregon State Plane South Zone

Datum: North American Datum of 1983

Date: August 1, 2008

Prepared By: GSI Water Solutions, Inc.

Data Sources

Deschutes County GIS, Oregon Geospatial Data Clearinghouse

Disclaimer

This map was prepared for the purpose of identifying the location of a water right only and it is not intended to provide legal dimensions or location of property ownership lines.



AUG 14 2008
WATER RESOURCES DEPT.
SALEM, OREGON

