

Mainwaring Property
385 2W 31 200

RESERVOIR LOCATED
CENTER SECTION 31
1750 ft SOUTH
830 ft WEST

Section
31

Water storage
Reservoir

Lot 200

SE 1/4 SW 1/4

8-15-08
Jim

INFORMATION TEC

Map Ma
Applica

Front Counter /
Highlighted

Highlighted

Tax Lot On
City Limits

Ashland

Burke Falls

Central Pt

Eagle Point

Gold Hill

Jacksonville

Medford

Phoenix

Rogue River

Shady Cove

Talent

RECEIVED

AUG 14

WATER RESOURCES
SALEM, ORE



BISHOP CREEK


JACKSON COUNTY

INFORMATION TECHNOLOGY

38-2-19

Mainwaring Property
38S 2W 31 200


38-3-30
38-3-36 1

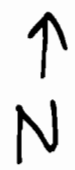

Scale
1" = 1000'

Section
31

WOODRAT MTN

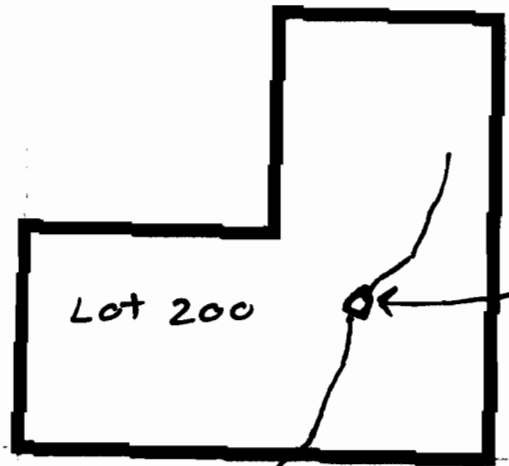

Water storage
Reservoir

SPENCER GULCH

RECEIVED

AUG 14 2008

WATER RESOURCES DEPT.
SALEM, OREGON



JACKSON
COUNTY
Oregon

This map is based on a digital database compiled by Jackson County From a variety of sources. Jackson County cannot accept responsibility for errors, omissions, or positional accuracy. There are no warranties, expressed or implied.

