


THIS MAP WAS PREPARED FOR ASSESSMENT PURPOSE ONLY

SECTION 8 28S. R.13W. W.M. COOS COUNTY

28 13 & INDEX

CANCELLED

1" = 400'

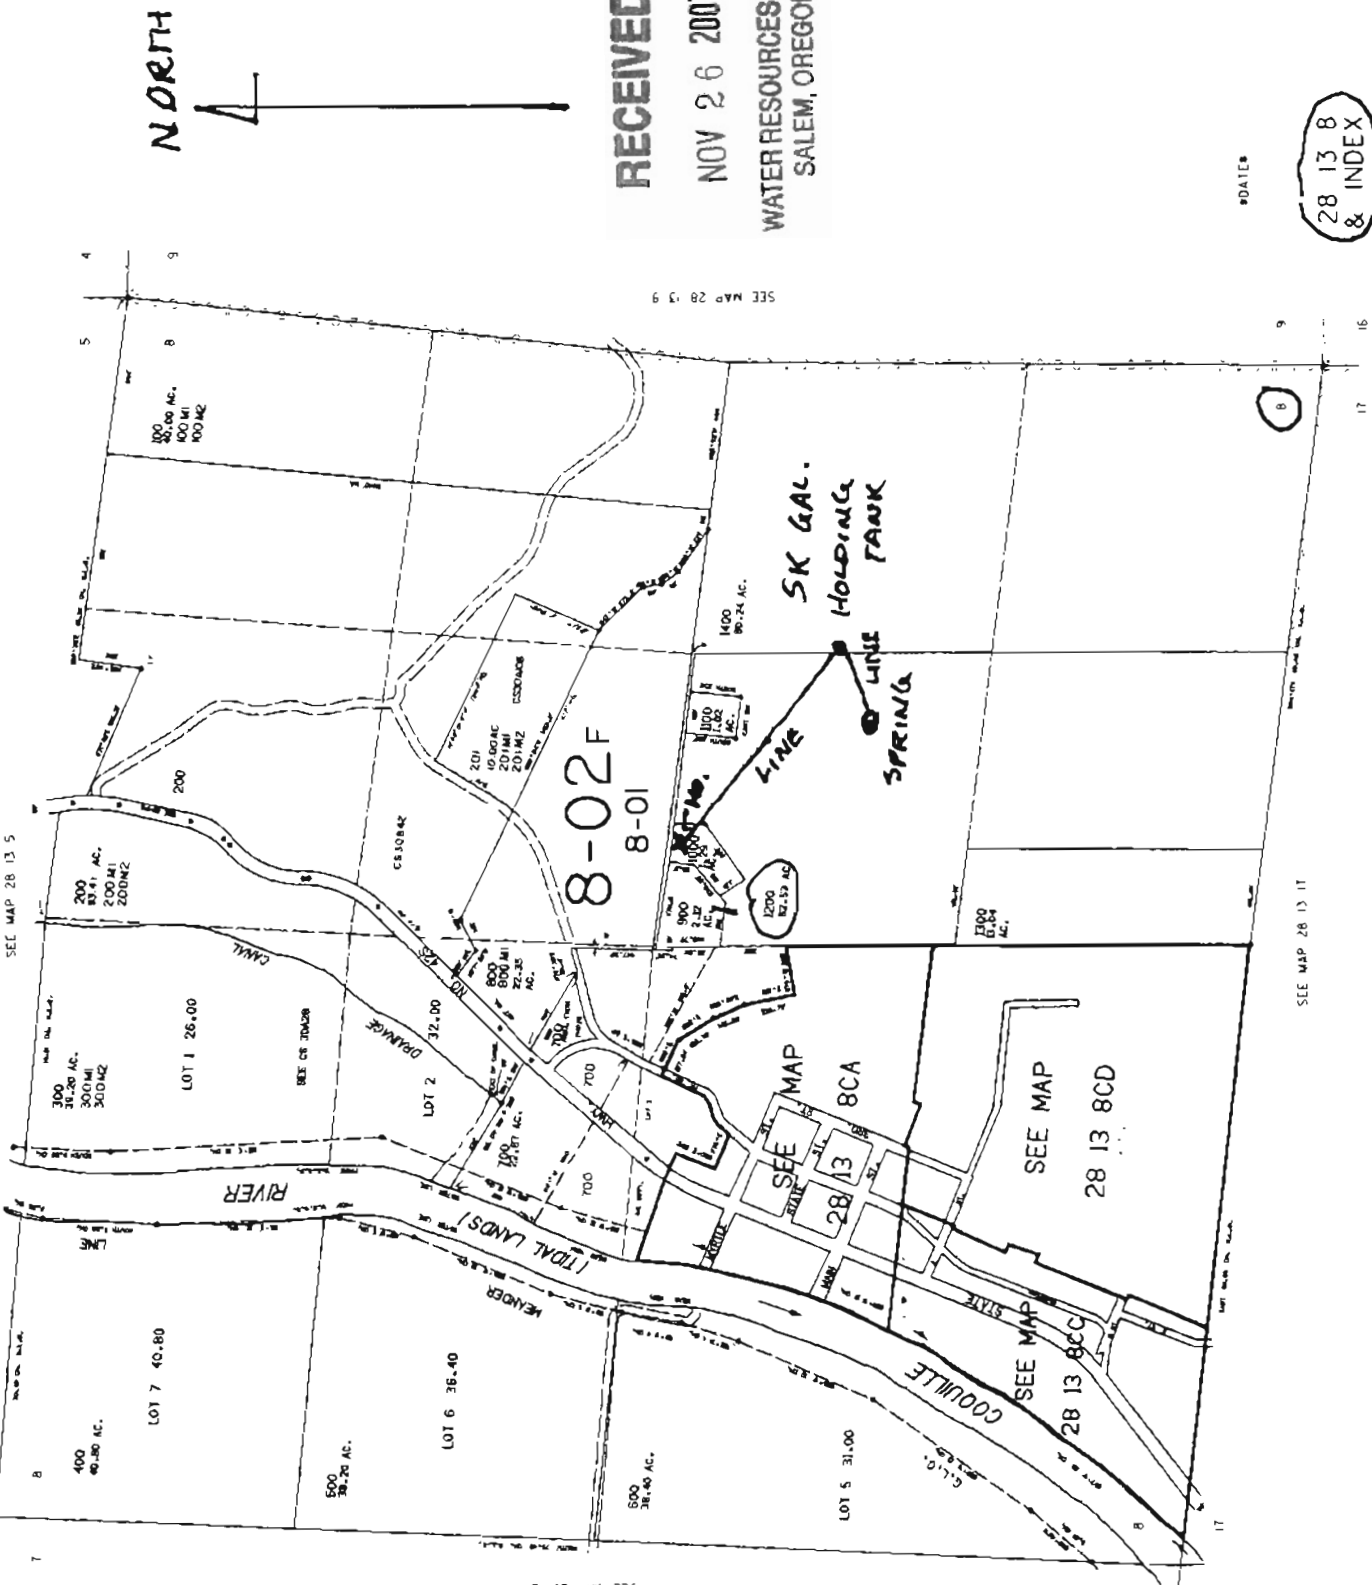

T. 28S. R. 13W.
 SEC. 8
 NW SE
 SCALE 1" = 400'

SPRING -
 P.O.D. TL 1200
 LOCATED
 600' EAST Y 575'
 SOUTH OF CENTER
 OF SEC. 8

1000
 1000
 P.O.U. TL. 900
 HOUSE-LOCATED
 550' E. AND 50'
 S. OF CENTER OF
 SEC. 8

RECEIVED
 NOV 26 2007
 WATER RESOURCES DEPT
 SALEM, OREGON

#DATE#

28 13 8 & INDEX

APPNO S-87045