


SPRING LOCATED FROM SE CORNER
SECTION 24
100 FE WEST
10 FE NORTH

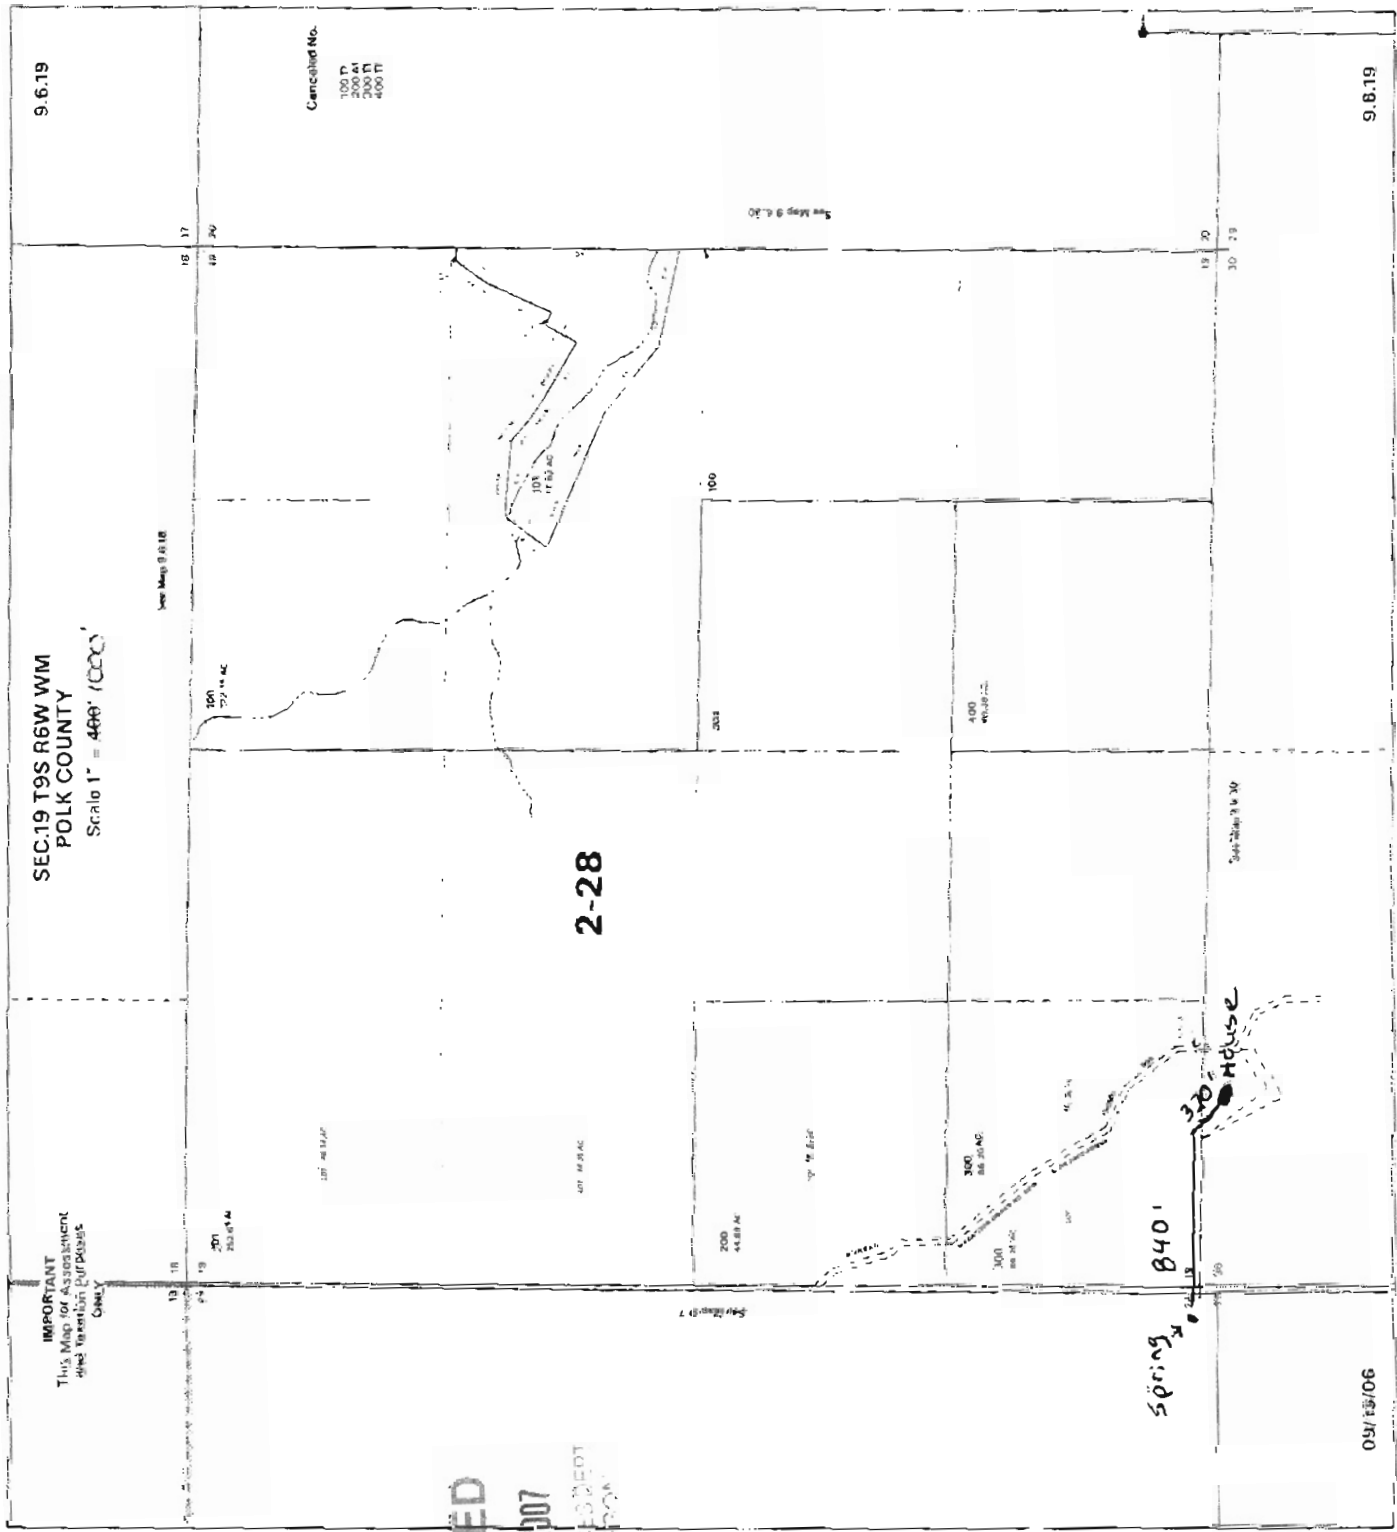

IMPORTANT
This Map for Assessment
and taxation purposes
ONLY

Cancelled No.
100
200
300
400

RECEIVED

NOV 09 2007

WATER RESOURCES DEPT

Unnamed Spring
For:
Marcia J. McBeth
11545 Burbank Rd
TAX Lot 200

05/13/06

APP NO S-87052