

BOOK 20

RECEIVED

AUG 18 2008 -


SECTION 29 T.39S. R.8W. W.M.

JOSEPHINE COUNTY

WATER RESOURCES DEPT
SALEM, OREGON

$$1'' = 400'$$

SEE MAP 39 8 20

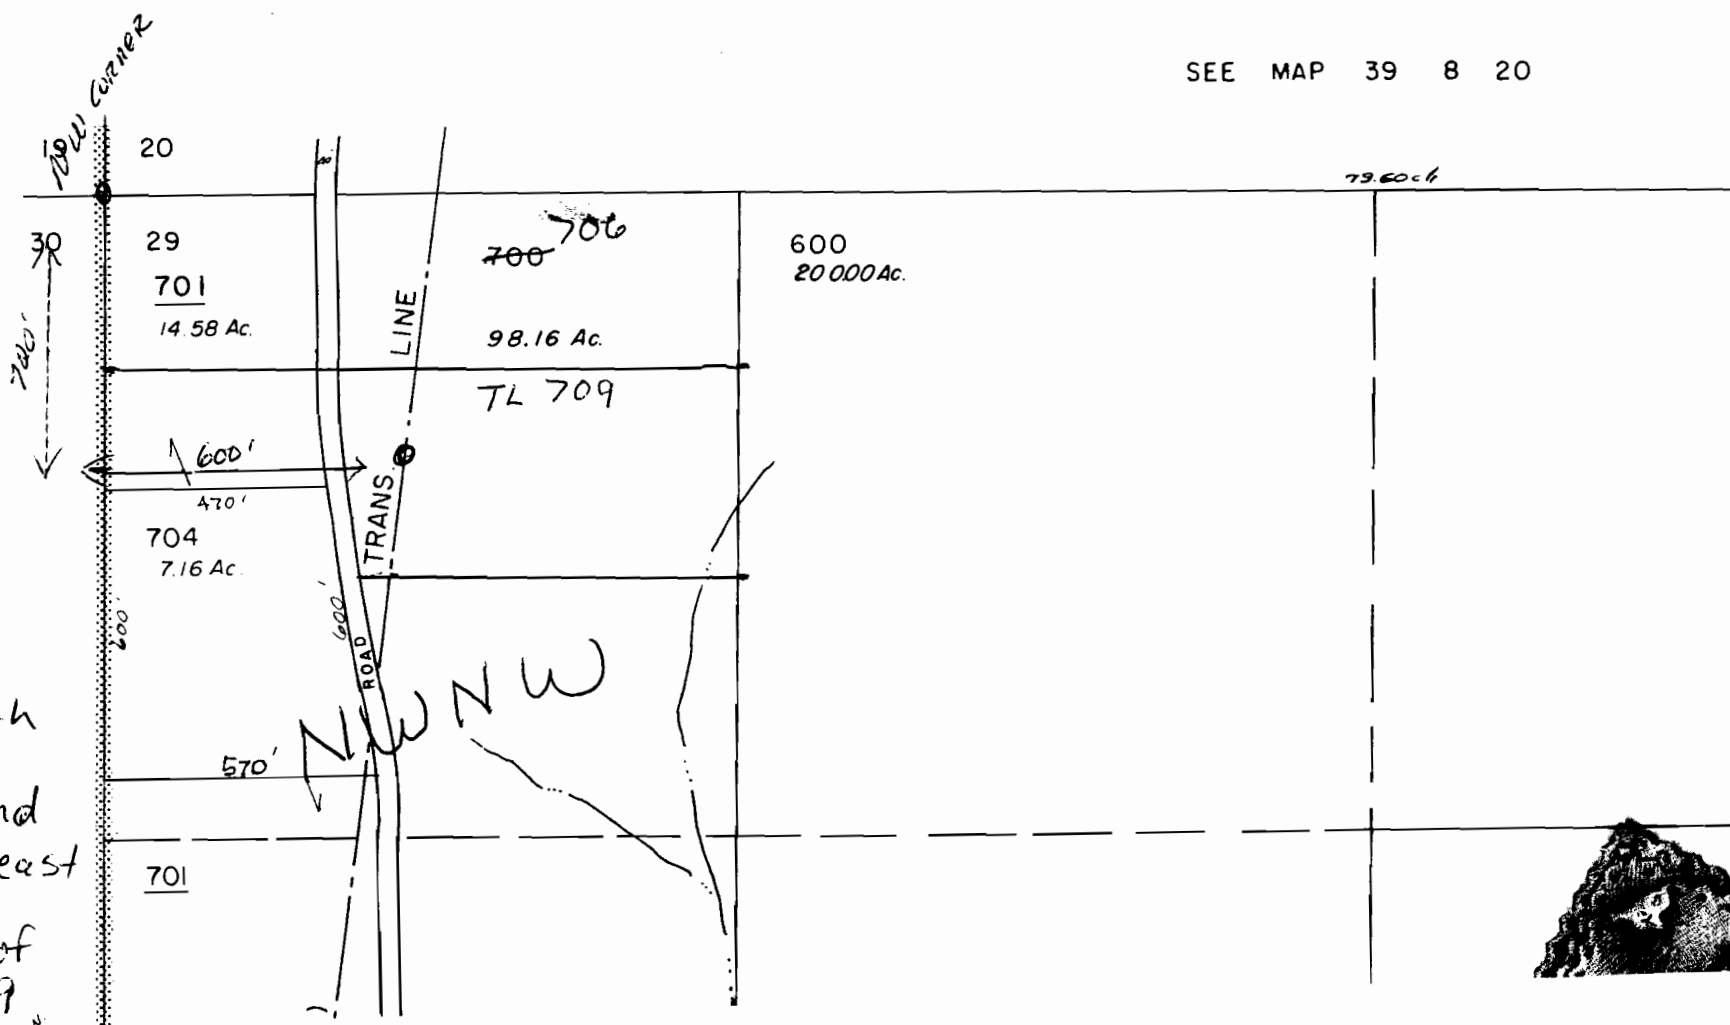

Pond is
720' South
of NW
corner and
600 ft east
of NW
corner of
Sec 29.