NE1/4 SEC.10 T.26S. R.3W. W.M.
DOUGLAS COUNTY
**Scale: 1"=500'**

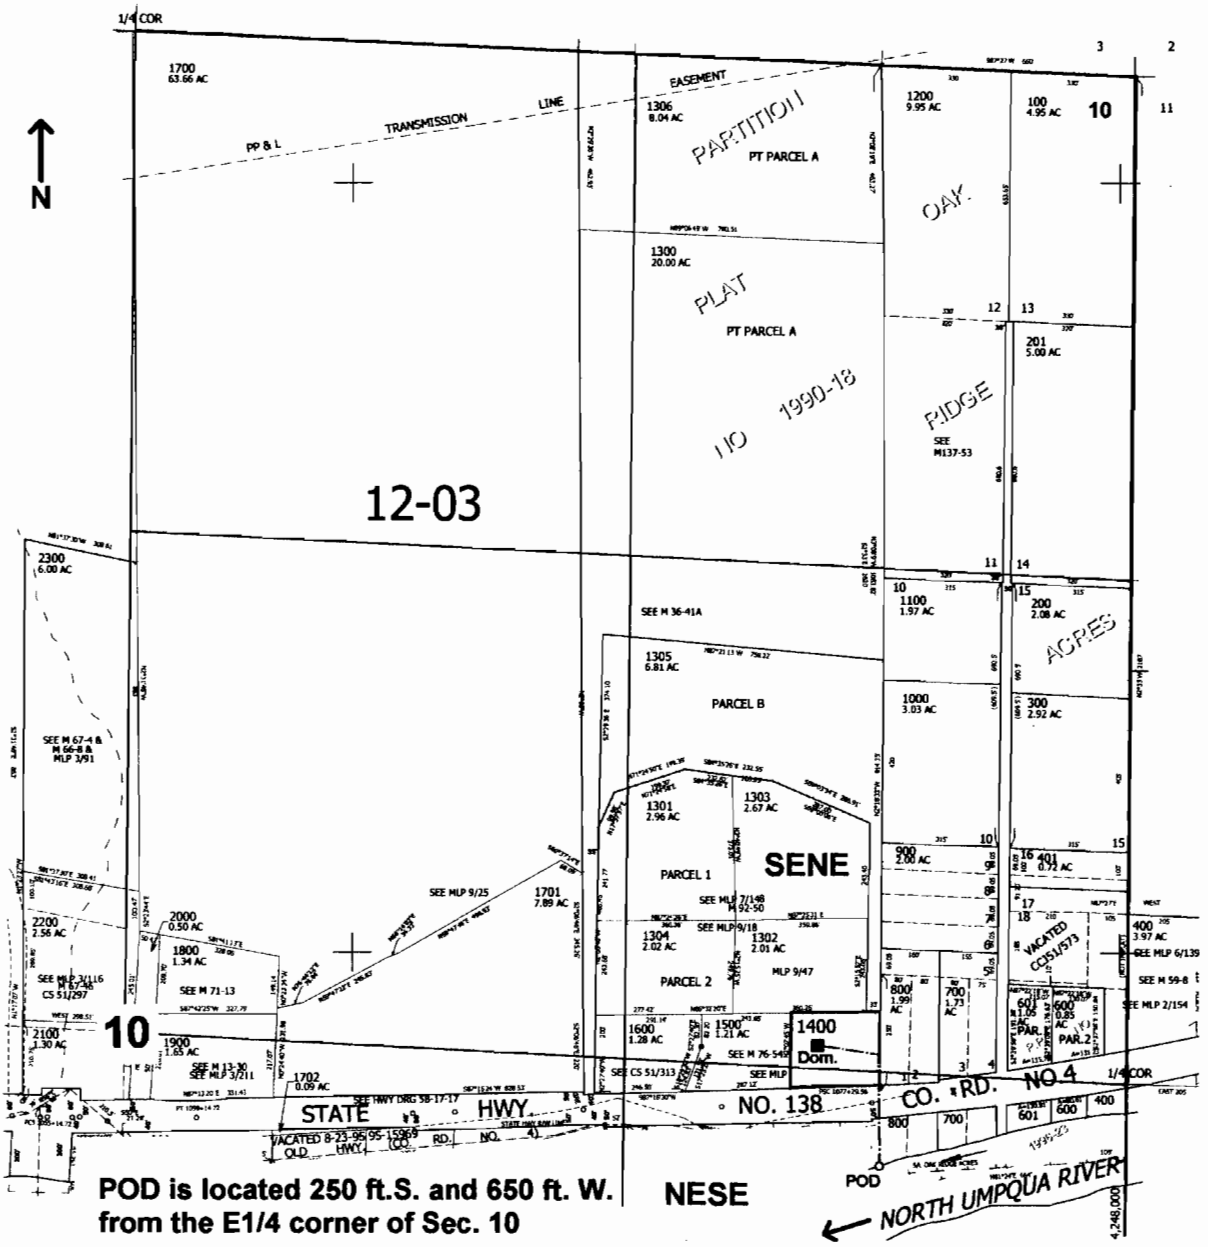


**POD is located 250 ft.S. and 650 ft. W. from the E1/4 corner of Sec. 10**

RECEIVED
AUG 13 2008
WATER RESOURCES DEPT.
SALEM, OREGON