



T.06S. R.23E. W.M. GILLIAM COUNTY

1" = 2000'


CORRECTED APPROX
ADJUSTED SCALE
1" = 1000 FEET

RECEIVED

AUG 20 2008

WATER RESOURCES DEPT
SALEM, OREGON

SEE MAP 05S 23E

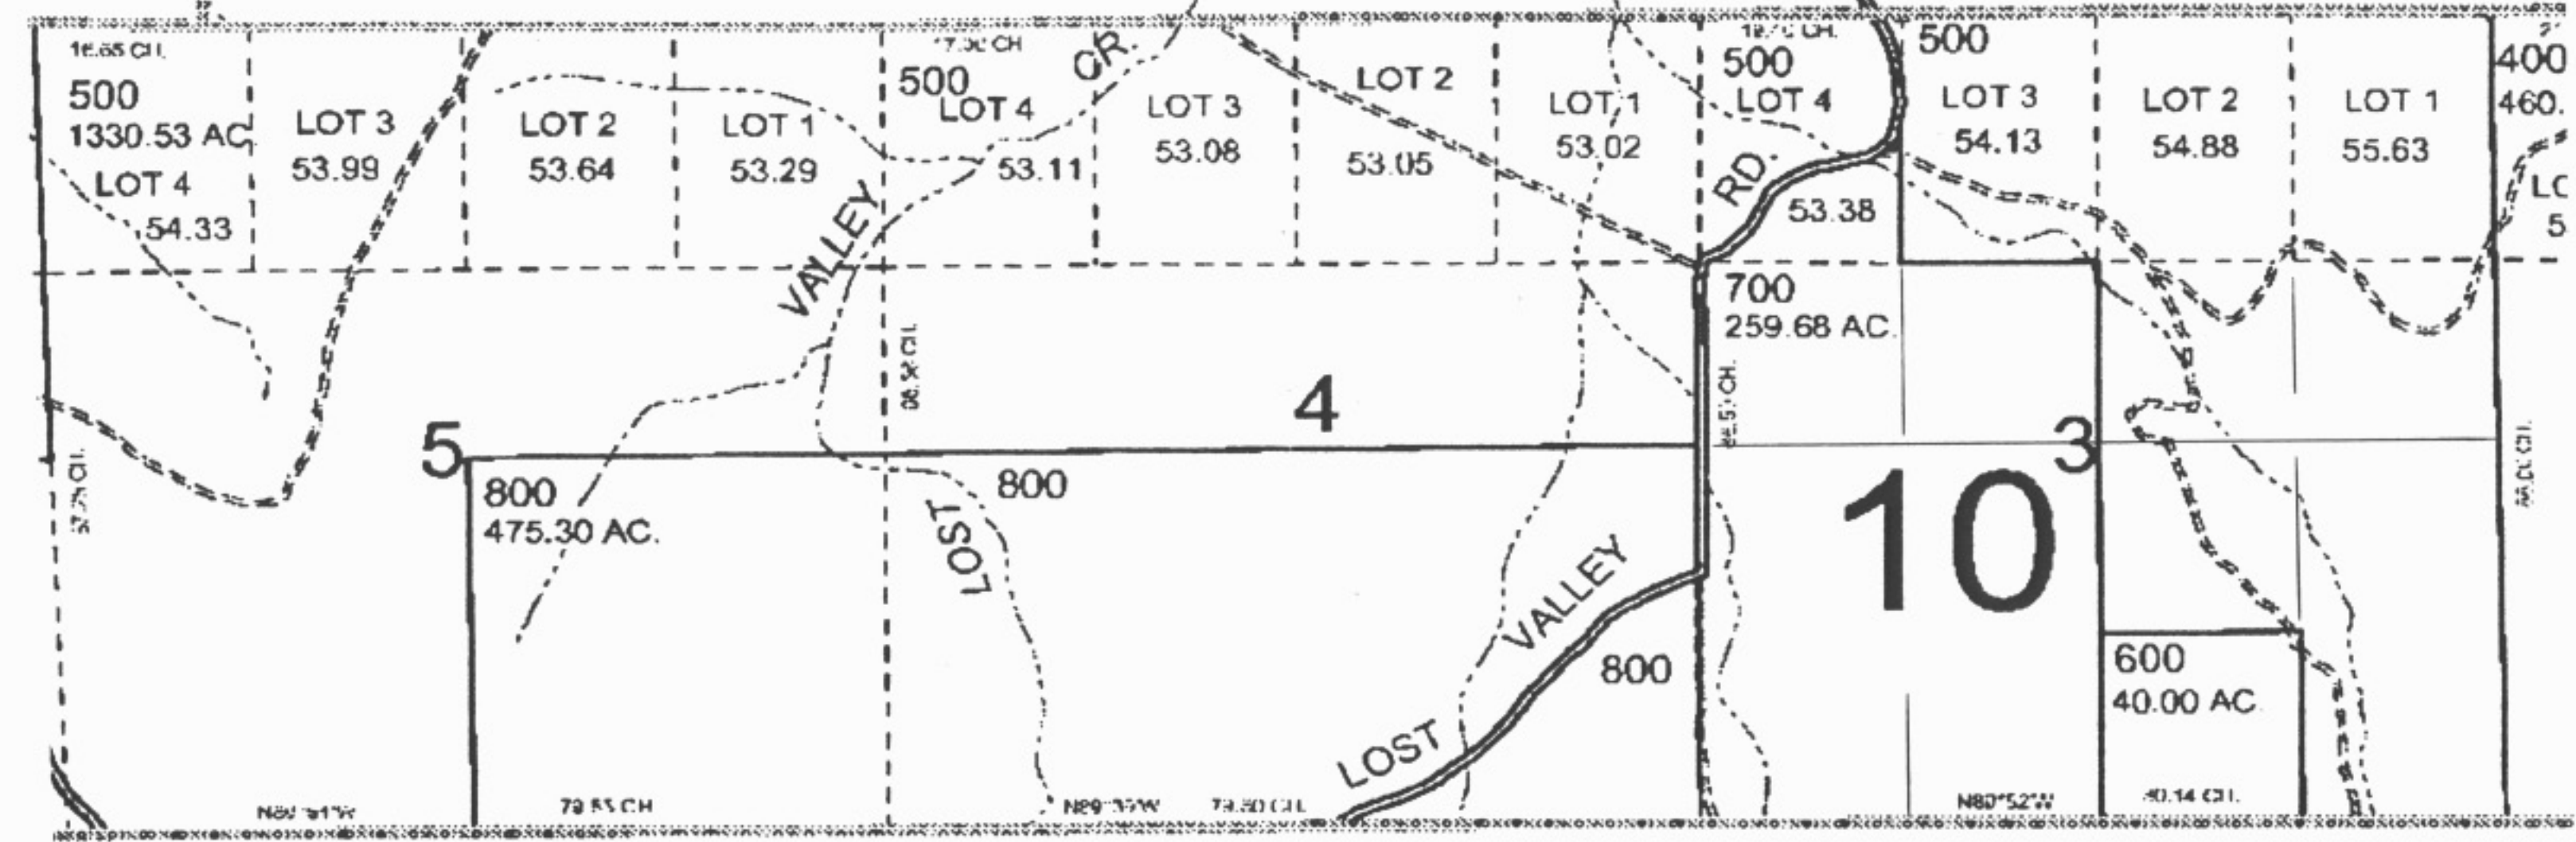


Hanna - Reservoir

T 6S R 23E Section 3 Tax Lot 700

RECEIVED

JUL 01 2008

WATER RESOURCES DEPT.
SALEM, OREGON

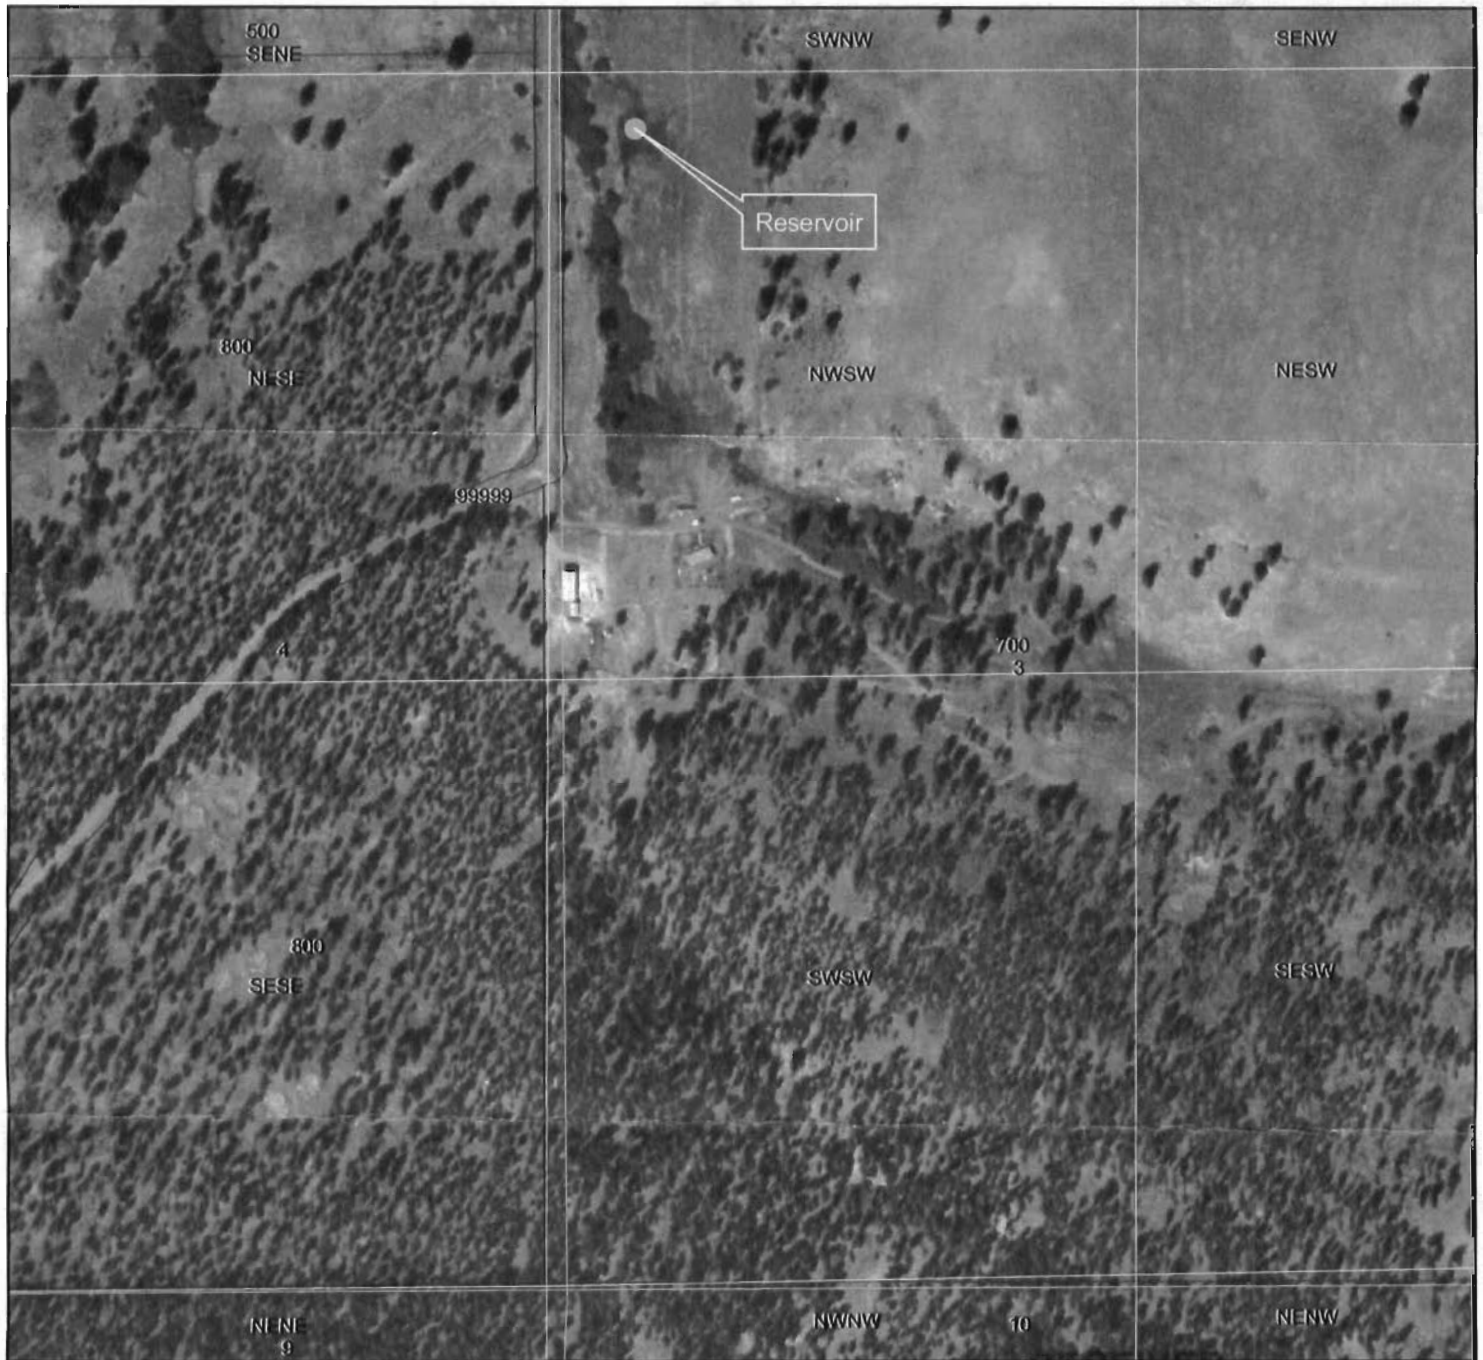

RECEIVED

AUG 20 2008

WATER RESOURCES DEPT.
SALEM, OREGON



1 inch equals 400 feet

Center of Reservoir: 2,530 feet North and 170 feet East of the SW corner of section 3

This product is for informational purposes and may not have been prepared for, or be suitable for legal, engineering, or surveying purposes. Users of this information should review or consult the primary data and information sources to ascertain the usability of the information.

1