

1900
1350.00 AC.

CORRECTED ADJUSTED
APPROX SCALE
1" = 600 FEET

889'67"W

80.18 CH. = 5280.56'

S89°55'W

79.52 CH. = 5248.32'

EASEMENT

TO

1530'

S15°E

S35°E

1140'

S15°E
306'

26

25

2050'

PARCEL

2000'

NE/SW
HORRIDGE


2000'

2050'

160.00 AC.

N89°53'W

S89°59'W

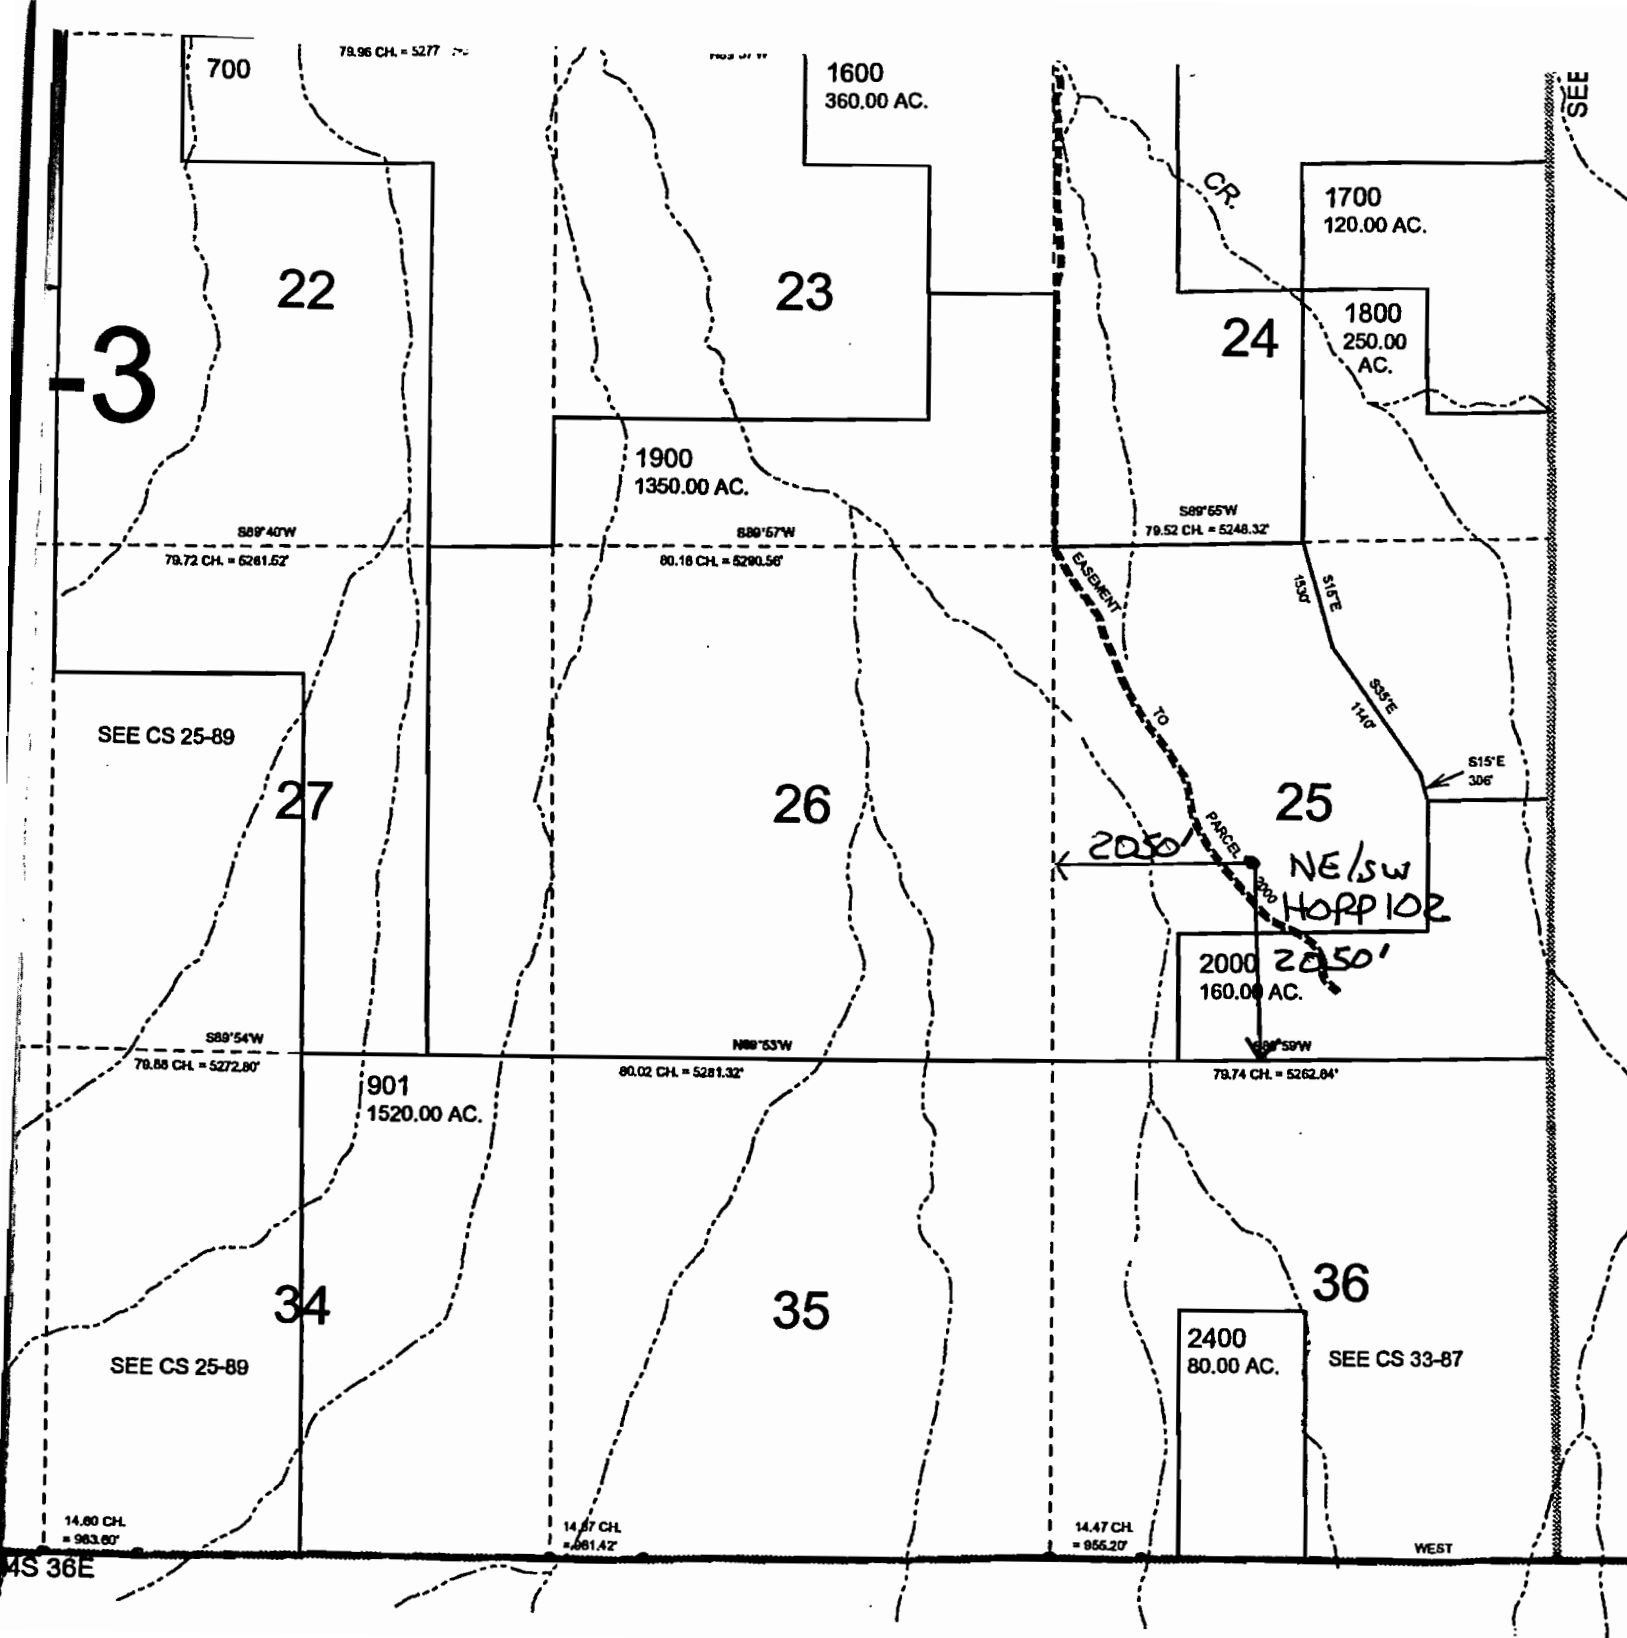

RECEIVED

AUG 18 2008
WATER RESOURCES DEPT.
SALEM, OREGON

Revised 9C
1/11/2007

03S 36E