


Section 7 Township 24-S Range 30-E
County of Harney State of Or


NORTH

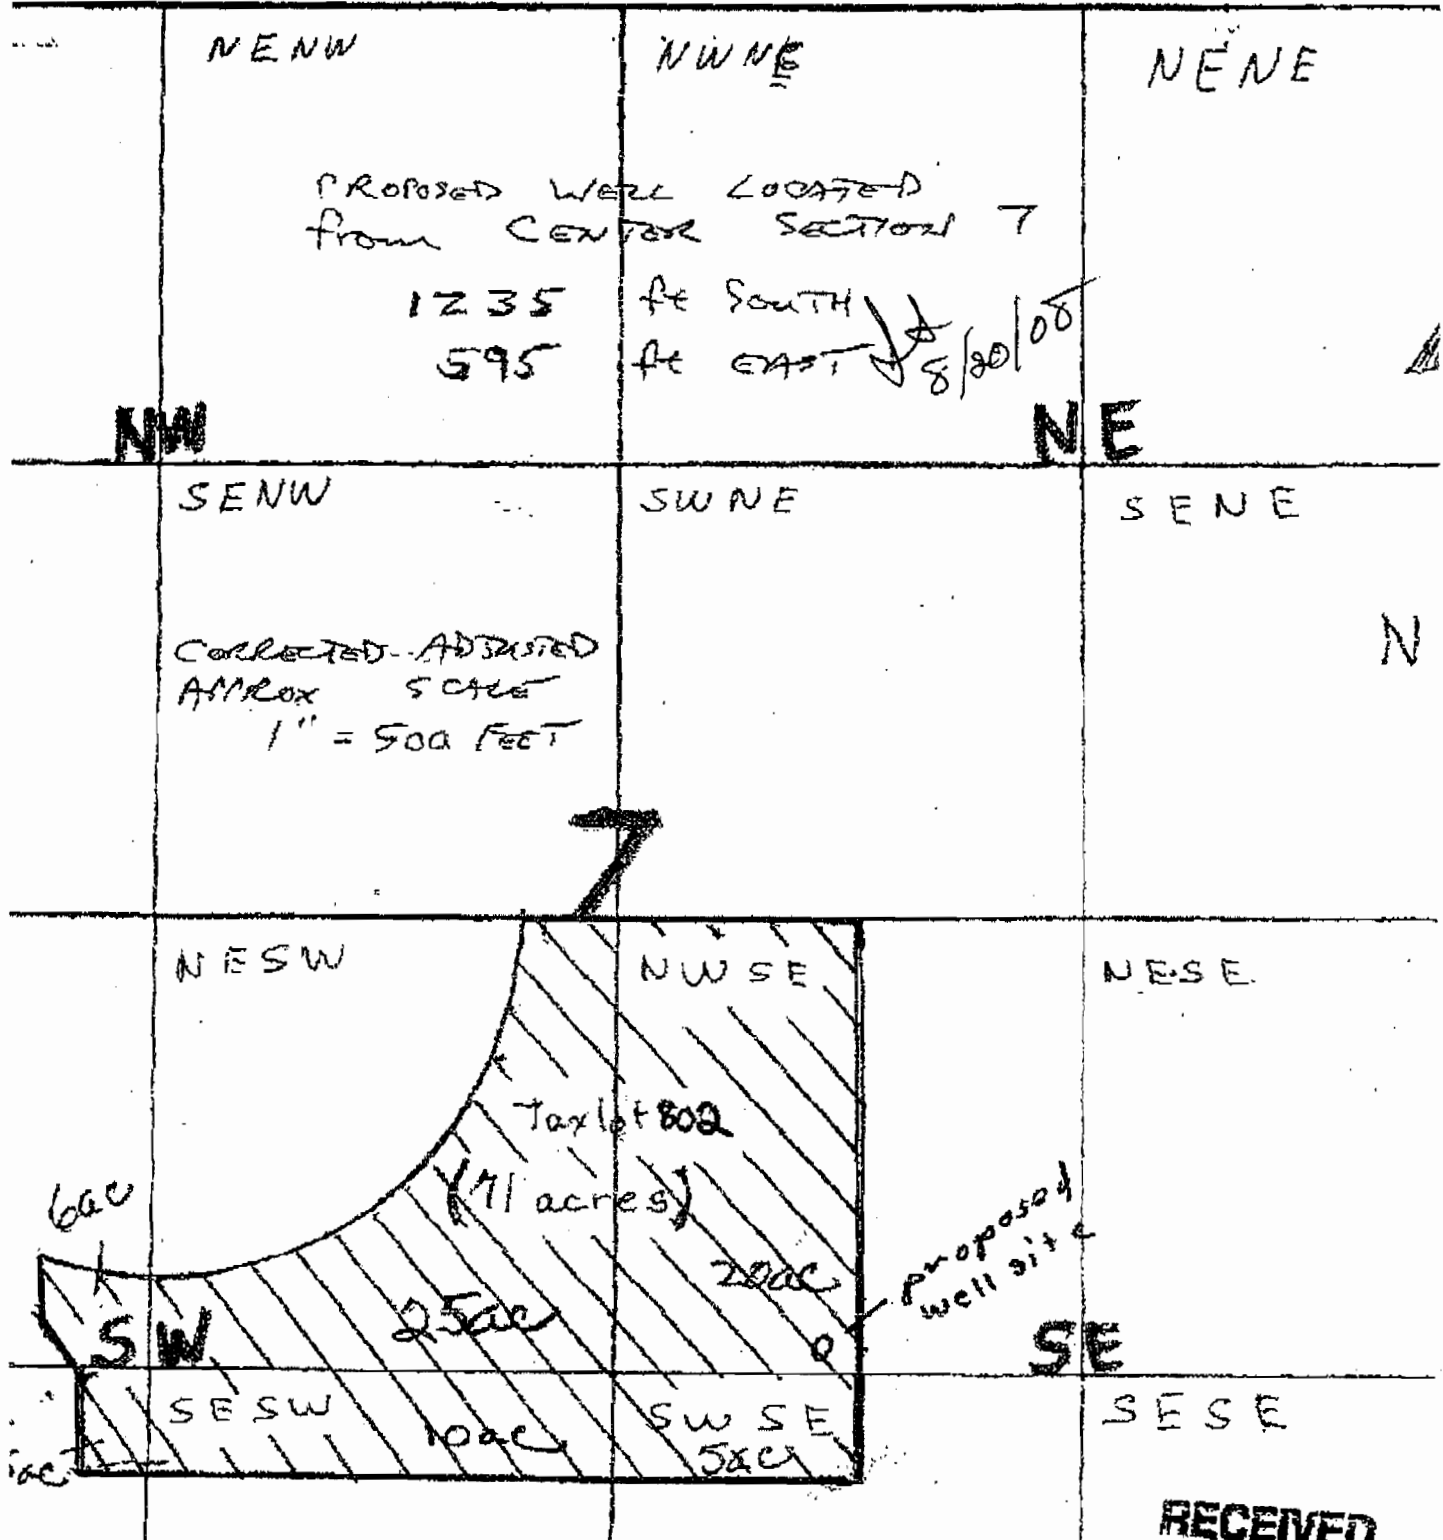

SECTION PLAT

Section 7 Township 24-S Range 30-E
 County of Harney State of Or

NORTH

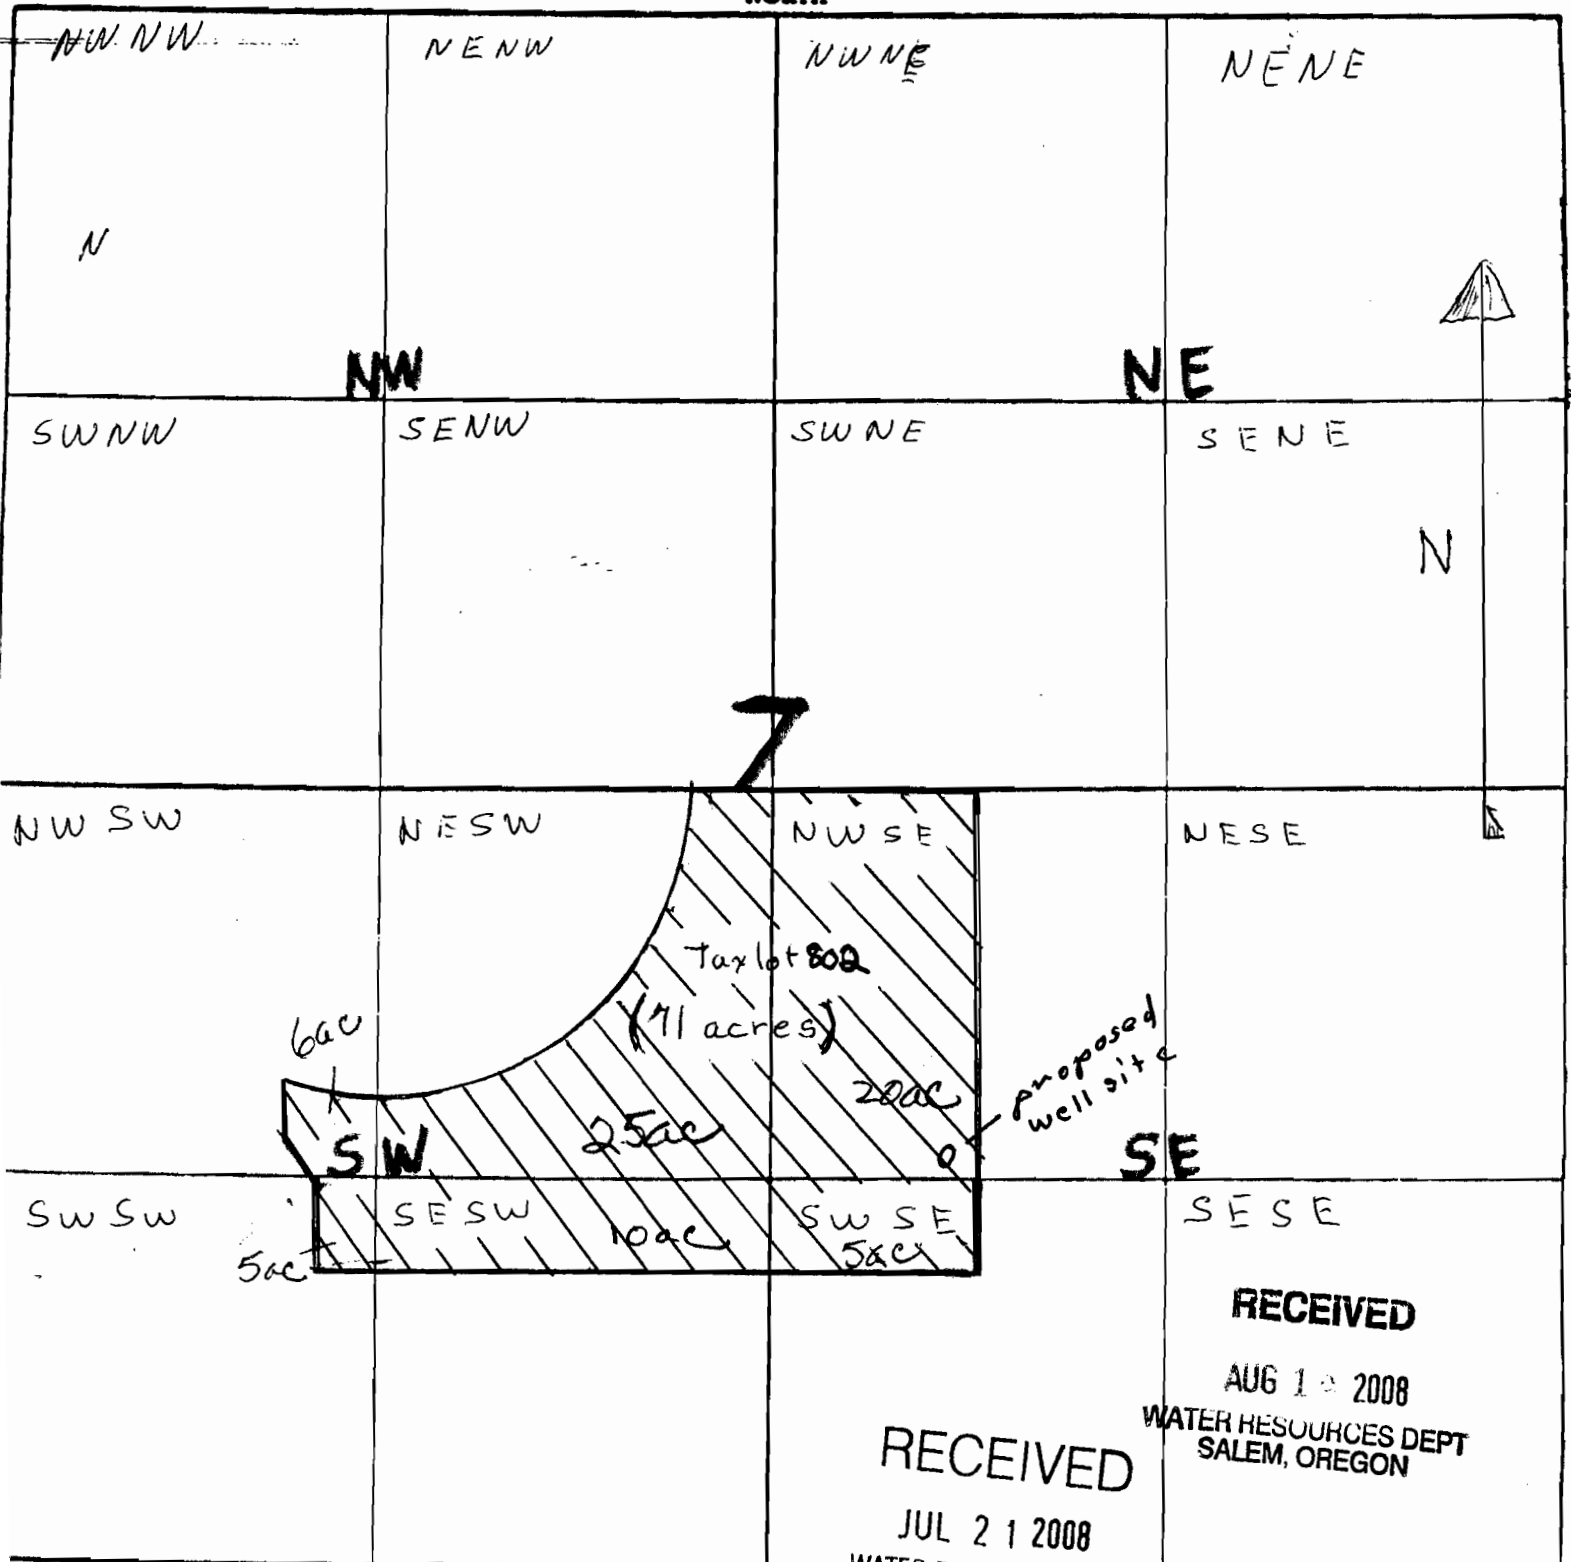

RECEIVED

AUG 1 2008

WATER RESOURCES DEPT
 SALEM, OREGON

RECEIVED



JUL 21 2008

WATER RESOURCES DEPT.
 SALEM, OREGON

scale 8" = 1 mile

James C. & Elia A. Shepherd
 476 N Koa
 Burns, Ore. 97720

24S 30E DETAIL

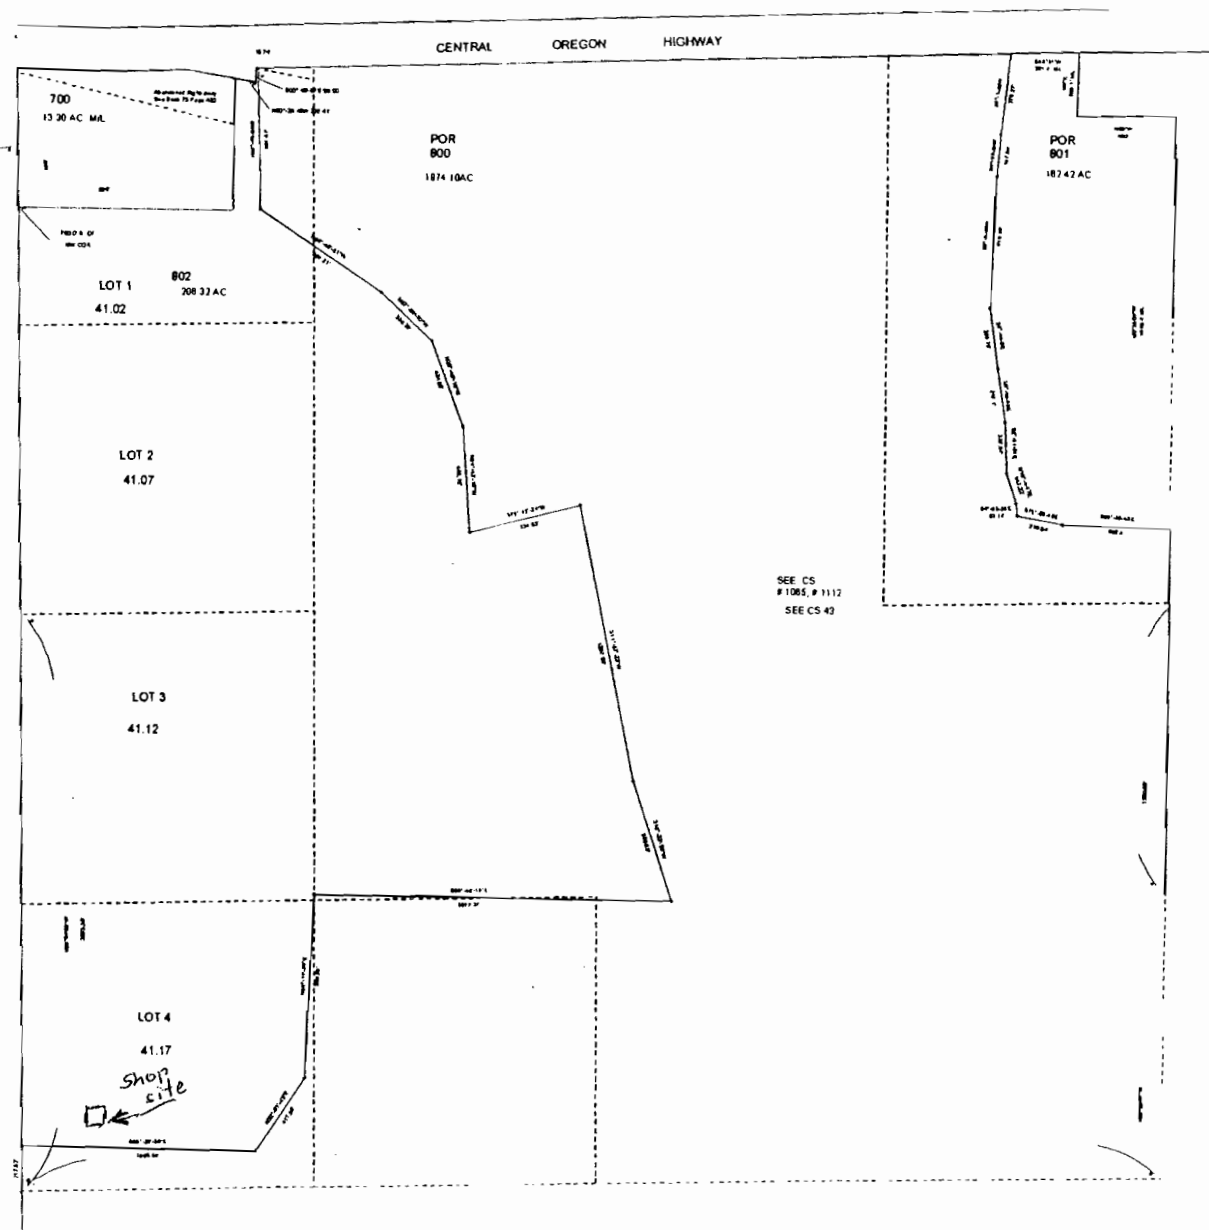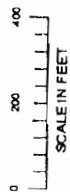

RECEIVED
AUG 19 2008
WATER RESOURCES DEPT
SALEM, OREGON