


Kemmer T 7S R 23E Section 36 Tax Lot 2700

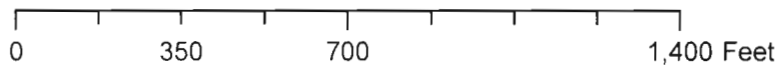

1 inch equals 405.451525 feet

■ = Reservoir 1: SWSE of Section 36 T7S R223E WM; Center of Reservoir- 145 feet North and 1450 feet West from the SE corner of Section 36

This product is for informational purposes and may not have been prepared for, or be suitable for legal, engineering, or surveying purposes. Users of this information should review or consult the primary data and information sources to ascertain the usability of the information.



RECEIVED

AUG 28 2008

**WATER RESOURCES DEPT
SALEM, OREGON**