



THIS MAP WAS PREPARED FOR
ASSESSMENT PURPOSE ONLY

SECTION 3 T.8S. R.46E. W.M.
BAKER COUNTY
1" = 400'

8 46 3

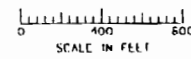

LOCATION MAP

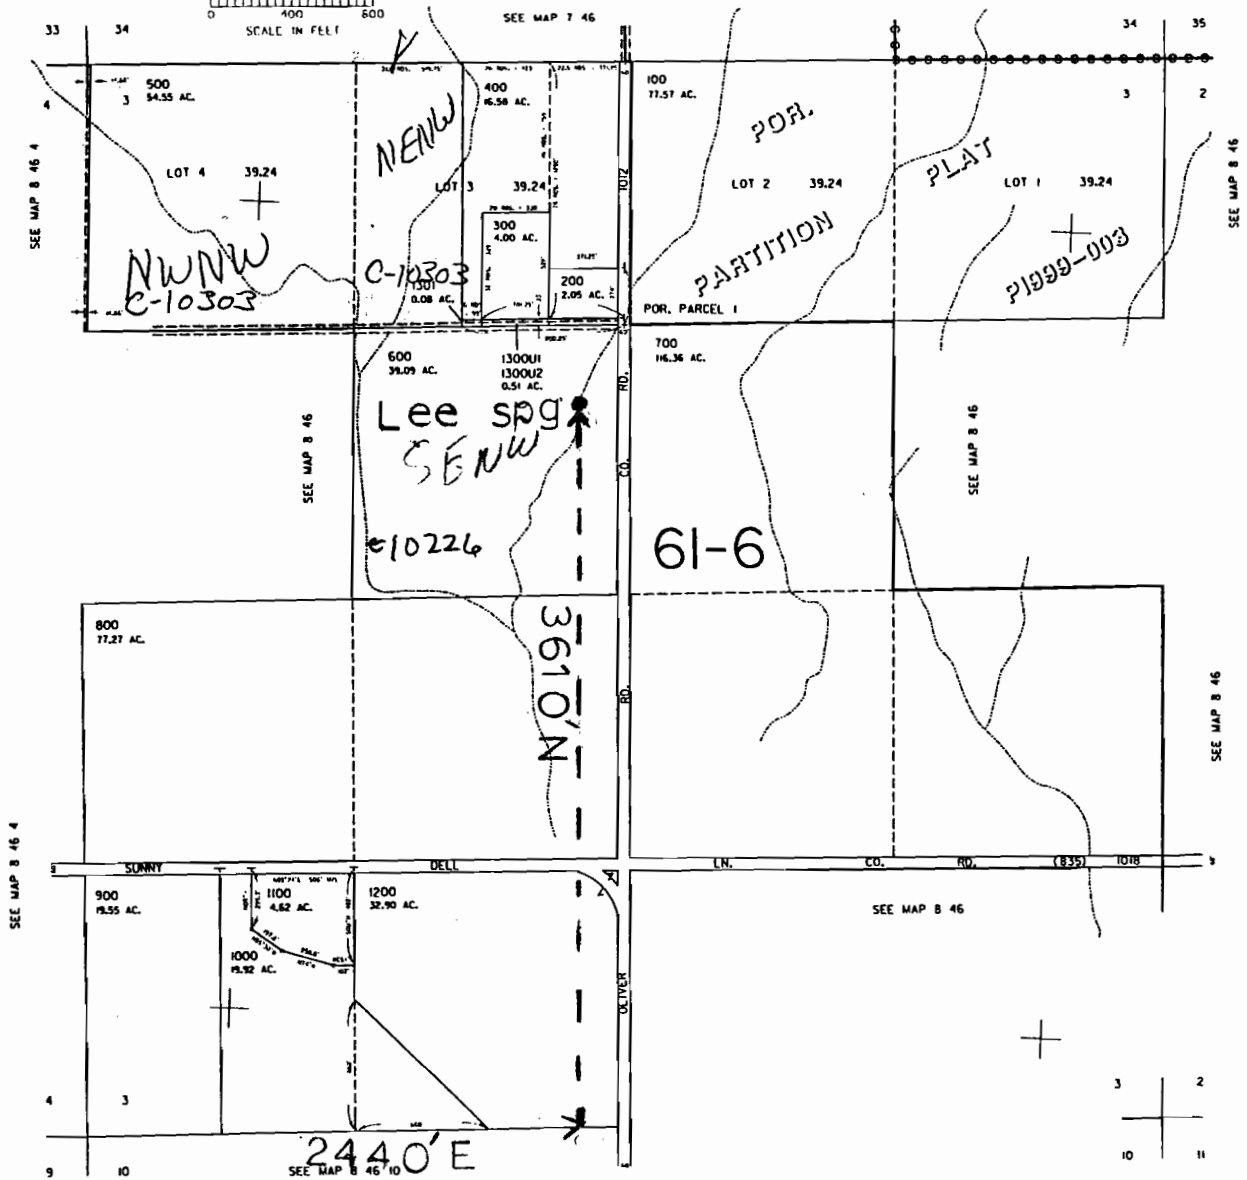

466,000

Revised
8/17/01, CS

8 46 3

RECEIVED


SEP 08 2008

WATER RESOURCES DEPT
SALEM, OREGON

41532
RECEIVED
FEB 25 1977
WATER RESOURCES
SALEM, OREGON

TOWNSHIP.....8.....S.

RANGE.....46.....E.W.M.

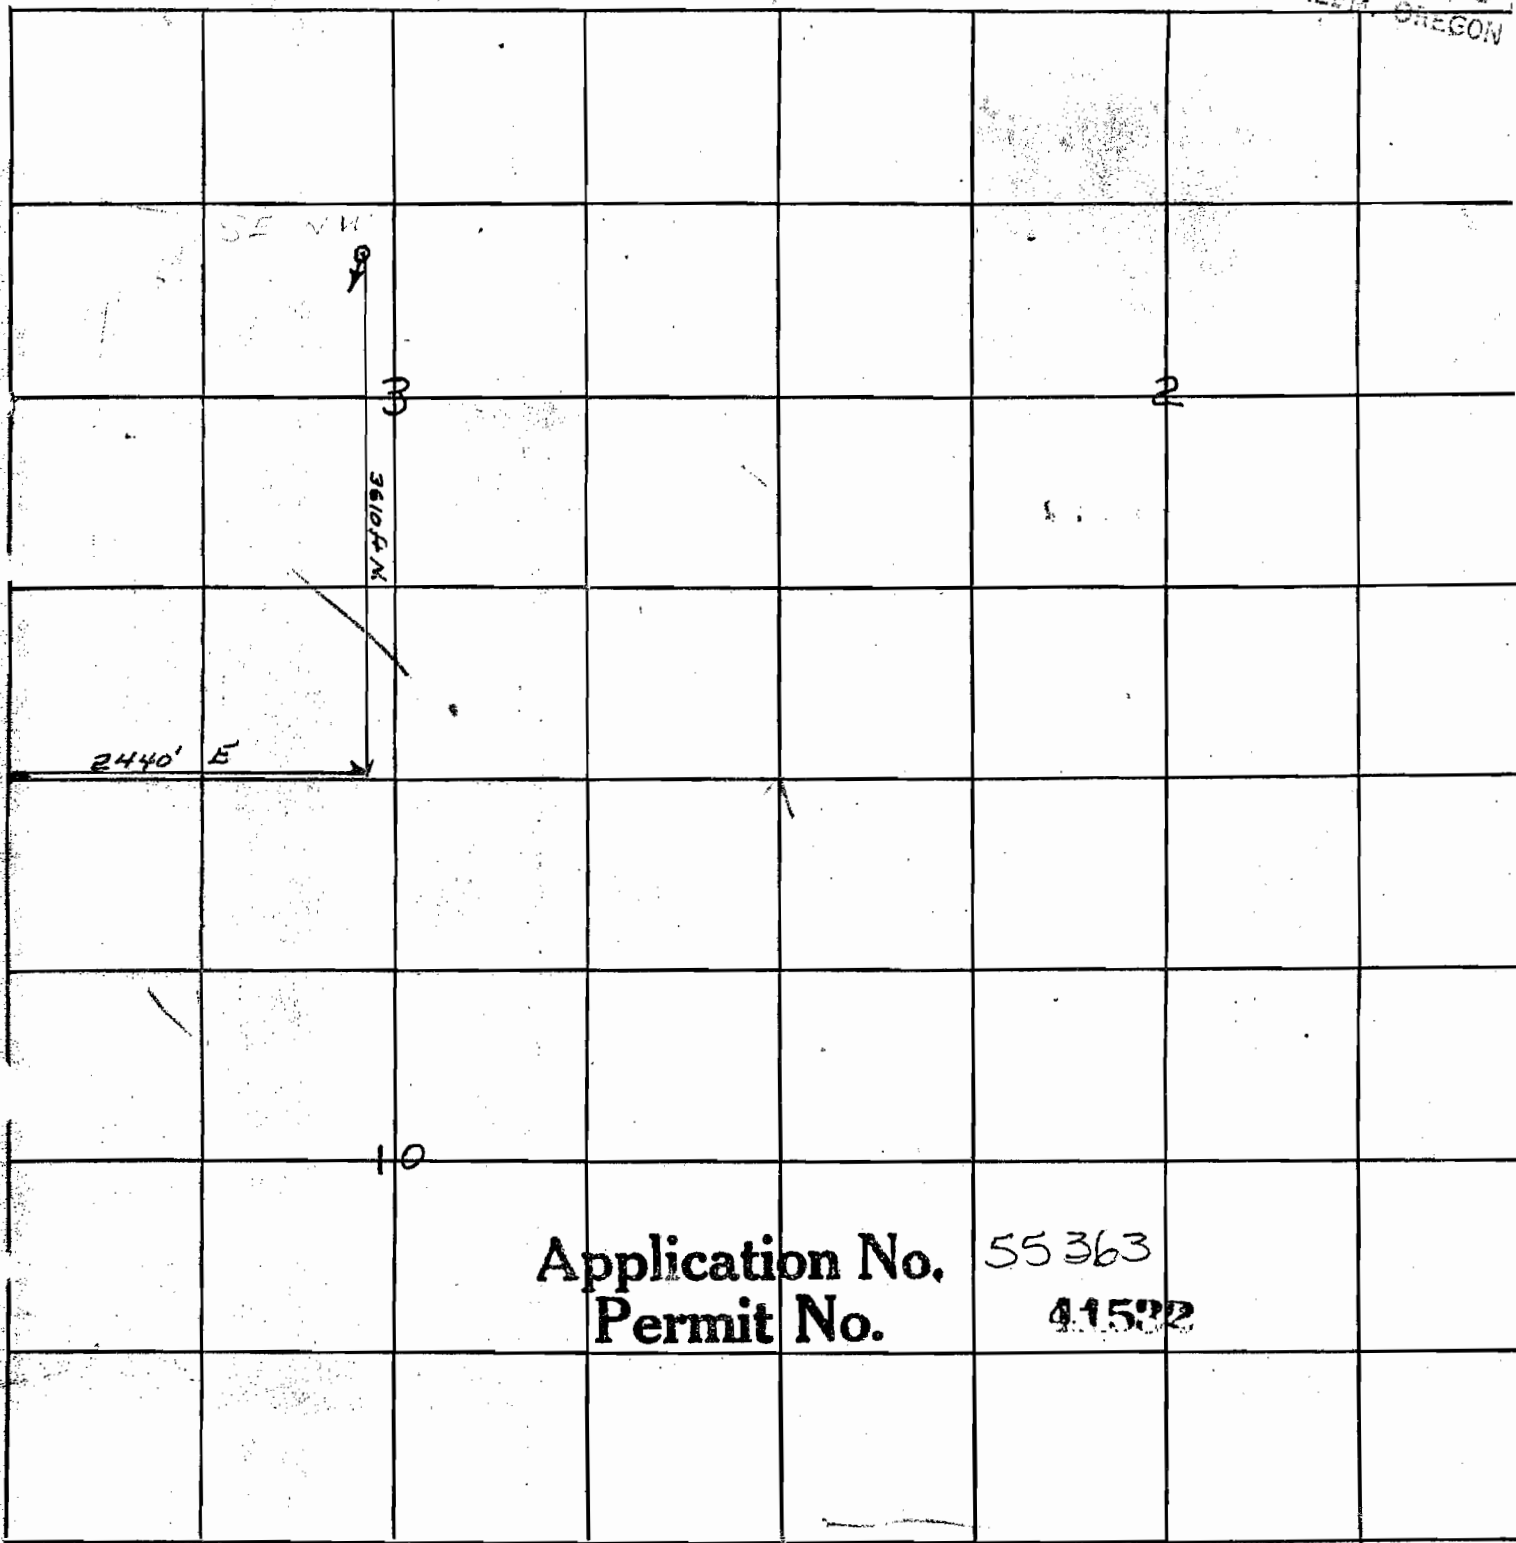

MAP TO ACCOMPANY APPLICATION OF:

Name.....HENRY.....


LOCATION MAP

SEP 08 2008

**WATER RESOURCES DEPT
SALEM, OREGON**

SECTION 3 T.8S. R.46E. W.M.
BAKER COUNTY

8 46 5

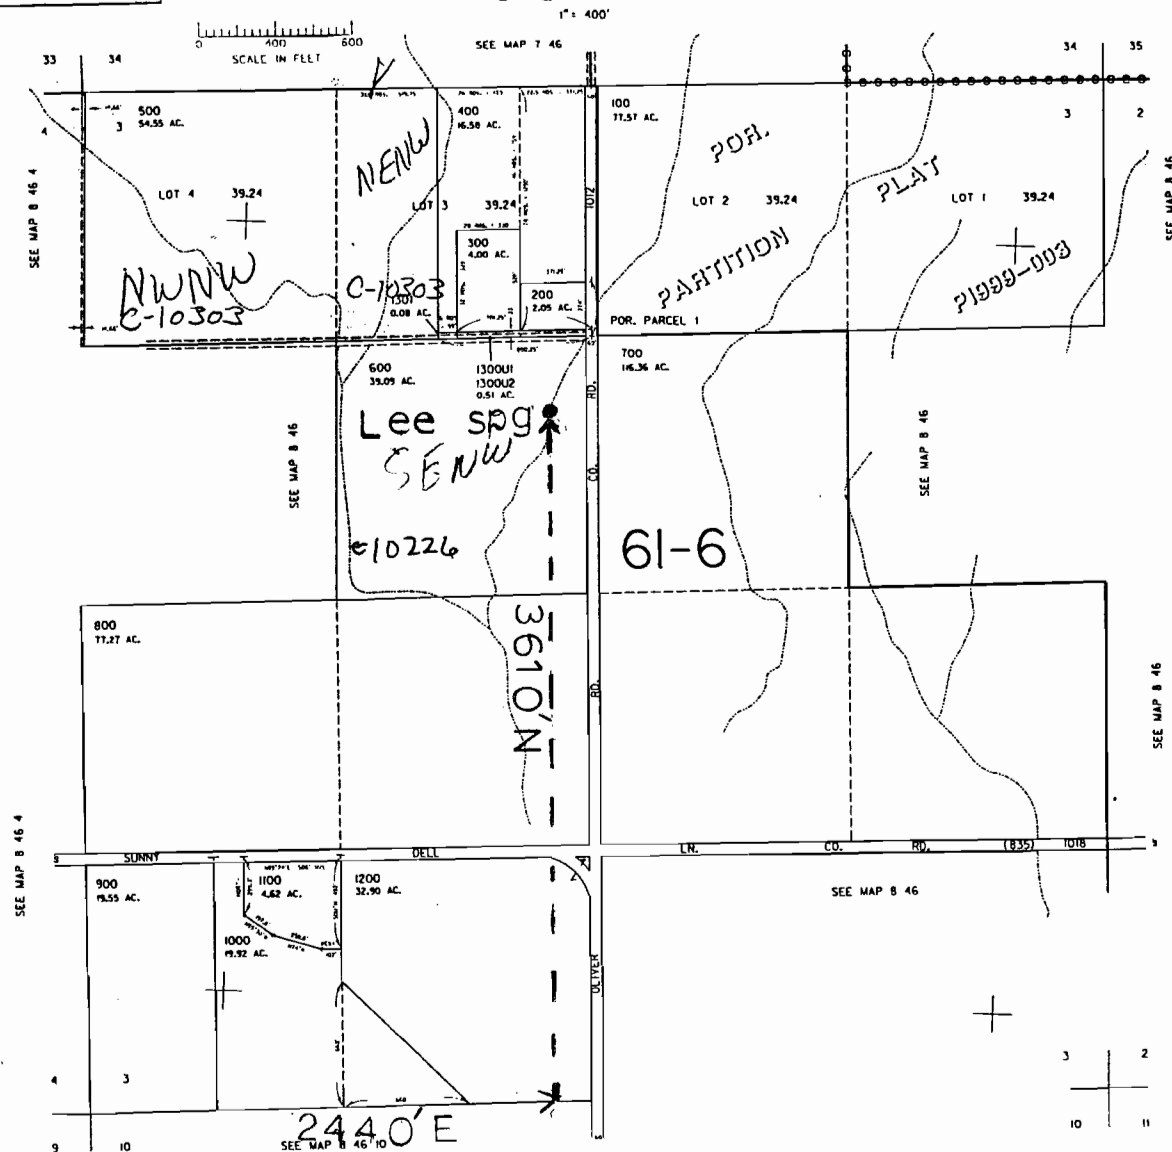

466,000

Revised
B/17/01, CS

8 46 3