

SURFACE WATER RIGHTS APPLICATION MAP

In the Name of: David and Rebecca Weber
63345 Skyline Ranch Road
Bend, Oregon 97701

Elk Lake Tract M, Lot 2
T18S, R8E, Sec 29, SW 1/4 SE 1/4
County Tax Lot 18 8 32A 100AC

SE 1/4 SE 1/4

SW 1/4 SE 1/4

1750'

Water Intake

186'

29 28
32 33

NW1/4 NE1/4

ELK LAKE

NE 1/4 NE 1/4



NORTH
SCALE: 1"= 400'


Water intake is approx. 1750 ft West and 186 ft. North of Corner Sections 28, 29 32, and 33.

RECEIVED

JUN 25 2007

WATER RESOURCES DEPT
SALEM, OREGON

app no 5-86101

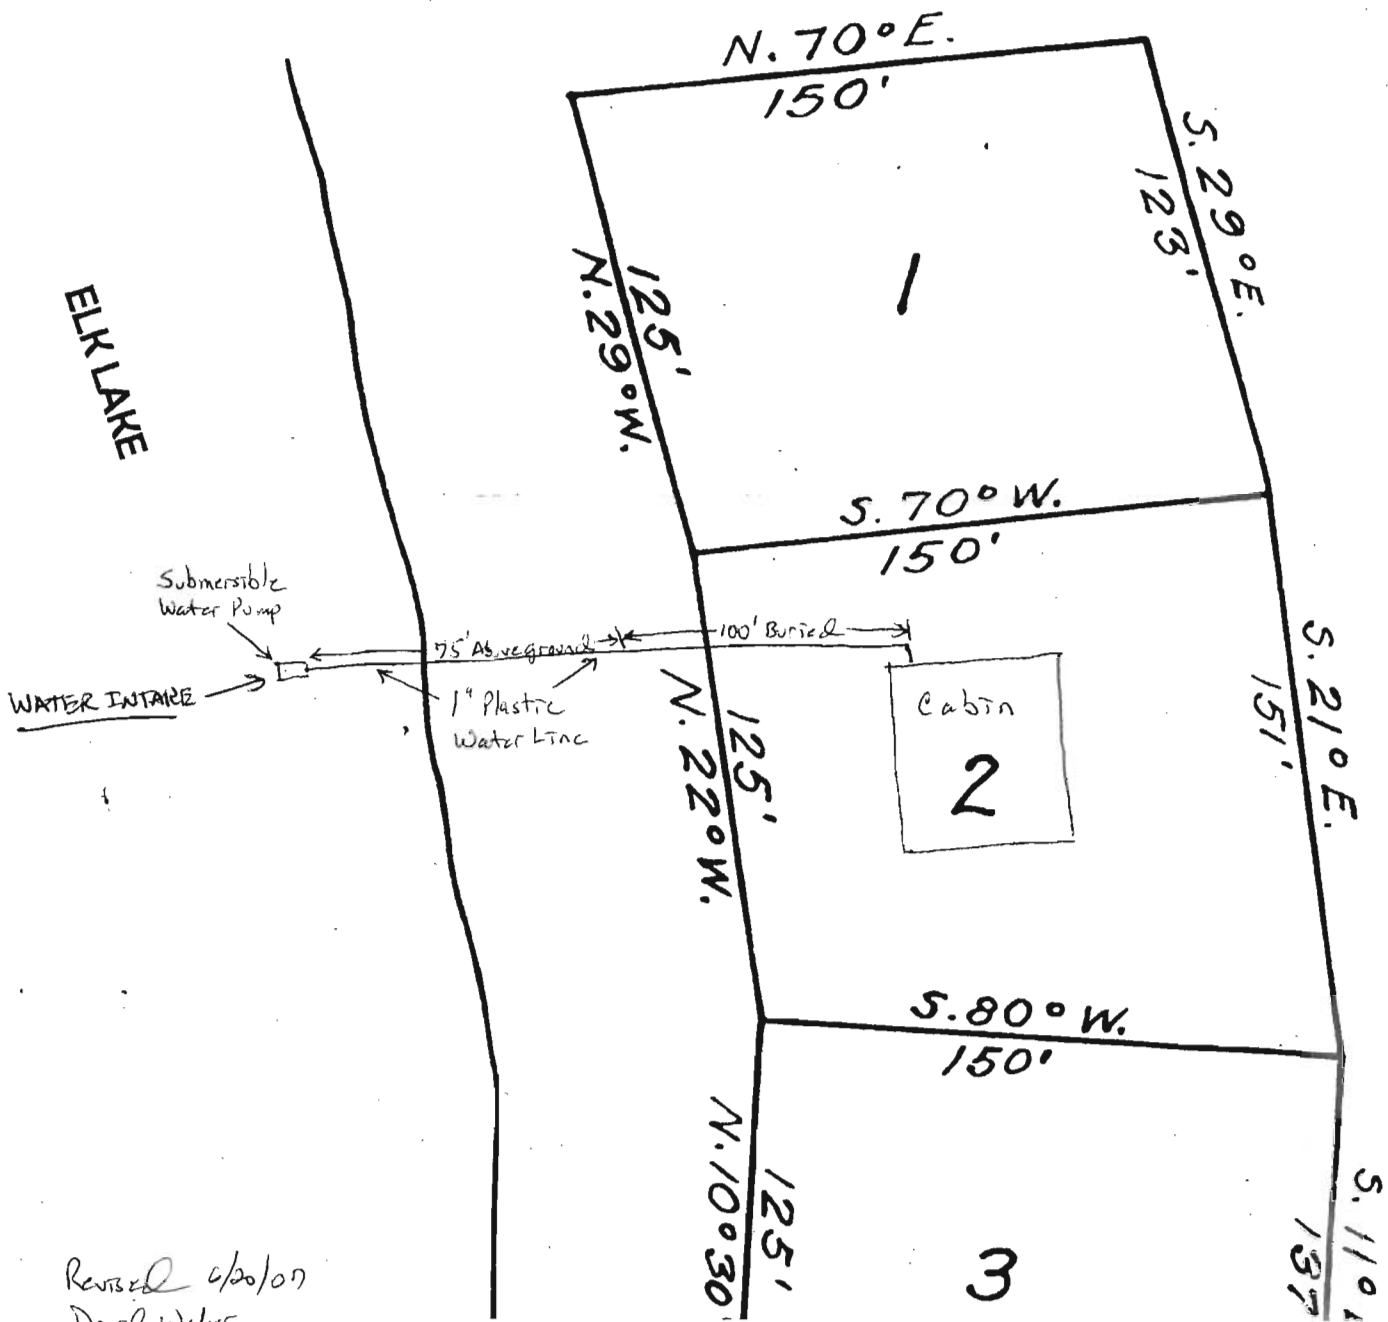

Revised 6/20/07

Daniel Weber

→ Water intake is approx. 1750 ft West and 186 ft North of Corner Sections 28, 29, 32 and 33

~~Intake approximately 186 feet N. and 3,325 feet E. of corner of sections 29, 30, 31, and 32, T18S, R8E, W.M.~~



Tract and Lot	Elk Lake Tract M, Lot 2
Legal Description	T18S, R8E, Sec 29, SW1/4SE1/4
County Tax Lot	18 8 32A 100A2

RECEIVED

JUN 25 2007

WATER RESOURCES DEPT
SALEM, OREGON

RECEIVED

JUN 07 2007

WATER RESOURCES DEPT
SALEM, OREGON

SCALE (in feet)



appnos-86909

