



TRACT E

CO-APPLICANTS

LOTS 11, 12, 10, 7, 6

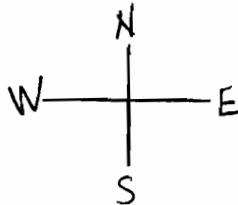

Scale
1" = 1320'

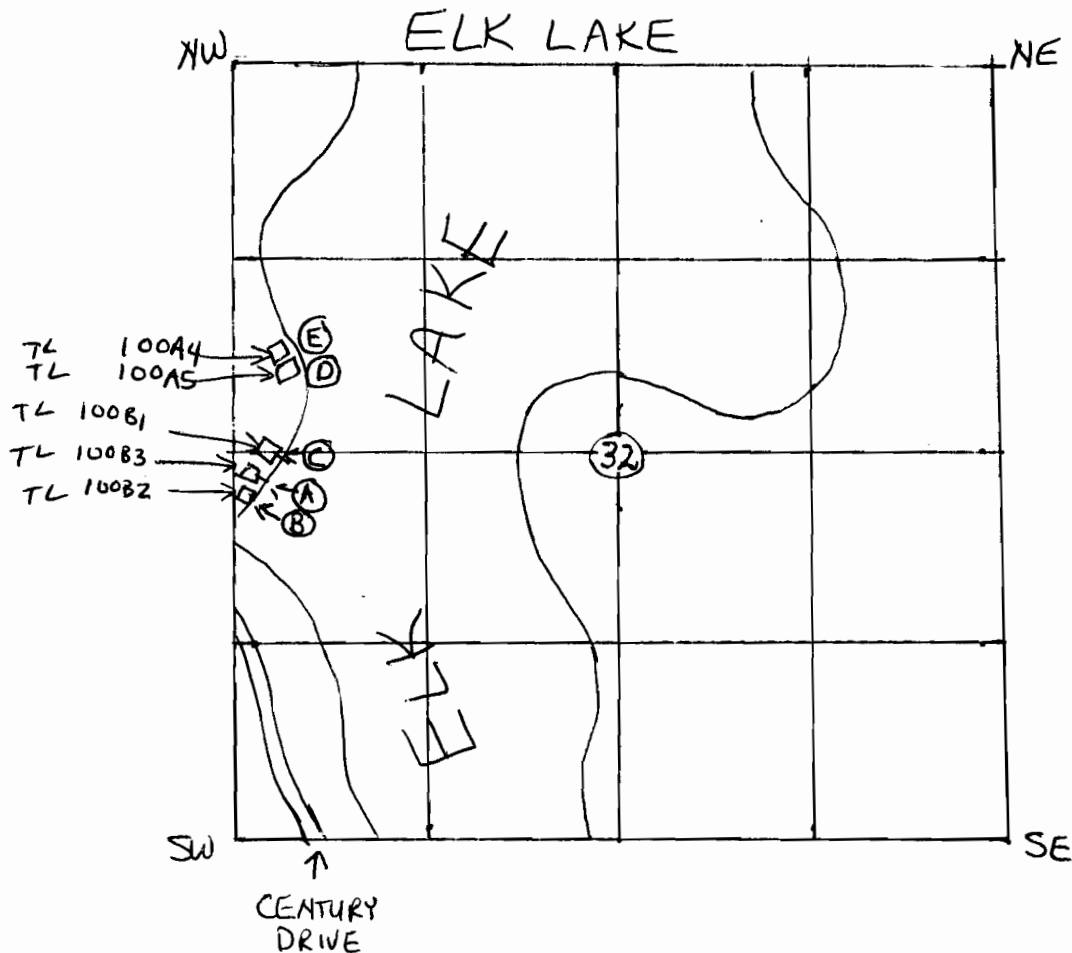

SEE FOLLOWING ATTACHED PAGE FOR
POD A, B, C, D, E LEGAL DESCRIPTIONS
MAP 18 08 32C

Application No _____ Permit No _____

TRACT E CO-APPLICATION % FOREST SERVICE

Surveyed _____, 20____ By: _____

RECEIVED

SEP 07 2007

WATER RESOURCES DEPT
SALEM, OREGON

POD A: Skelton

Elk Lake, Tract E, Lot 11
250' E & 2550' North of the SW Corner of
Section 32, T 18S, R 8E, W.M.
Map 18 08 32C 100B3

POD B: Hart

Elk Lake, Tract E, Lot 12
175' E & 2350' North of the SW Corner of
Section 32, T 18S, R 8E, W.M.
Map 18 08 32C 100B2

POD C: Guyer and Nelson Trust

Elk Lake, Tract E, Lot 10
265' E & 2740' North of the SW Corner of
Section 32, T 18S, R 8E, W.M.
Map 18 08 32C 100B1

POD D: Estes

Elk Lake, Tract E, Lot 7
500' E & 3400' North of the SW Corner of
Section 32, T 18S, R 8E, W.M.
Map 18 08 32C 100A5

POD E: Cleveland

Elk Lake, Tract E, Lot 6
490' E & 3425' North of the SW Corner of
Section 32, T 18S, R 8E, W.M.
Map 18 08 32C 100A4

POD legal description and chart
for attached map

RECEIVED

SEP 14 2007

WATER RESOURCES DEPT
SALEM, OREGON