


# SECTION PLAT

Section 30 Township 22-5 Range 33-E

County of HARNEY State of OR

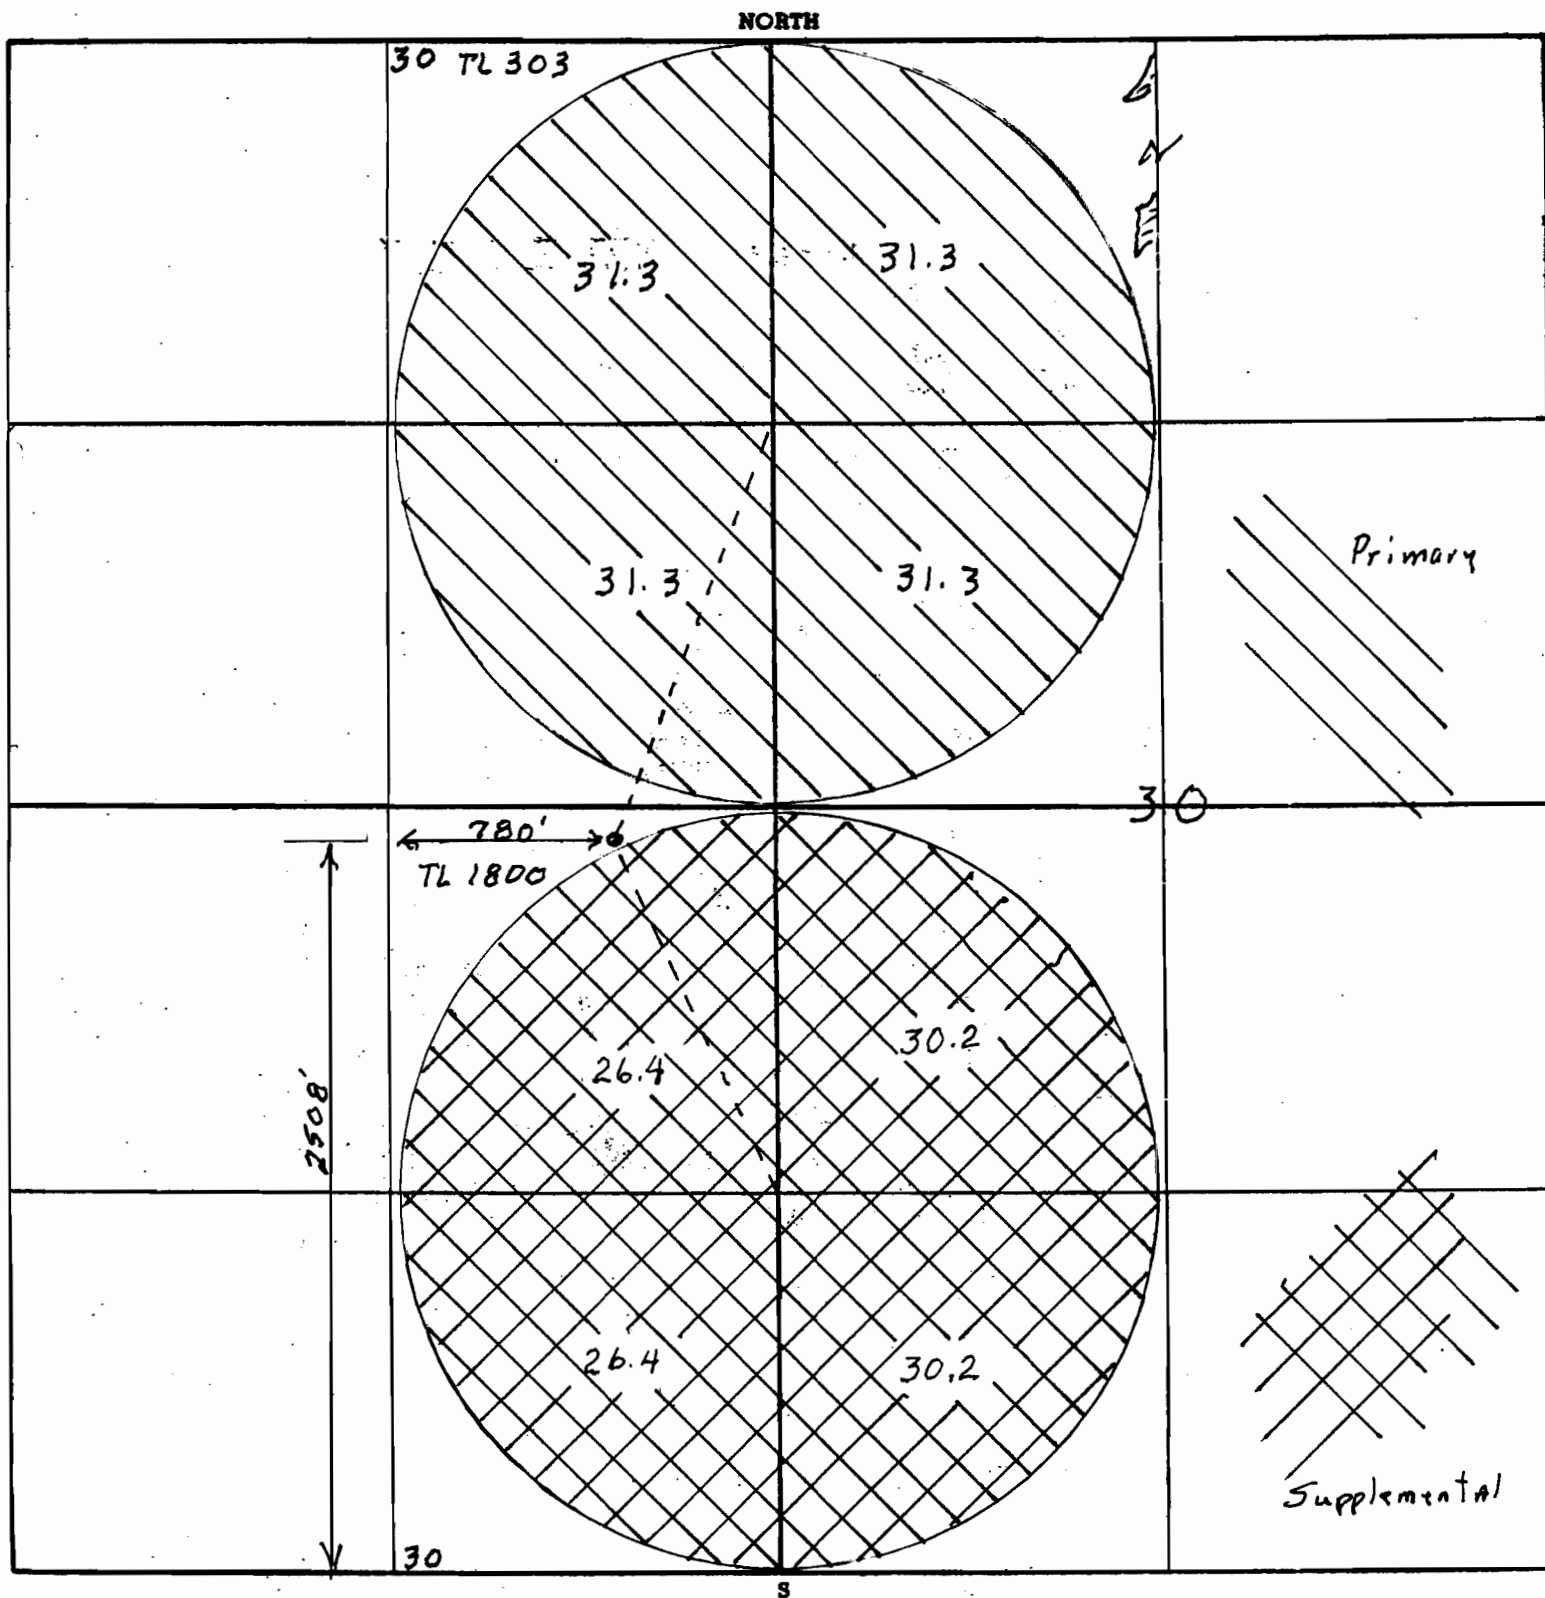

Remarks scale - 8" = 1 mile - 660' -

RECEIVED

SEP 17 2008

WATER RESOURCES DEPT  
SALEM, OREGON