


T. 1N., R. 32 EWM


UMATILLA COUNTY

N

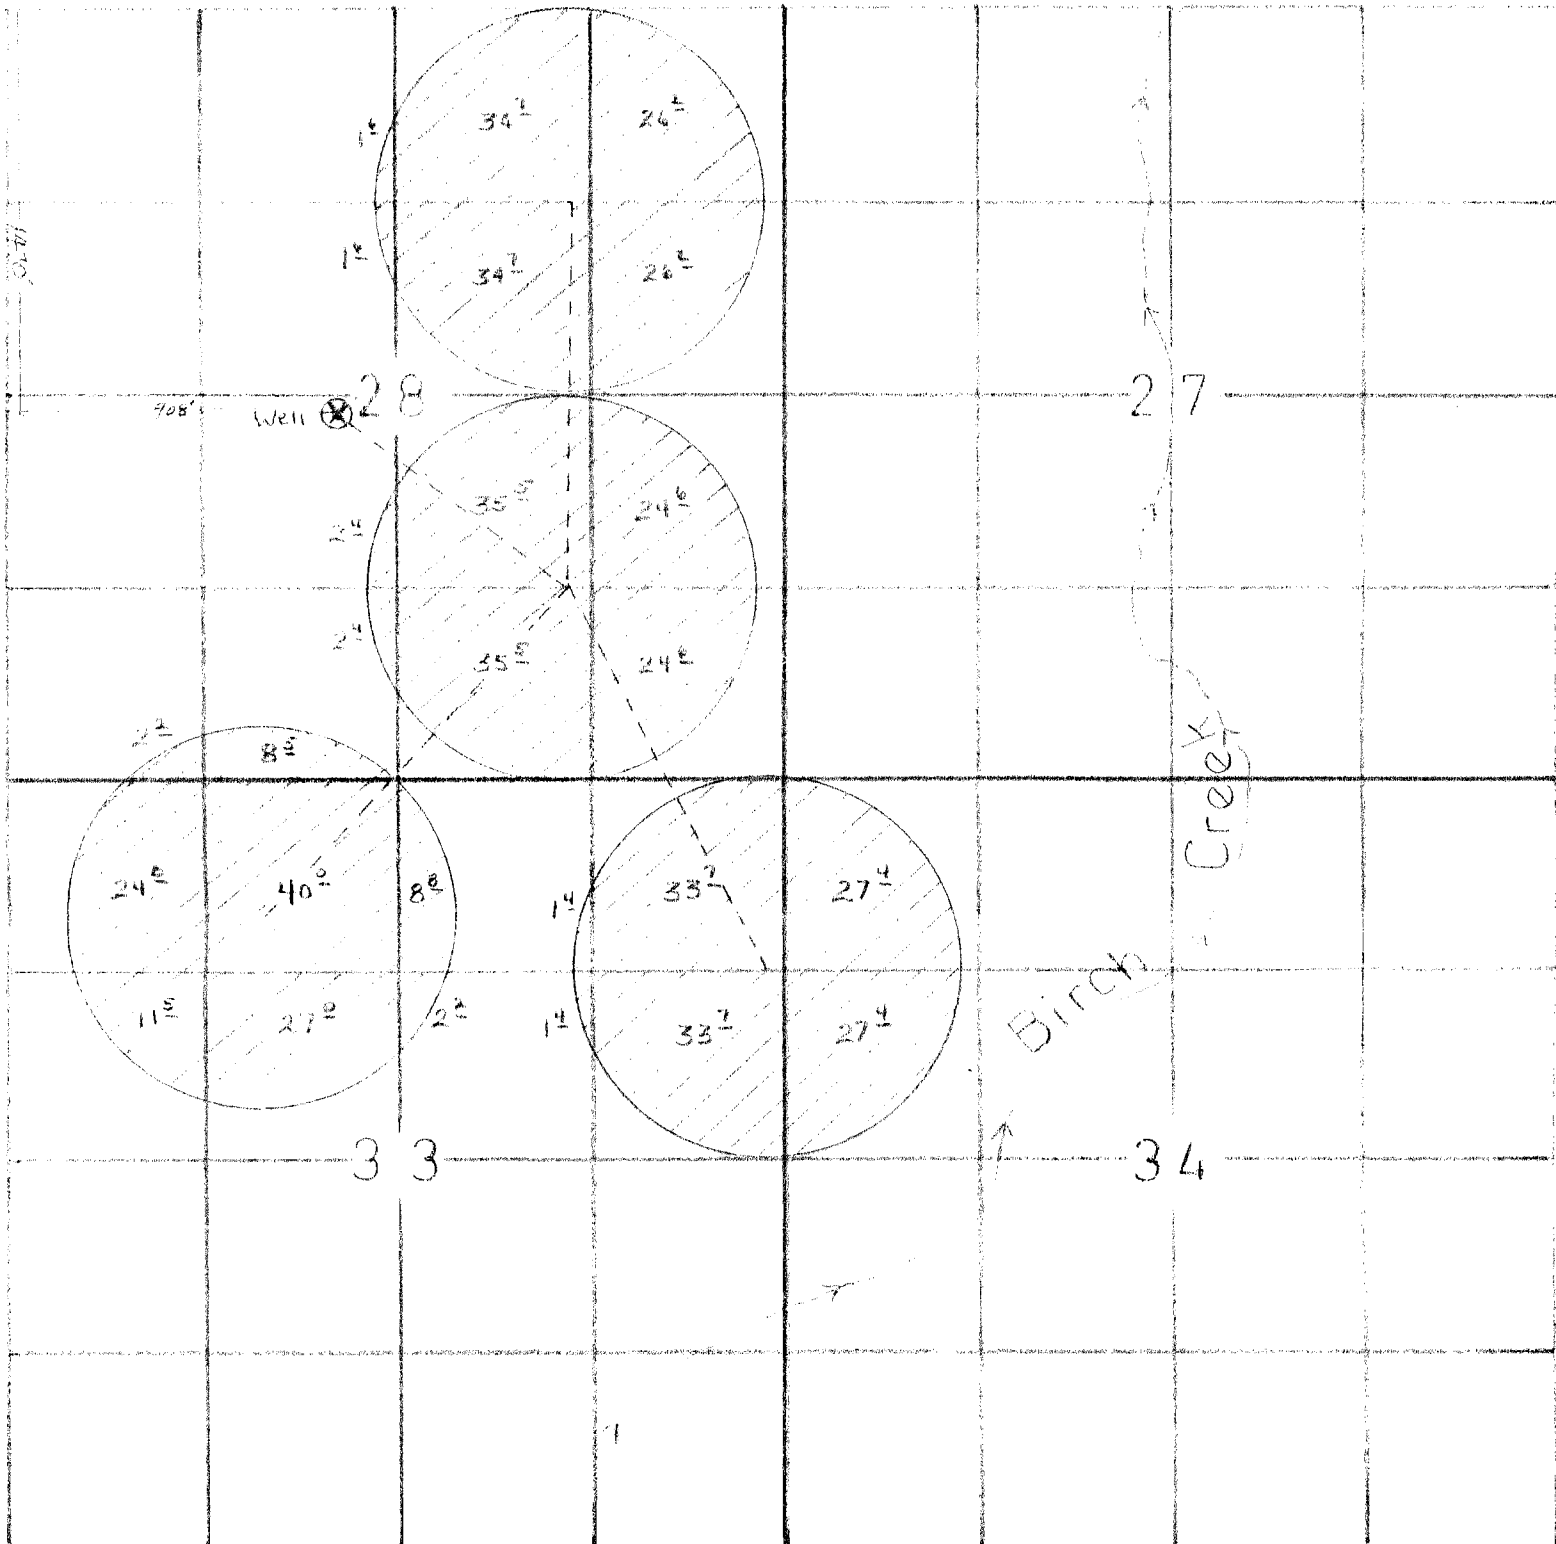

WELL LOCATED 1470' SOUTH AND 908' EAST FROM THE N.W. COR. SECT 28

Scale: 1" = 1320'

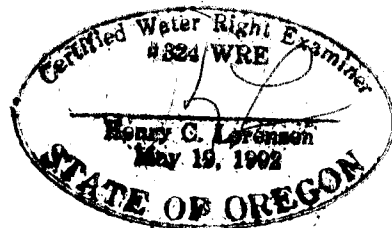

RECEIVED

OCT 06 2008

WATER RESOURCES DEPT
SALEM OREGON