

SECTION PLAT

33

36-5

33-E

Section 4.9.10

Township

37-5

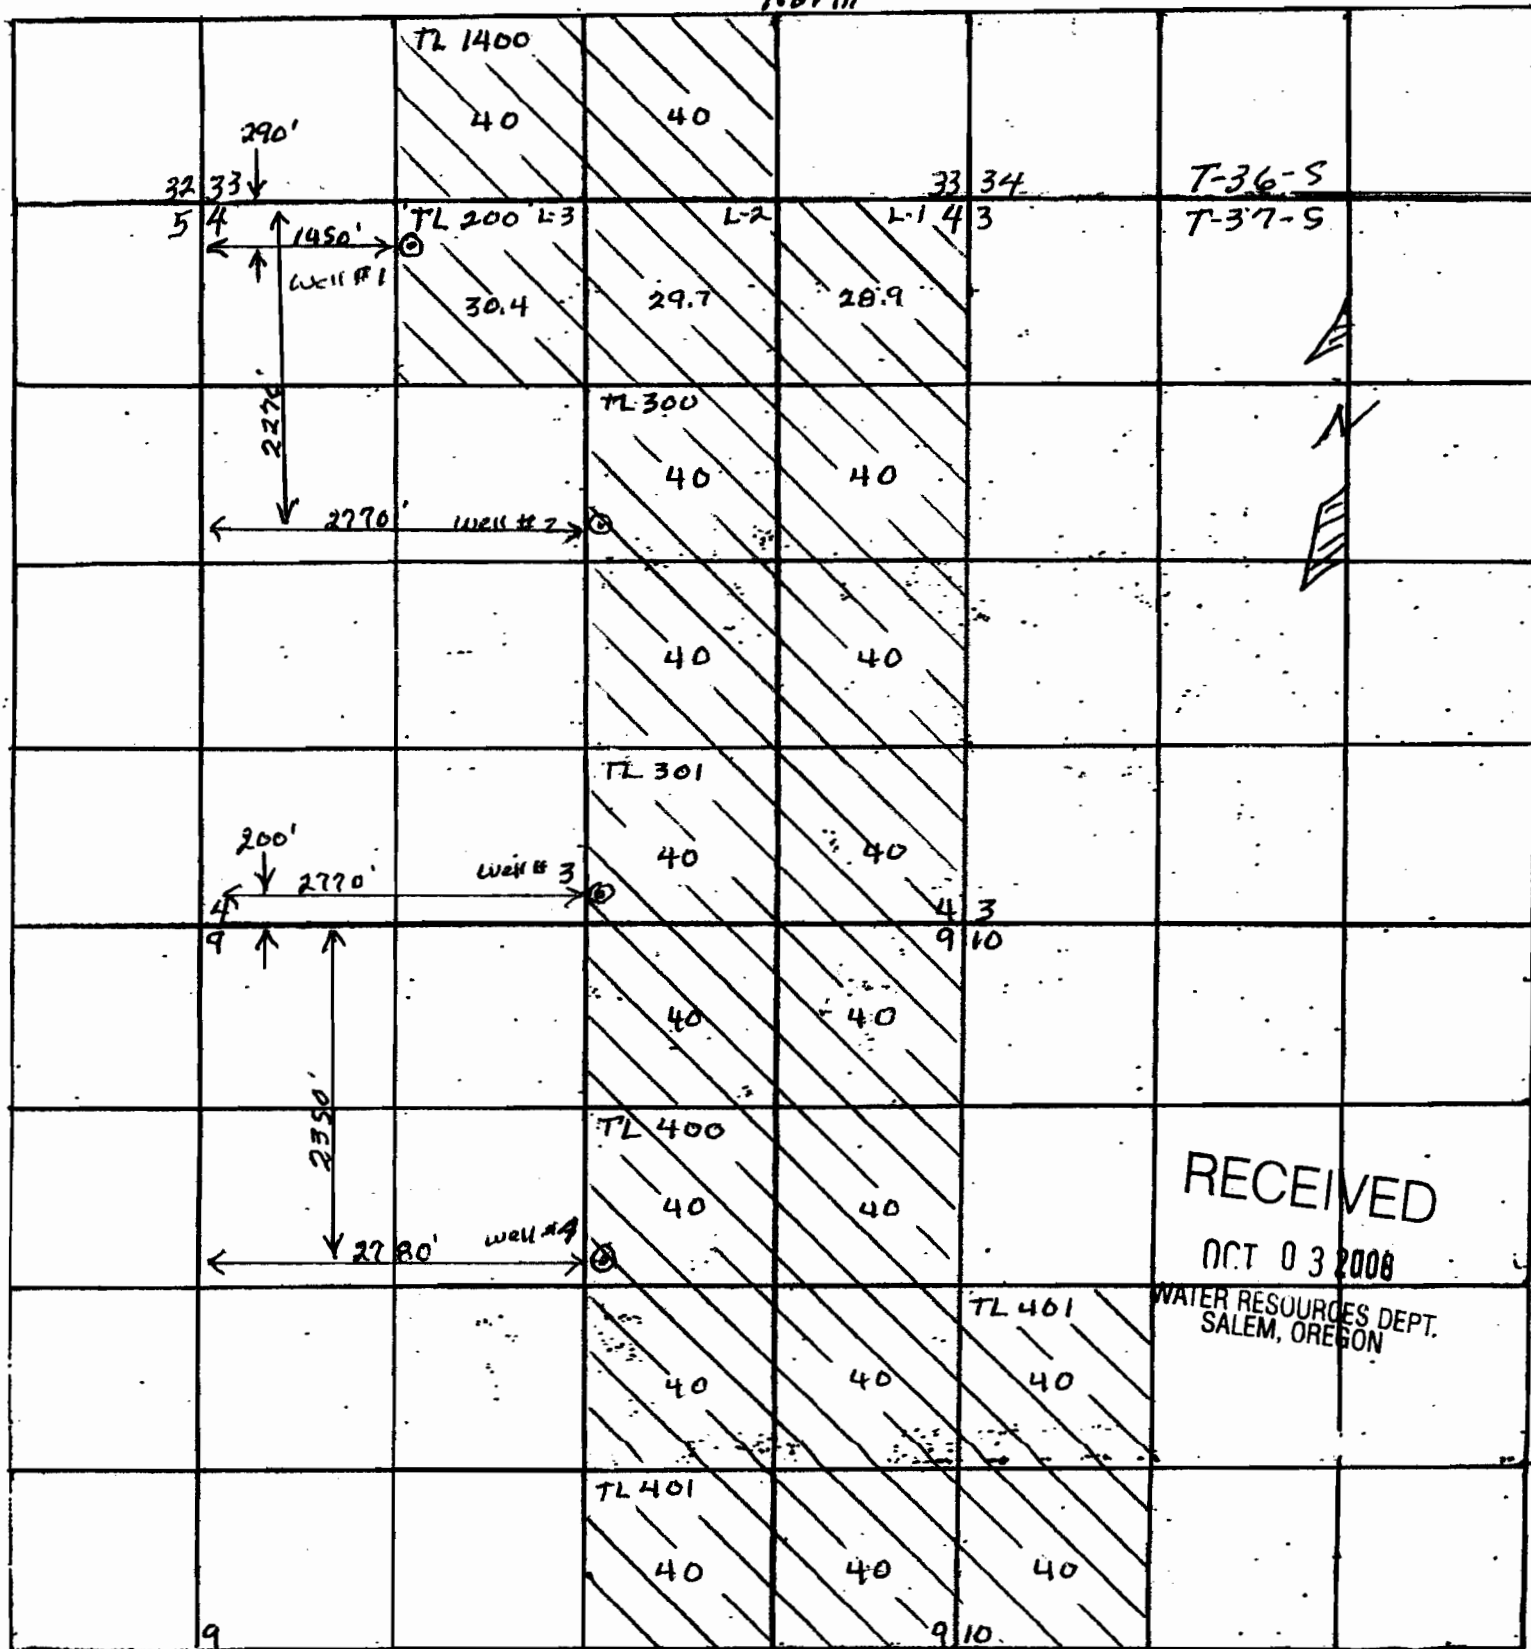
Range

33-E

County of Harney

State of OR

North


$$1'' = 1320'$$

RECEIVED

ОСТ 03 2008

WATER RESOURCES DEPT.
SALEM, OREGON