


# SECTION PLAT

Section 36 Township 22-S Range 32-E

County of HARNEY State of OREGON

NORTH

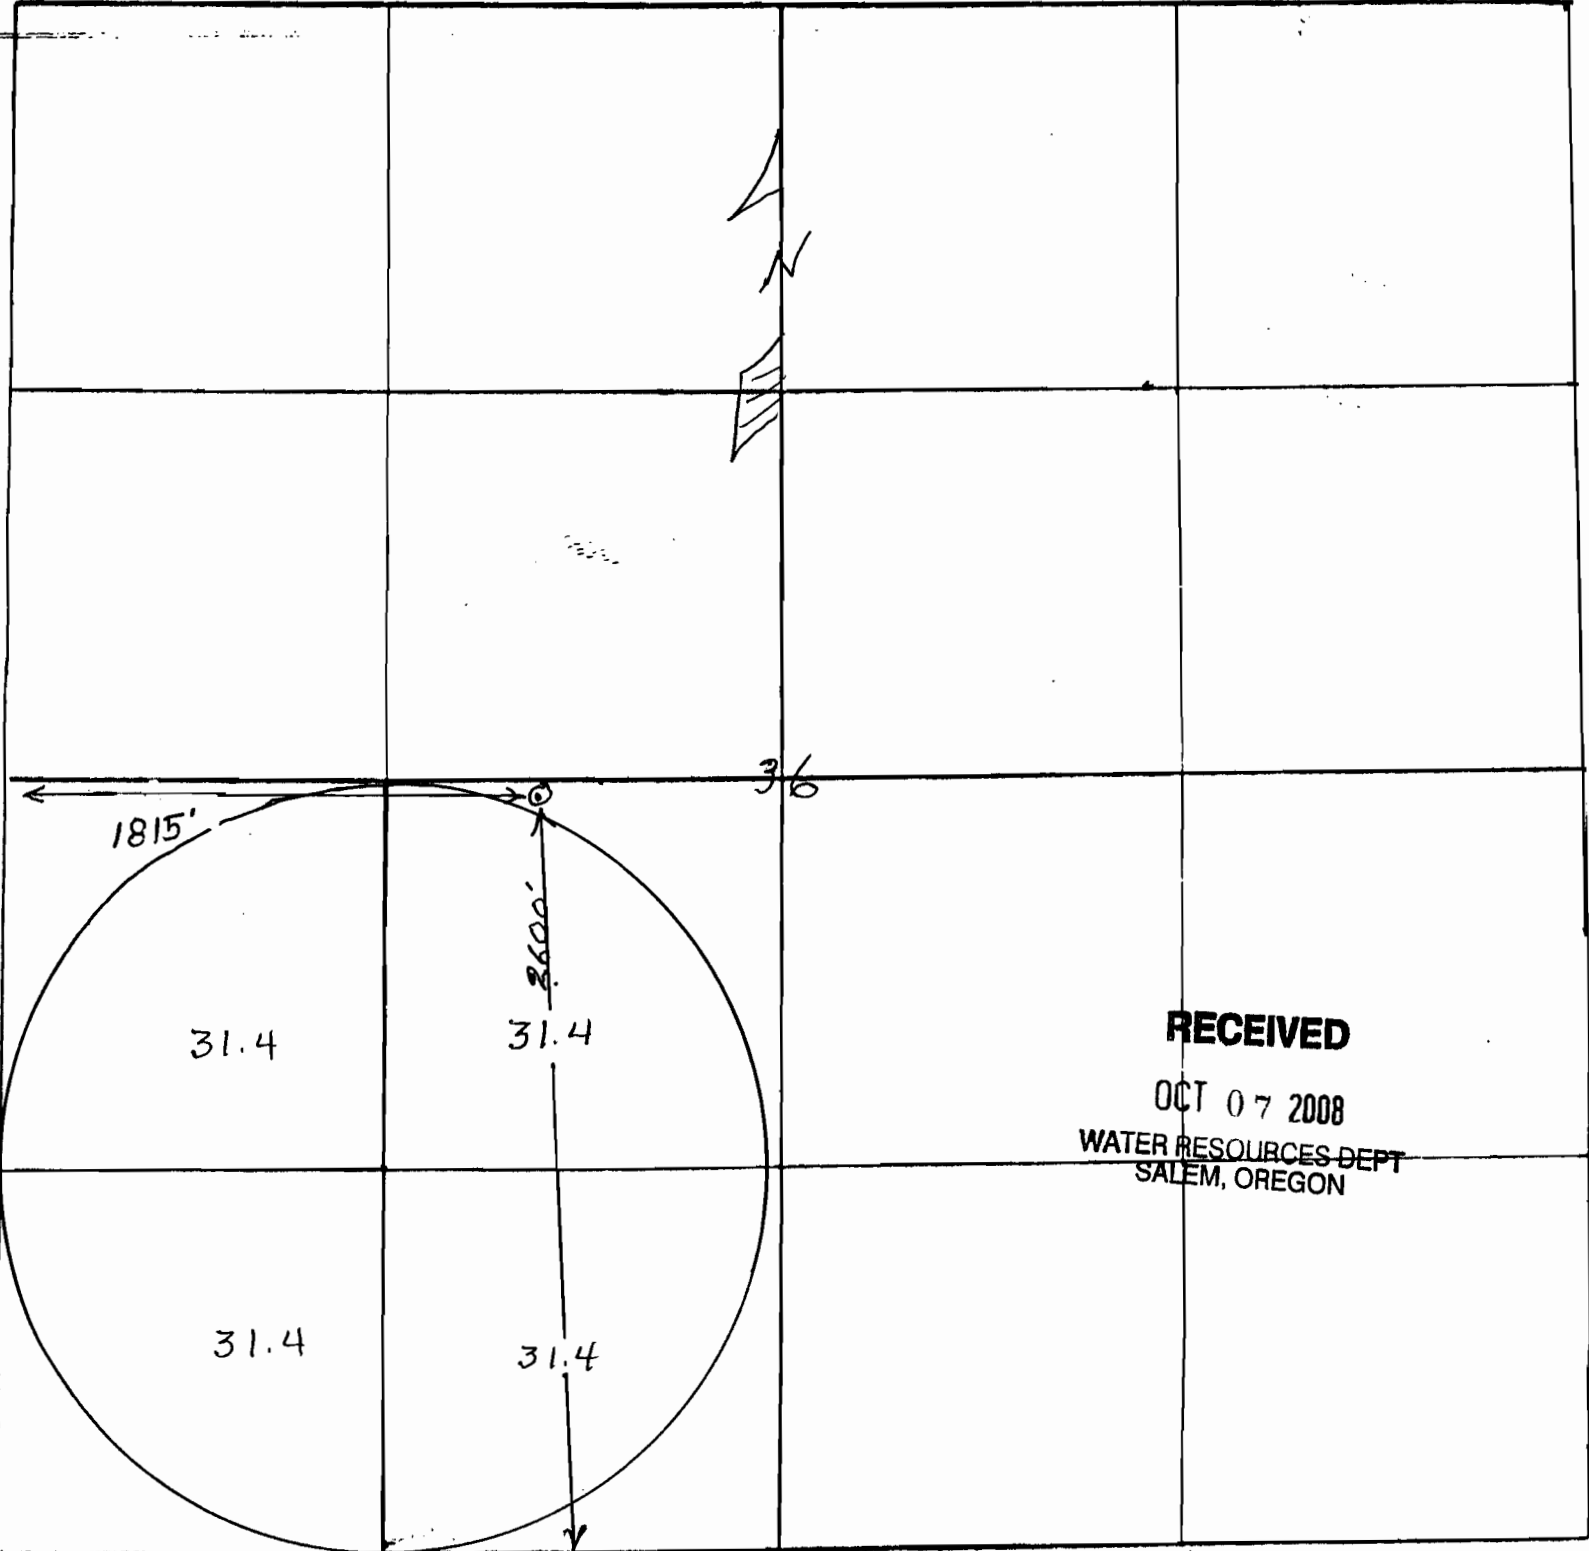

**RECEIVED**  
OCT 07 2008  
WATER RESOURCES DEPT  
SALEM, OREGON

Scale 8" = 1 mile  
1" = 660'