


Peterson
T 5S R 25E Section 23 Tax Lot 1800

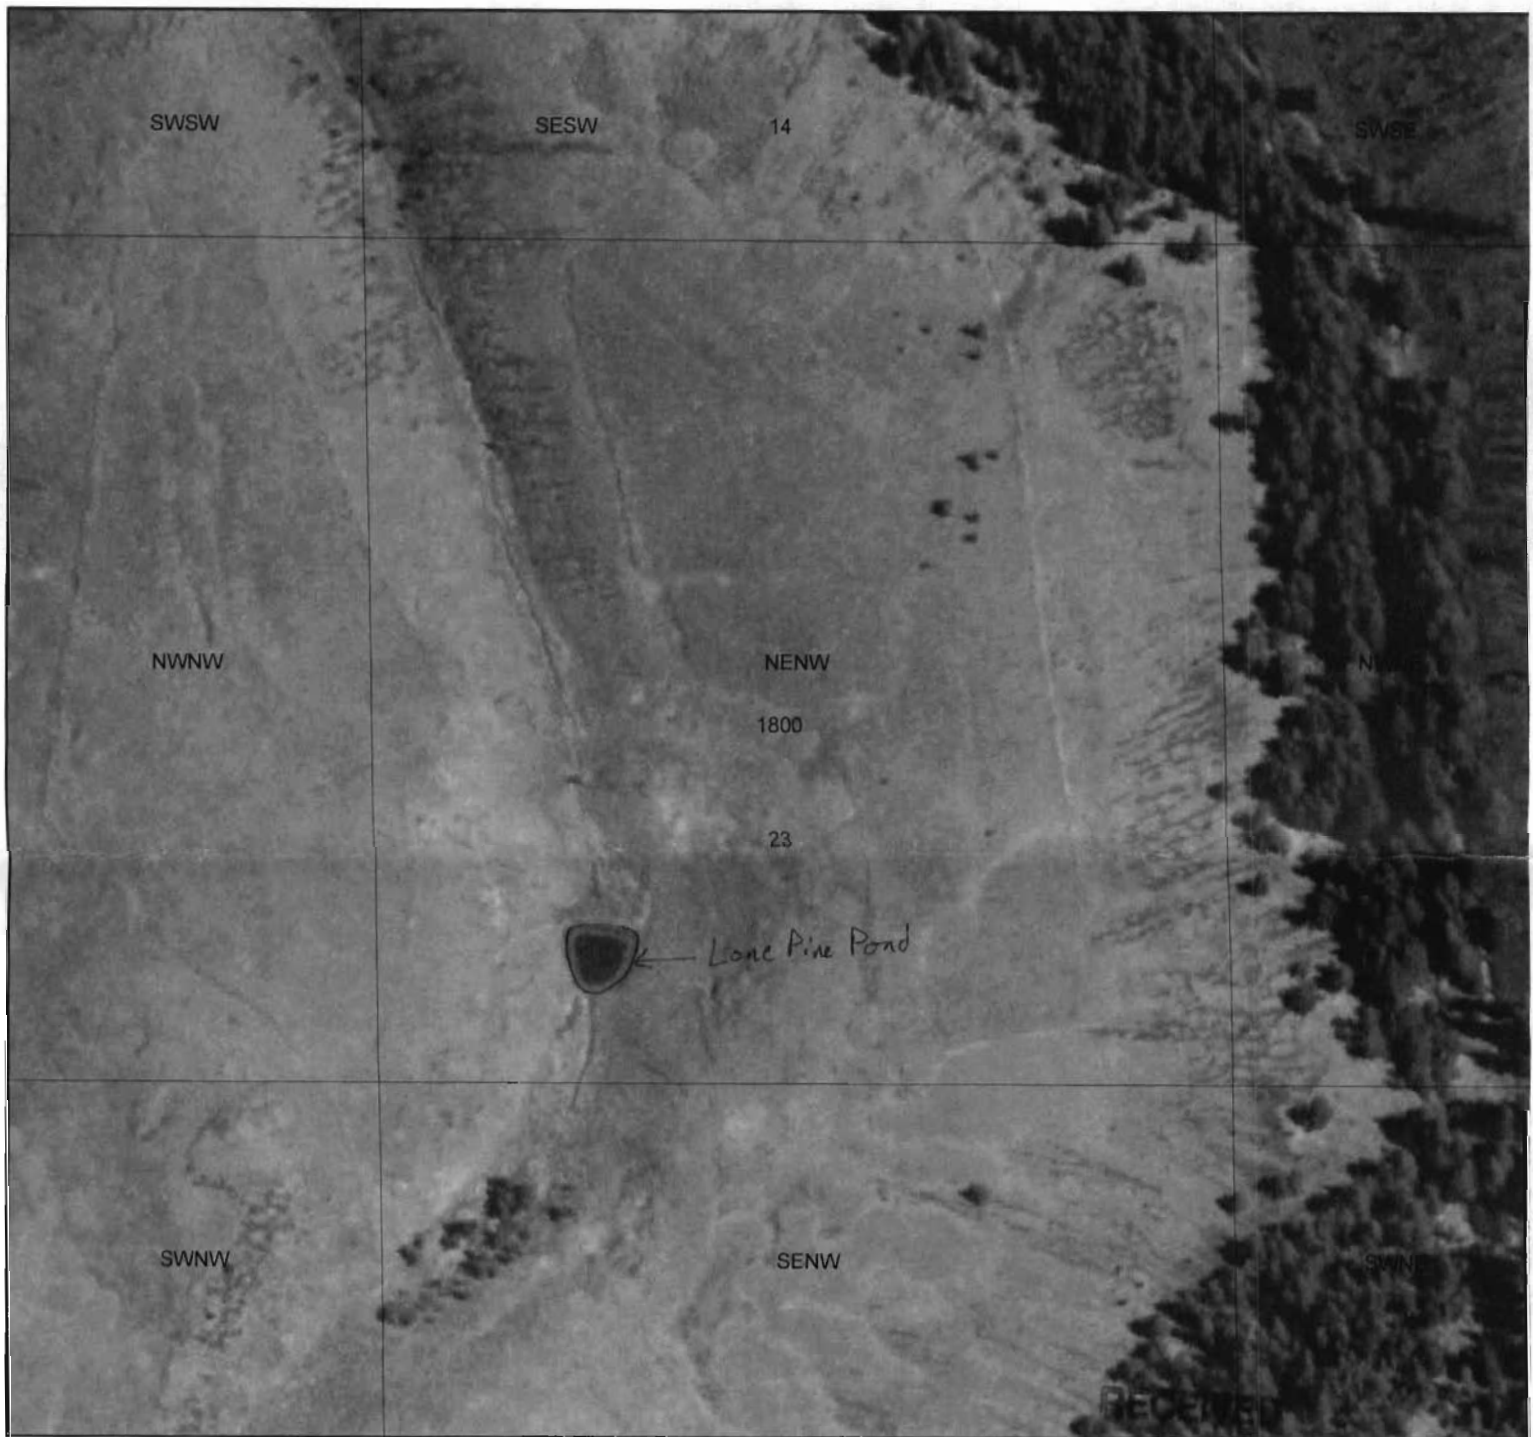

0 245 490 980 Feet

1 inch equals 300 feet

*Center of Pond: 4000 feet East and 2500 feet South of
the NW corner of sec 23.*

OCT 09 2008
WATER RESOURCES DEPT
SALEM, OREGON



This product is for informational purposes and may not have been prepared for, or be suitable for legal, engineering, or surveying purposes. Users of this information should review or consult the primary data and information sources to ascertain the usability of the information.