

Herb Mosgar

From: Jonnine Skaug
Sent: Monday, October 13, 2008 6:49 AM
To: Herb Mosgar
Subject: FW: SW Application

Jonnine Skaug
Water Rights/Adjudication Division
OR Water Resources Department
725 Summer Street NE, Suite A
Salem, OR 97301
phone: 503-986-0807
fax: 503-986-0901

From: tgoodsil [mailto:tgoodsil@gmail.com]
Sent: Sunday, October 12, 2008 10:33 PM
To: Jonnine Skaug
Cc: 'Sandi Godsil'
Subject: RE: SW Application

Herb,
Please proceed with our application. Our (Lot 12, Track G-1) P.O.D. is as indicated on the map you provided.
Thank you. Any question please call on cell, as I will be up at cabin on Mon/Tue of this week.
Tim

Tim Godsil
732 E 22nd Ave
Eugene, OR 97405-2928
Home: 541-344-0556
Cell: 541-915-8852
Email: tgoodsil@uoregon.edu

From: Jonnine Skaug [mailto:skaugjl@wrdd.state.or.us]
Sent: Friday, October 10, 2008 1:43 PM
To: tgoodsil@uoregon.edu
Cc: Herb Mosgar
Subject: SW Application

Hi Timothy,

attached you will find the information Herb asked me to send to you.
Please contact Herb if you have any questions.

thank you,

10/13/2008

Section(s) 14

PLACE OF USE
PARCEL 12

CENTER

NW 1/4 SW 1/4

IN TOWNSHIP 23 S 6 E

POINT of DIVERSION
LOCATED from
CENTER SECTION 14

500 ft SOUTH
1460 ft WEST

• 9

• 13

• 12

QUITA
CREEK

APPROX ADJUSTED
CORRECTED SCALE
1" = 400 FEET

PLACE OF USE Rights shown on this map are approximate.
Multiple shades indicates multiple
sources for rights servicing the parcel.
Number in parcel is referenced in report.

-  Served by a surface water or decreed right
-  Served by a reservoir right

Surf
Inst
App




THIS MAP WAS PREPARED FOR
ASSESSMENT PURPOSE ONLY.

DETAIL MAP OF T.23S. R.06E. W.M.
KLAMATH COUNTY

23 06
DETAIL MAP NO. 1

10

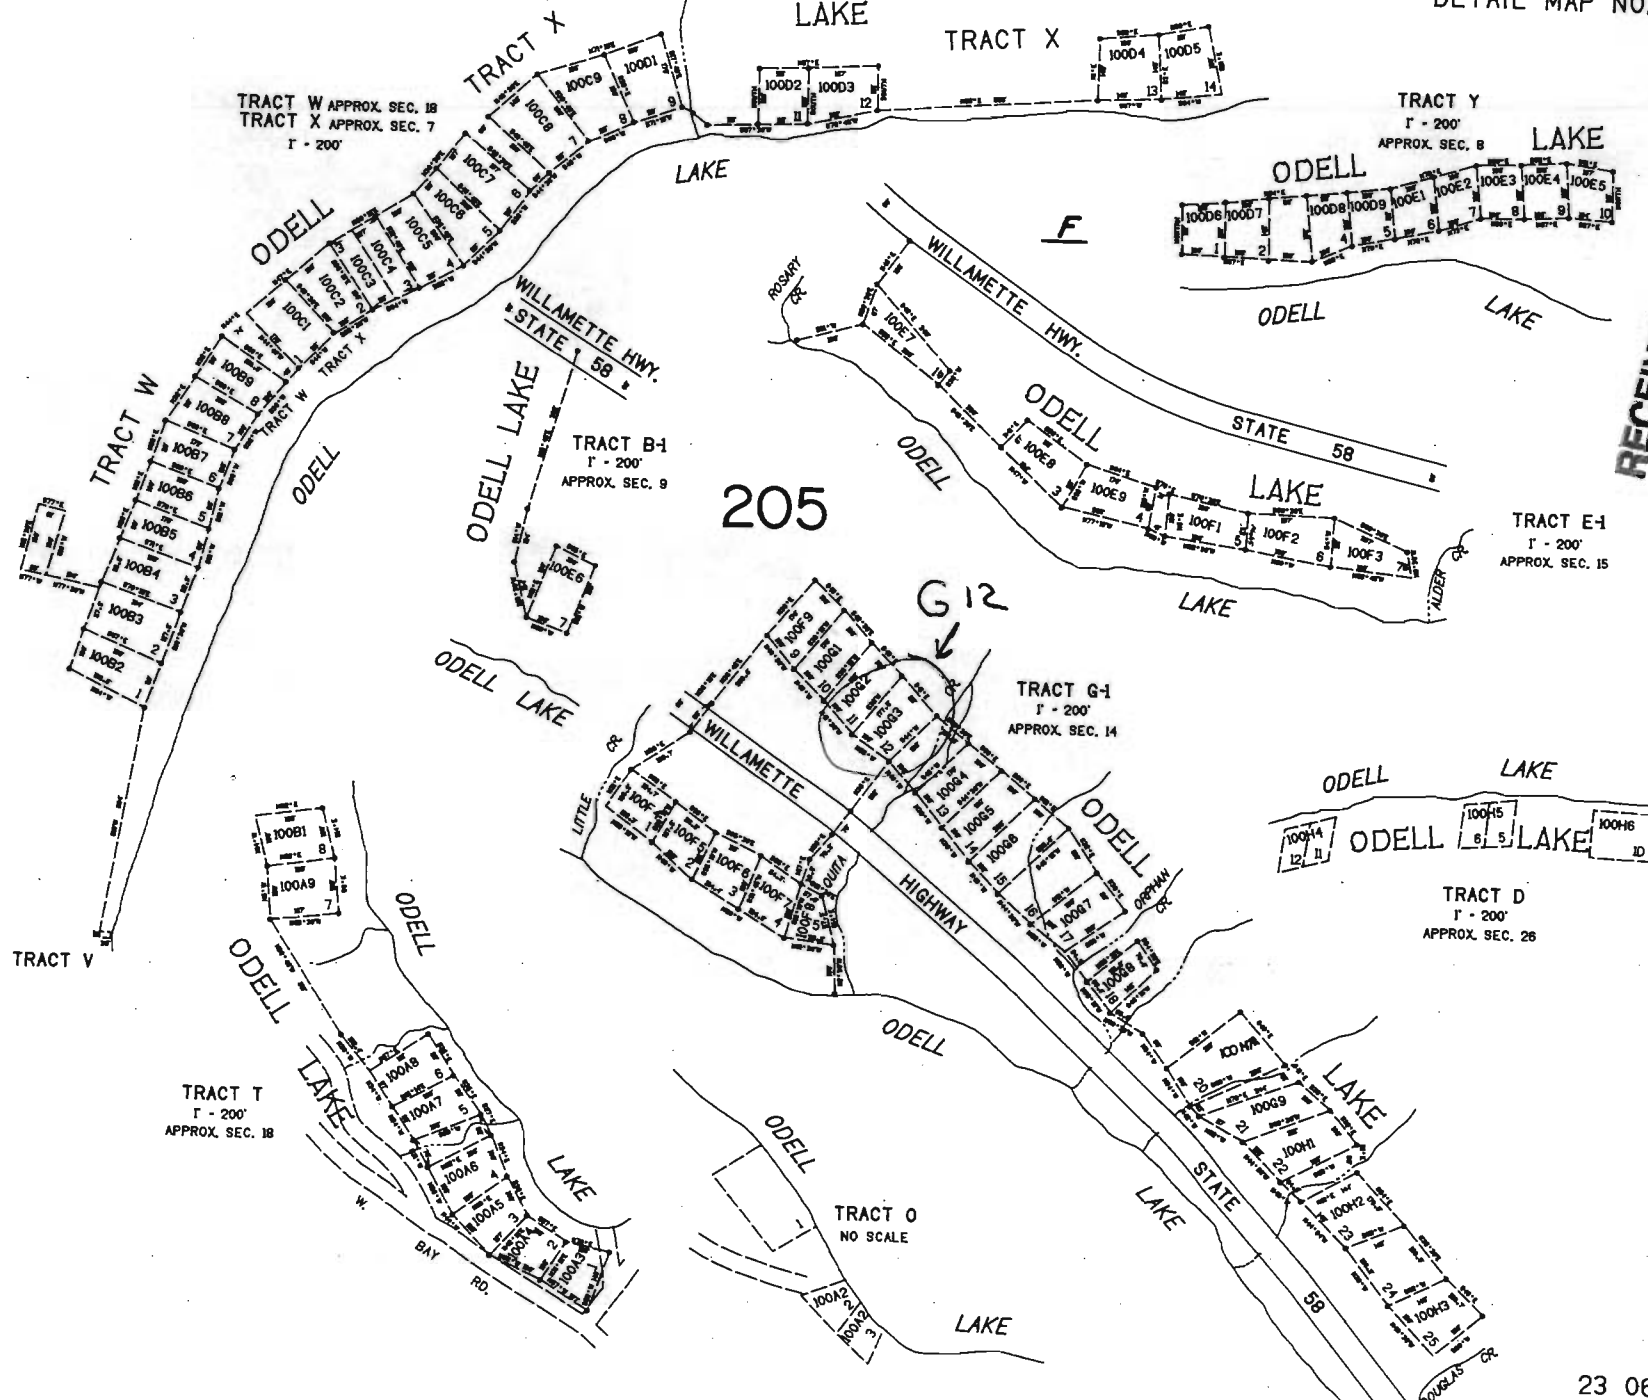

RECEIVED

OCT 07 2008
WATER RESOURCES DEPT
SALEM, OREGON


2720 SPECIAL USES
WATER TRANSMISSION

LOT 12, TRACT G-1
ODELL LAKE

Pipeline to be
buried a minimum
of 18 inches.

water
source
Quita
Creek

215'
APPROX.

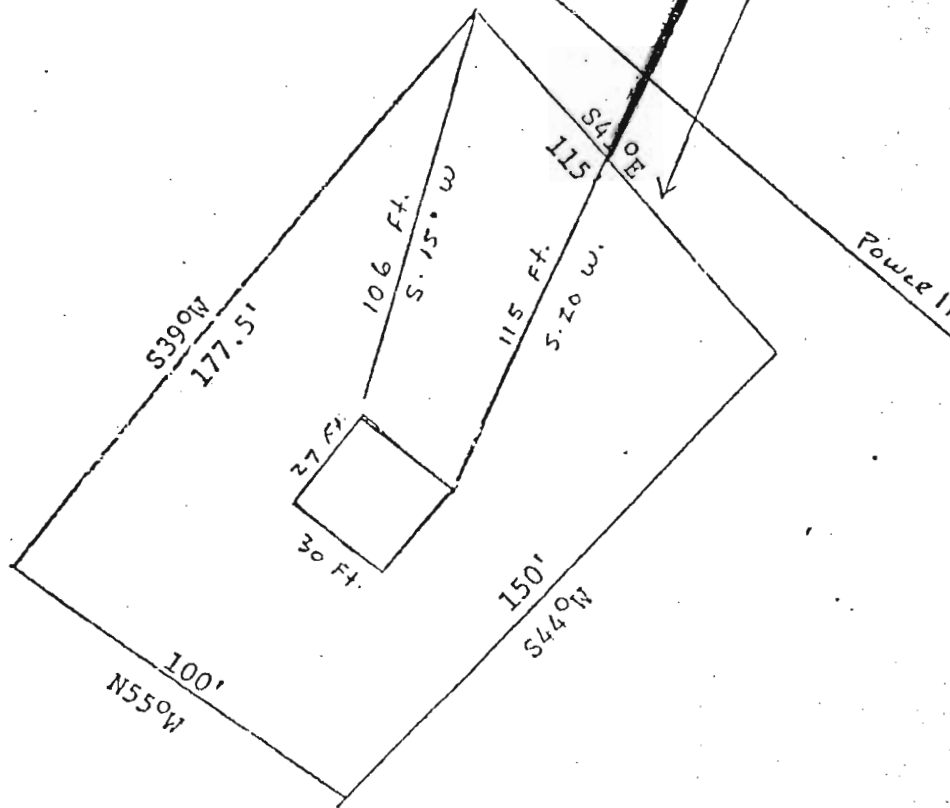


SCALE: 1" = 50'


J.V.

RECEIVED
OCT 07 2008
WATER RESOURCES DEPT
SALEM, OREGON

3

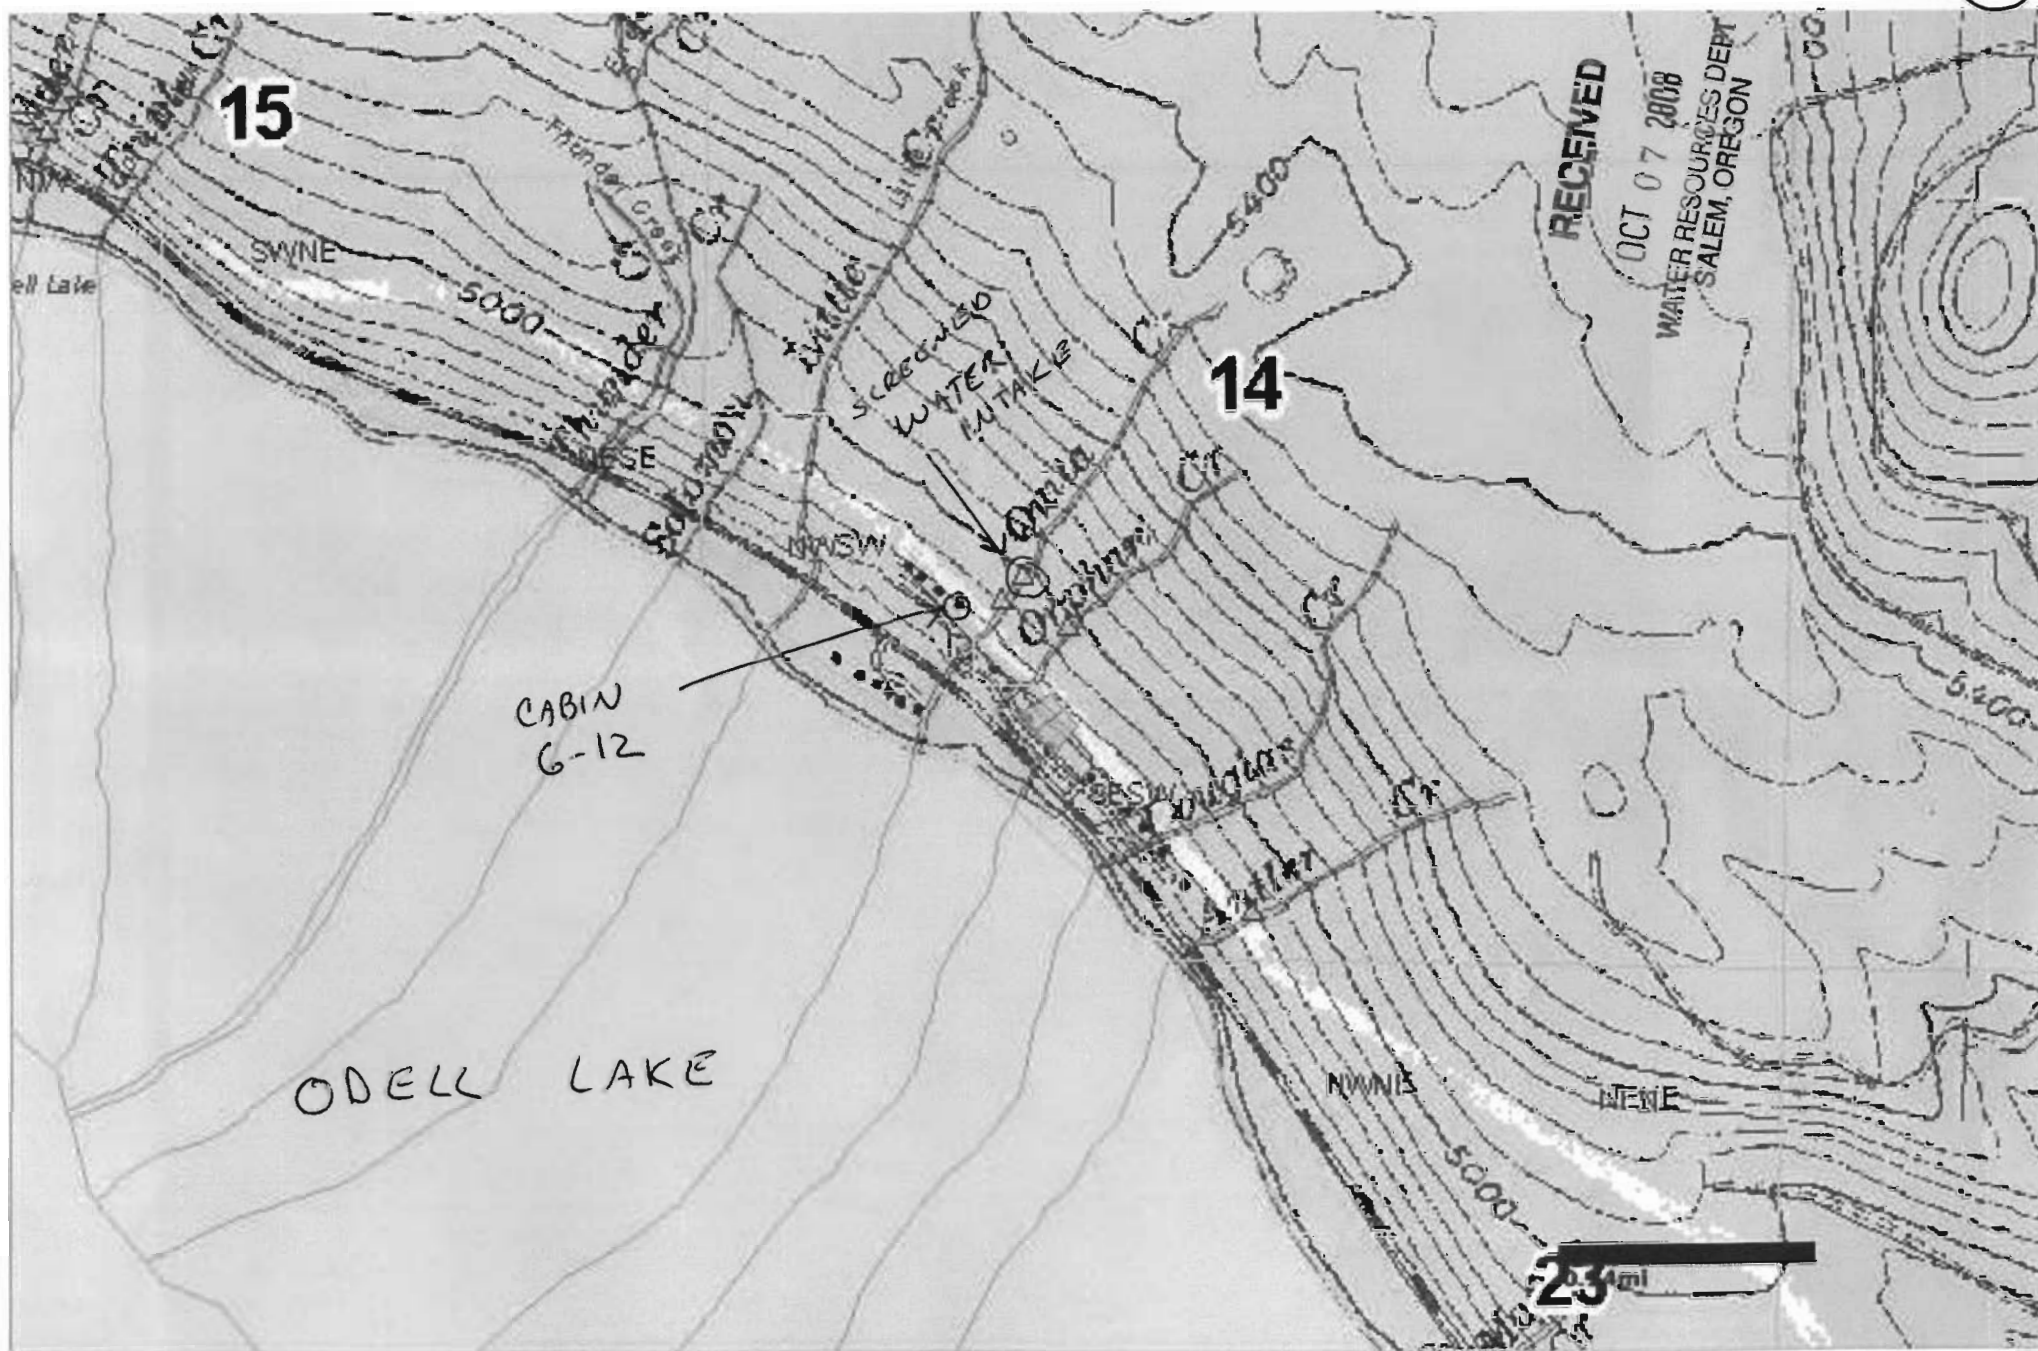

DESCHUTES COUNTY

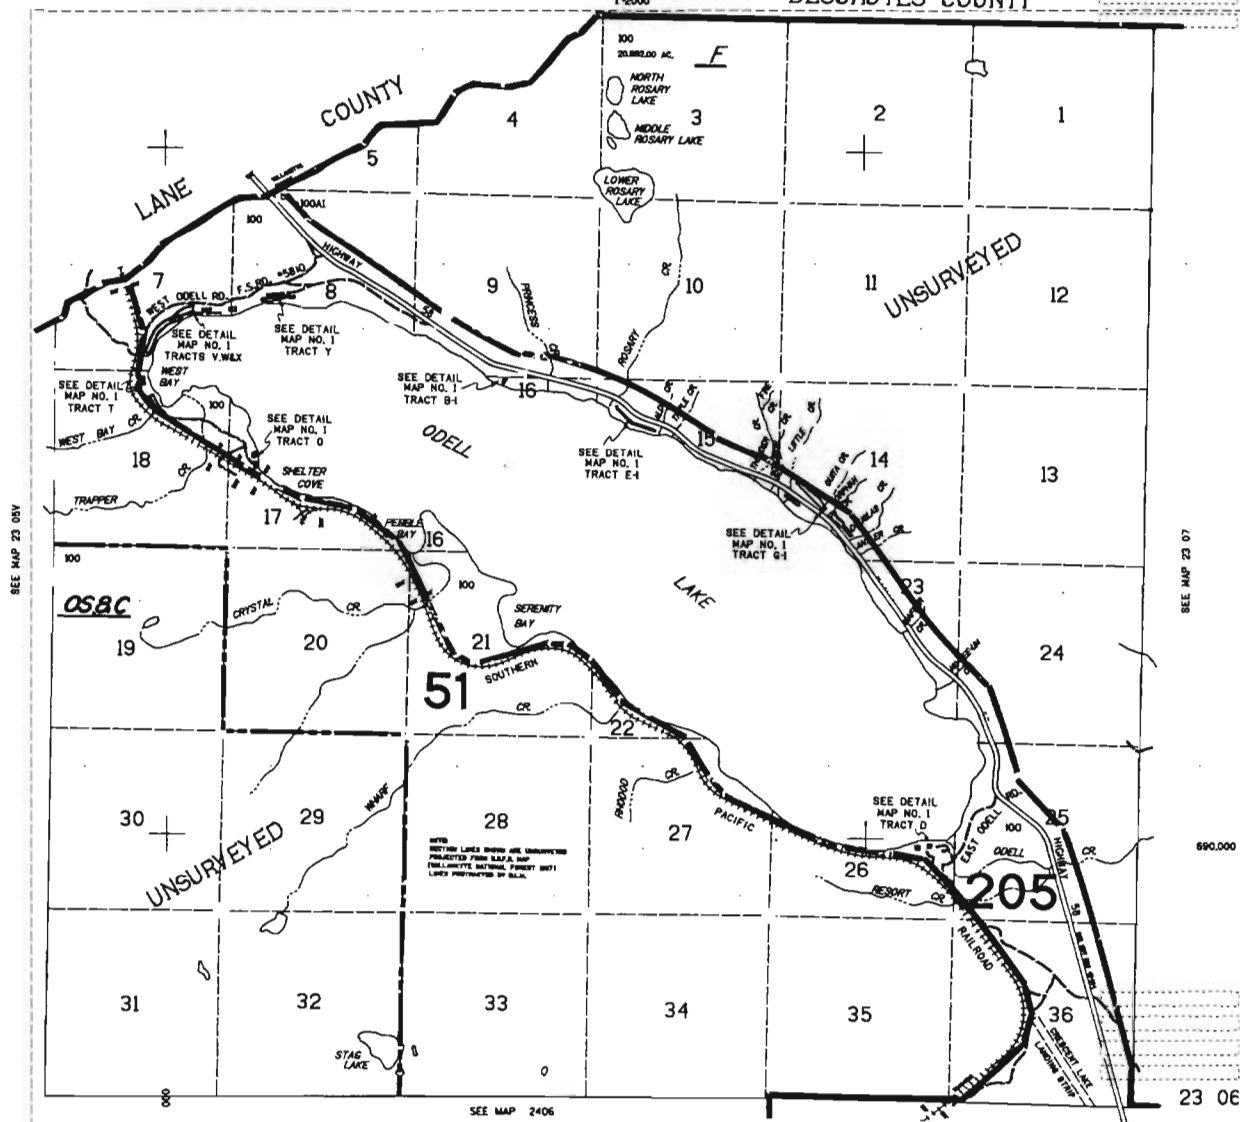

RECEIVED
OCT 07 2008
WATER RESOURCES DEPT
SALEM, OREGON