

Herb Mosgar

From: Jonnine Skaug
Sent: Tuesday, October 14, 2008 7:55 AM
To: Herb Mosgar
Subject: FW: Alt-Res Application

Jonnine Skaug
Water Rights/Adjudication Division
OR Water Resources Department
725 Summer Street NE, Suite A
Salem, OR 97301
phone: 503-986-0807
fax: 503-986-0901

From: Dan Thorpe [mailto:dthorpe@ccountry.net]
Sent: Tuesday, October 14, 2008 6:18 AM
To: Jonnine Skaug
Subject: RE: Alt-Res Application

Yes, this map is fine. Sorry I failed to include the appropriate legal description.
Please let me know if you lack any other details.

Dan Thorpe

-----Original Message-----

From: Jonnine Skaug [mailto:skaugjl@wrd.state.or.us]
Sent: Monday, October 13, 2008 10:16 AM
To: dthorpe@ccountry.net
Cc: Herb Mosgar
Subject: Alt-Res Application

Hi Dan,

attached you will find the information Herb asked me to send to you.
Please contact Herb if you have any questions.

thank you,

Jonnine Skaug
Water Rights/Adjudication Division
OR Water Resources Department
725 Summer Street NE, Suite A
Salem, OR 97301
phone: 503-986-0807
fax: 503-986-0901

10/14/2008

S.E.1/4, SEC.36, T.36S., R.3W., W.M.
JACKSON COUNTY

1" = 300'

ADJUSTED CORRECTED
APPROX SCALE

1" = 300 FEET

SEE MAP 36 JW 36

NW. COR. DLC 68
NE. COR. DLC 39

NW. COR. DLC 39

1/4 COR.

NE. COR. DLC 1
100
10.57 AC.

NE 1/4 SE 1/4

STAG

RESERVOIR LOCATED FROM
SE CORNER SECTION 36

2330 ft NORTH
430 ft WEST

6-4
SE 1/4

SE 1/4 SE 1/4

SW. COR. DLC 39


SEE MAP 37 JW 01A

SpotFires Map




Legend

-  Sections
-  Taxlots - Jackson SFF
-  Highways
 -  Interstate Highway
 -  Municipal Highway
 -  State Highway
 -  US Highway
-  Lakes

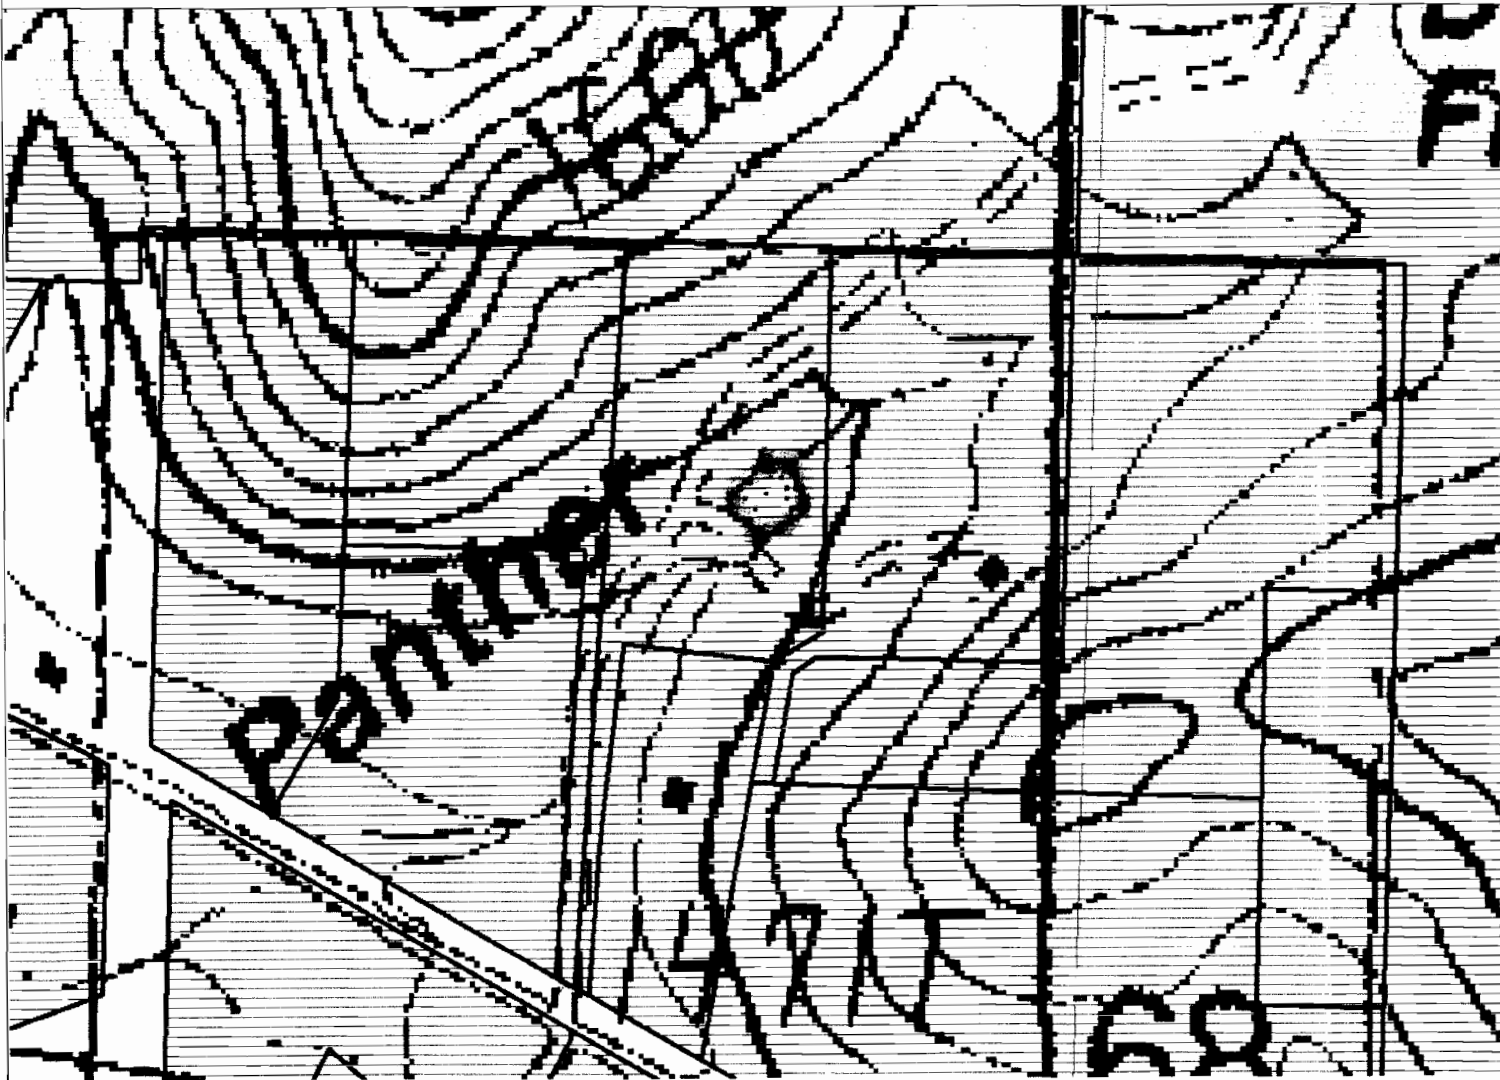

1in. = 300ft.

Vicinity

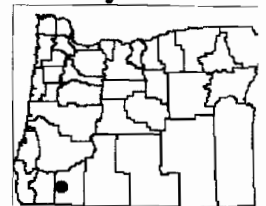

Oregon Department of Forestry
09/15/2008

RECEIVED

OCT 10 2008

WATER RESOURCES DEPT
SALEM, OREGON


36 3W Sec. 36 TL 500

S.E.1/4, SEC.36, T.36S., R.3W., W.M.
JACKSON COUNTY
1" = 200'

36 3W 36D

FOR ASSESSMENT AND
TAXATION ONLY

SEE MAP 36 3W 36

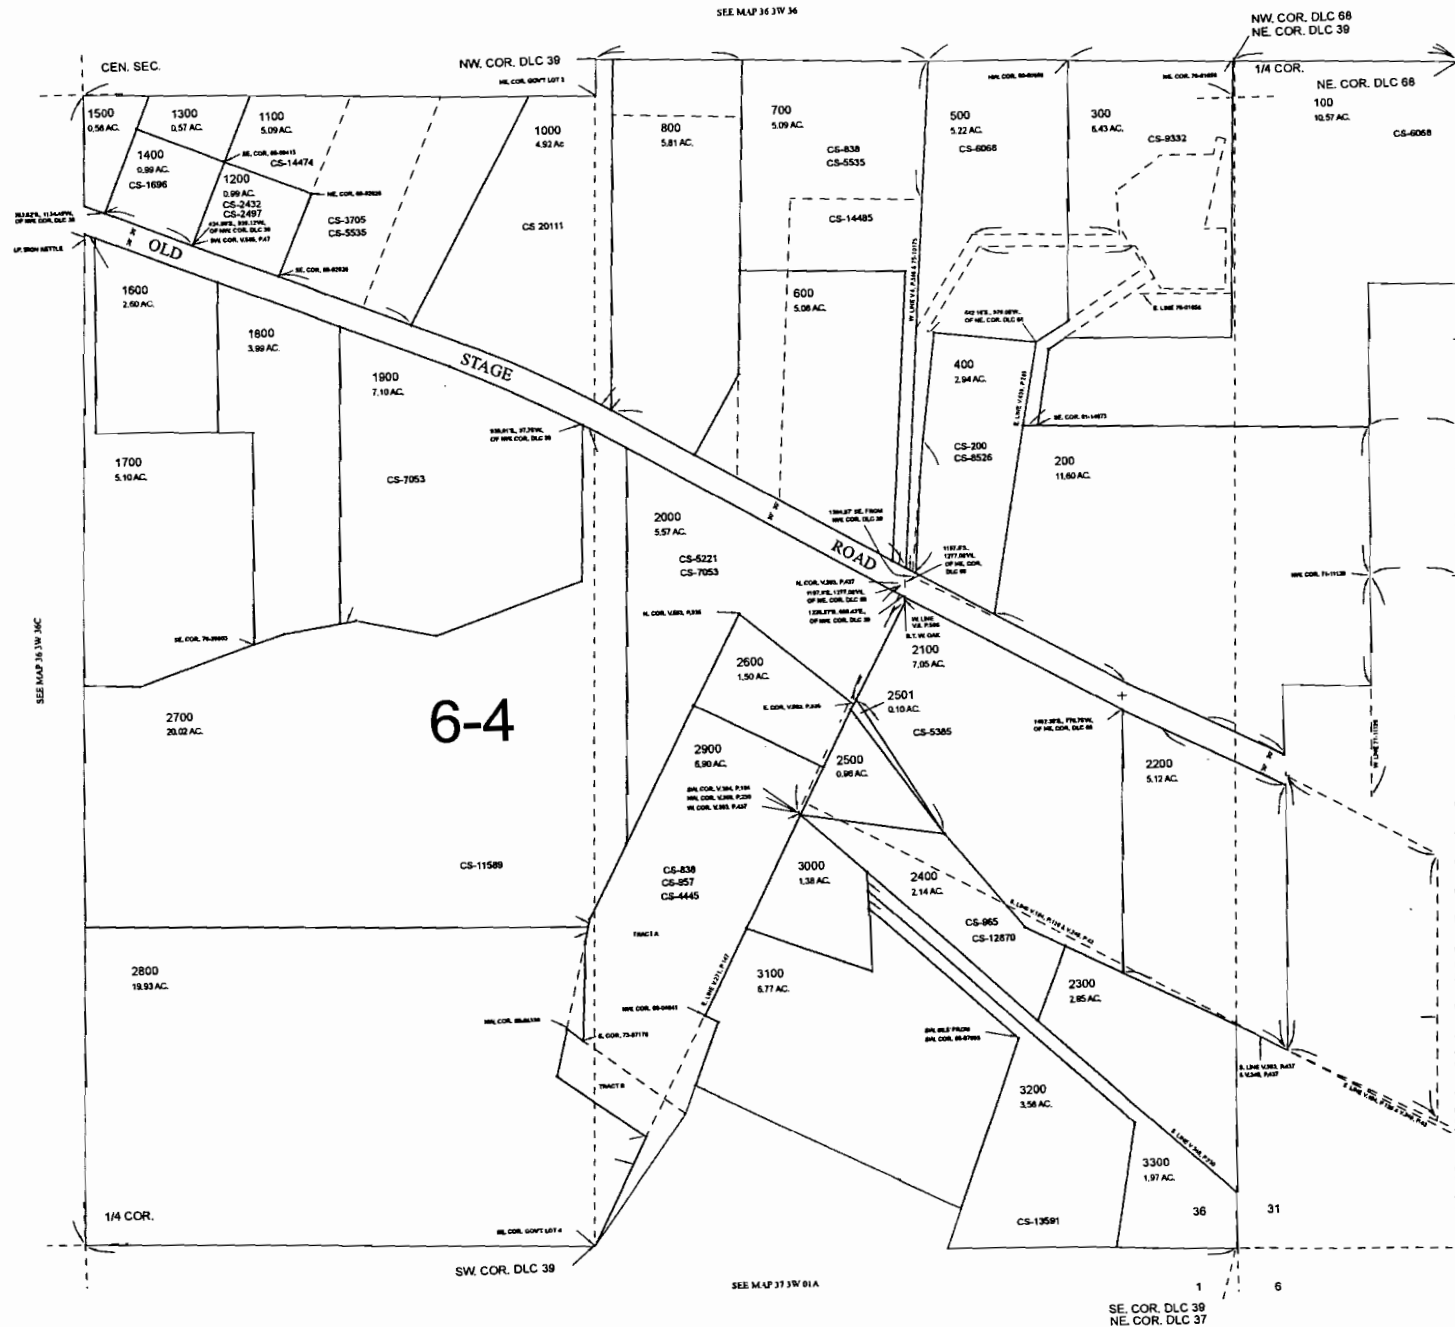

CANCELLED TAX
LOT NUMBERS:
900

RECEIVED

OCT 10 2008

WATER RESOURCES DEPT
SALEM, OREGON

36 3W 36D

DOR CONVERSION MAY 10, 2000
REV JULY 05, 2002