



center for orthopedics
& sports medicine

55 Coburg Road, Eugene, Oregon 97401
(541) 485-8111 • (541) 342-6379 Fax
(800) 866-7906 Toll-Free

Fax Cover Sheet

TO: <u>Herb</u>	FROM: <u>Christine Emmes</u>
COMPANY/FIRM NAME: <u>OR H2O Resources Dept</u>	
TEL NO: _____	
FAX NO: <u>503 986 0901</u>	DATE: <u>10/17/08</u>
	No. of pages including this cover <u>6</u>

Comments/Message:

Close Enough as to location of stream-
source of water diversion
May be a bit more NW - but

The information transmitted via this FAX message is intended only for the personal and confidential use of the designated recipient(s). The material may be a physician-patient communication and, as such, is privileged and confidential. If the reader of this message is not the intended recipient or an agent responsible for delivering it to the intended recipient, you are hereby notified that you have received this material in error and that any review, dissemination, distribution, or copying of the contents is strictly prohibited. If you have received this communication in error, please notify us immediately by telephone and return the material to us by mail. Thank You.

Approx Scale
1" = 300 Feet

Tract and Lot	Elk Lake Tract J, Lot 7
Legal Description	T18S, R8E, Sec 29
County Tax Lot	18 8 32C 100A8

SW 1/4
SW 1/4 SEC. 29 T.18S. R.8E.W.M.
ELK LAKE SUMMER HOMES
DESCHUTES COUNTY


Point of Diversion

Located from SW
Corner Section 29
1190 ft EAST
900 ft NORTH

30 29

31 32

00100

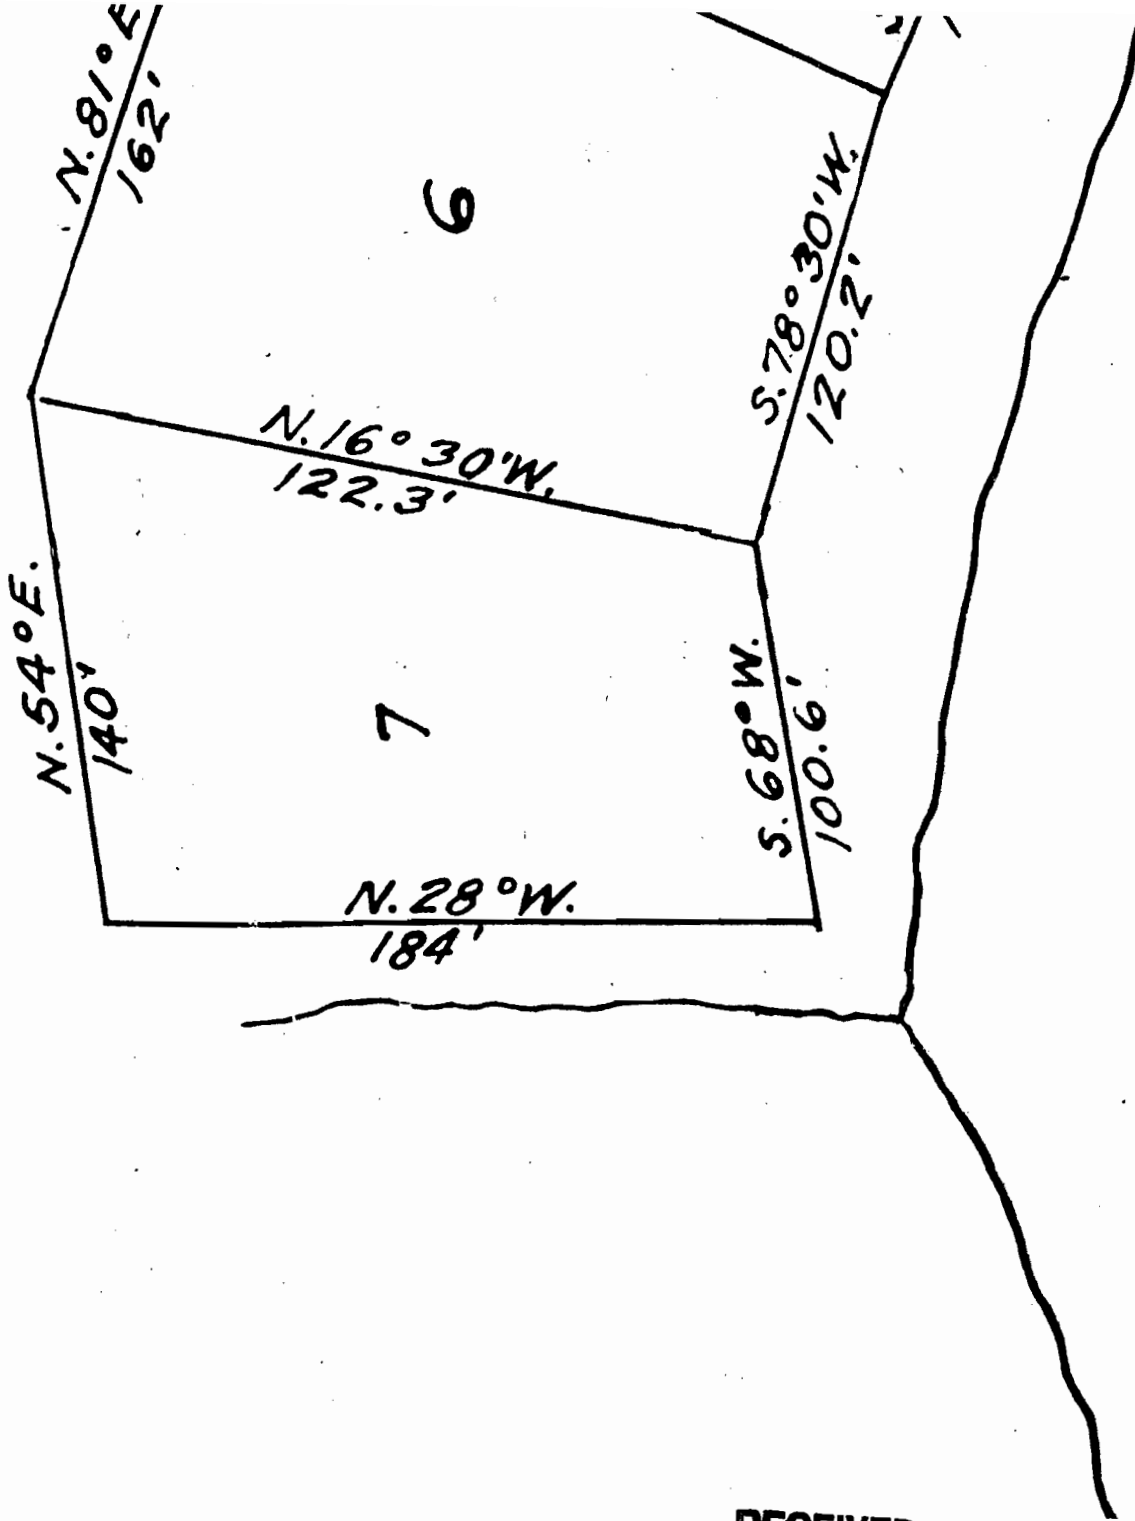

RECEIVED


OCT 06 2008

WATER RESOURCES DEPT
SALEM, OREGON



Tract and Lot	Elk Lake Tract J , Lot 7
Legal Description	T18S, R8E, Sec 29, NE1/4SW1/4
County Tax Lot	18 8 32C 100A8

SCALE (in feet)

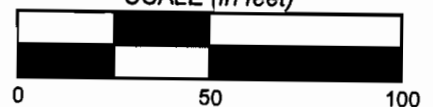

$$I'' = 200'$$

See Map 18 B

See Map 18.8

