

18

2720

SPECIAL USES AUTHORIZATION  
VICINITY MAP

TIMOTHY S. SWEET  
WATER TRANSMISSION LINE  
NE1/4 SW1/4, SECTION 19  
T. 17 S., R. 10 W., W.M.

MAPLETON RANGER DISTRICT  
LANE COUNTY OREGON

POINT of DIVERSION  
LOCATED FROM  
CENTER SECTION 19  
1350 ft NORTH  
1290 ft WEST

Approx  
from  
Center  
Section  
750

POINT of  
DIVERSION

Water  
Line

Sweet  
House  
Tax Lot #17

Hanson  
19-00-00200

RECEIVED

OCT 15 2008

WATER RESOURCES DEPT  
SALEM OREGON

McLeod

1:12000  
1 in = 1000 ft

I U S L A W

1710  
SPECIAL USES AUTHORIZATION  
VICINITY MAP

TIMOTHY S. SWEET  
WATER TRANSMISSION LINE  
NE1/4 SW1/4, SECTION 19  
T. 17 S., R. 10 W., W.M.

HAPLETON RANGER DISTRICT  
LANE COUNTY OREGON








U S L

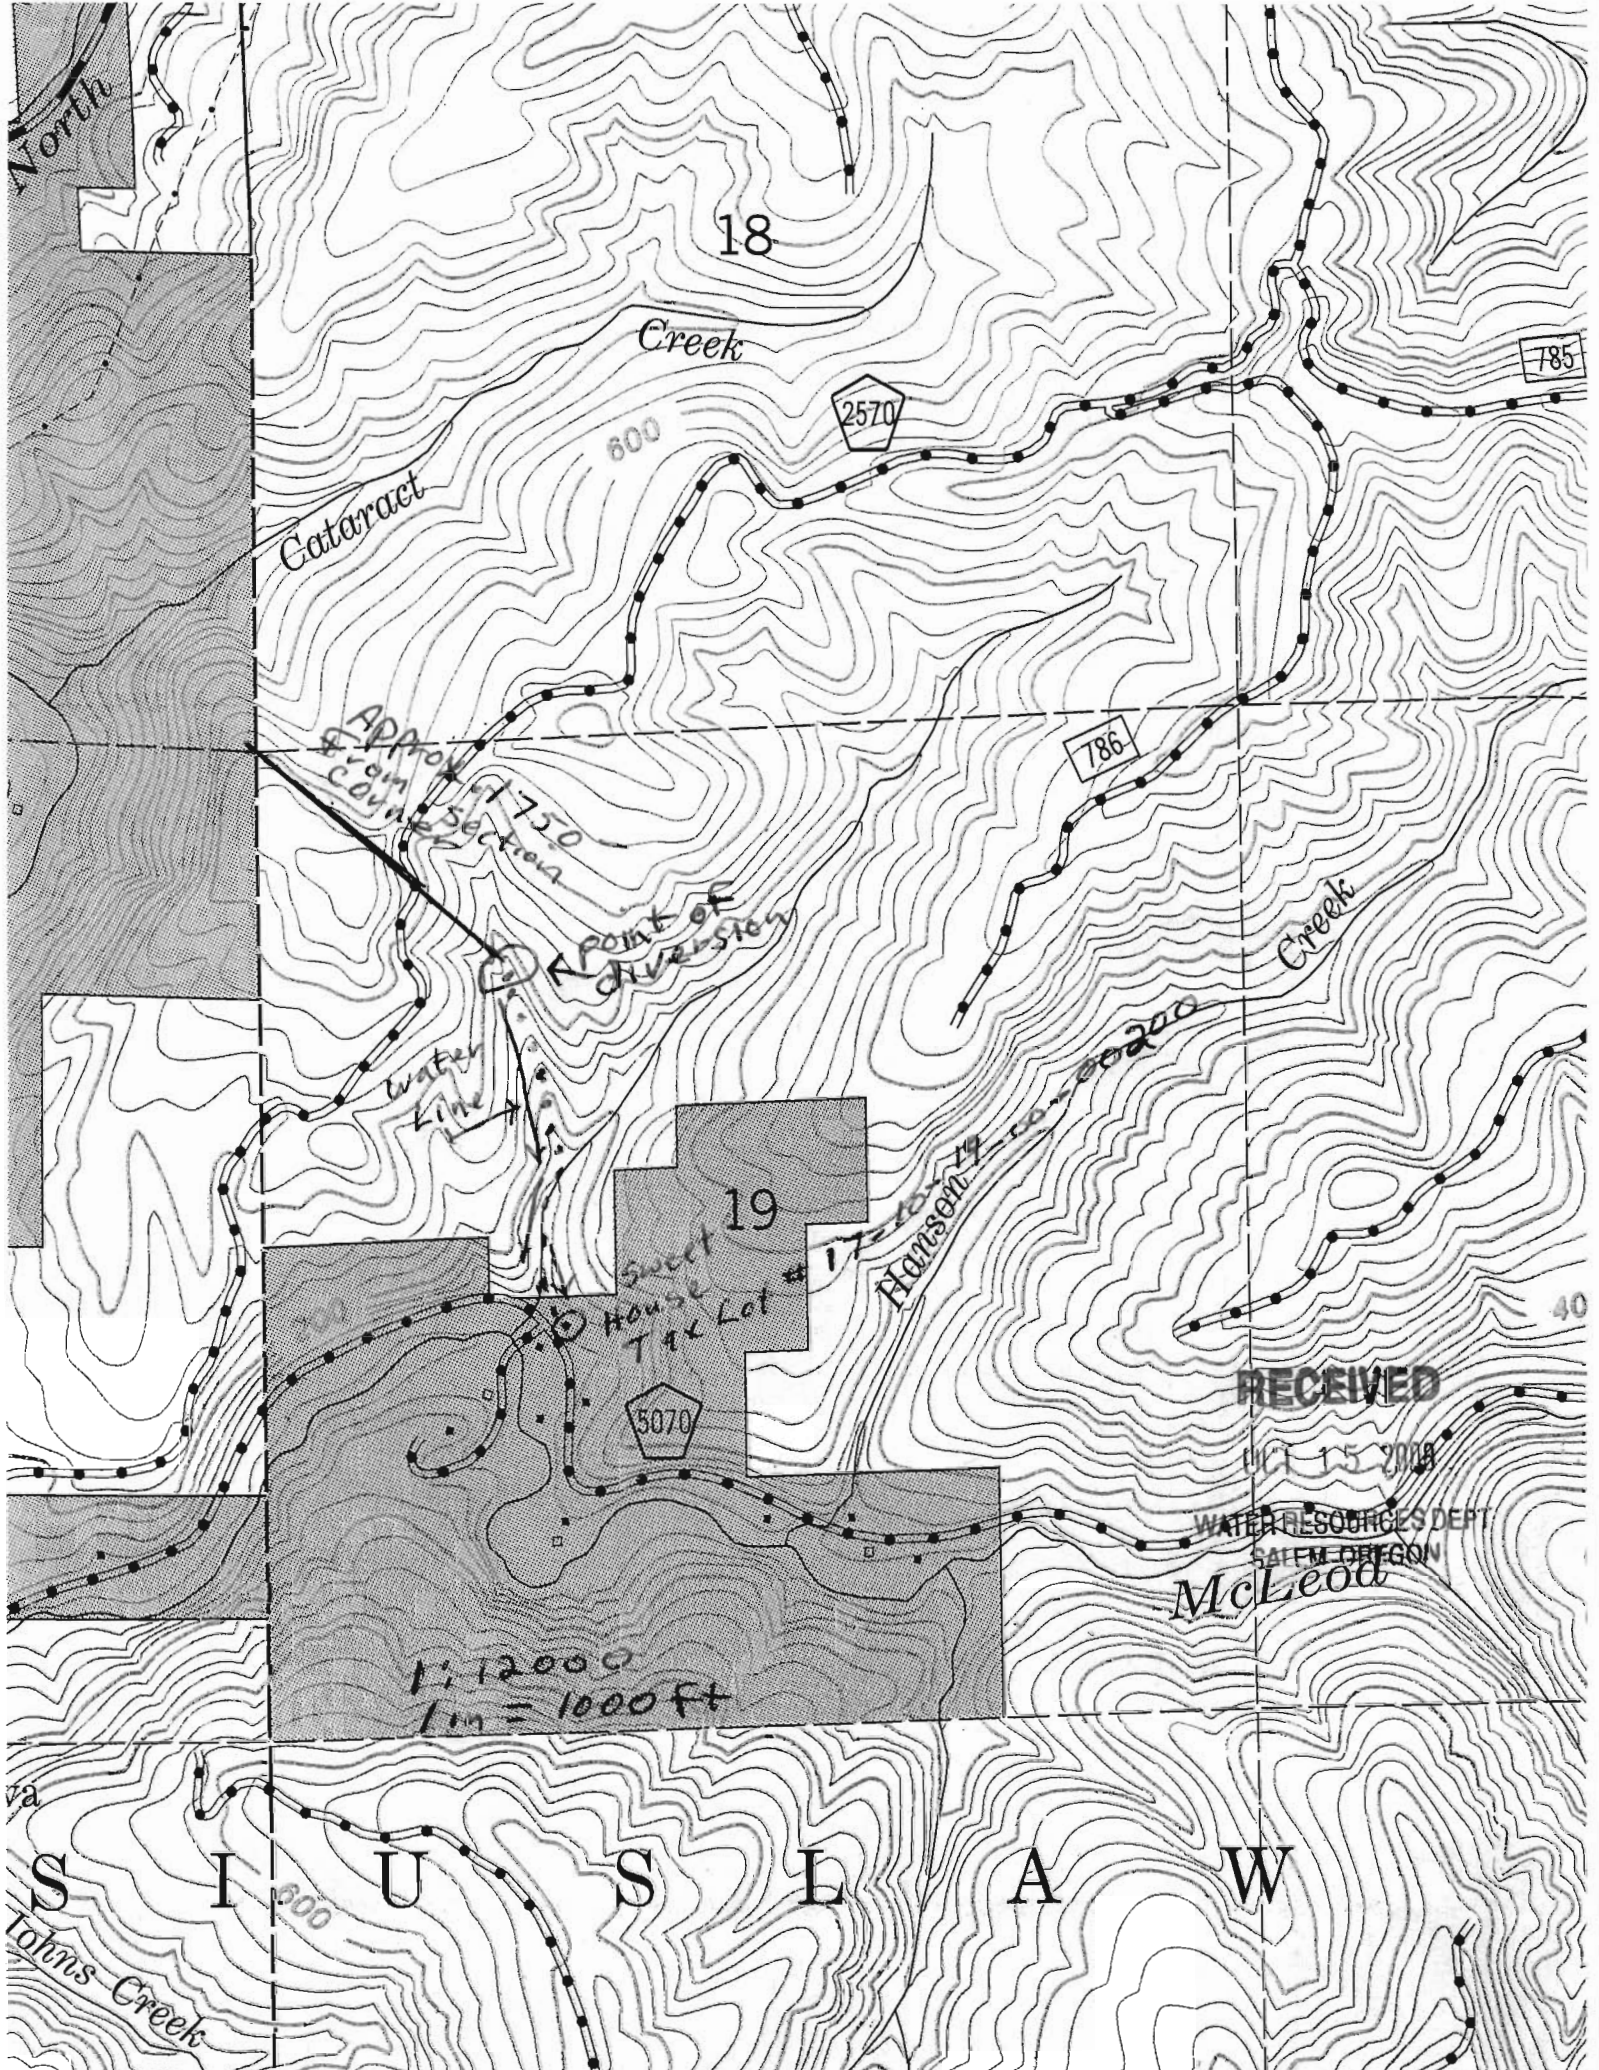

North

18

Creek

785

2570

600

Cataract

786

Approach  
from  
county  
section  
at 750

Point of  
diversion

Water  
line

Creek

Hansen  
17-16-14-10-20000

19

Sweet  
House  
Tax Lot #

5070

40

RECEIVED

OCT 15 2008

WATER RESOURCES DEPT  
SALEM OREGON

McLeod

1:12,000  
1" = 1000 ft

S I U S L A W

Johns Creek