



Image State of Oregon
© 2008 Tele Atlas
© 2008 Axiom
@ SPOT IMAGE

Google™

Pointer 44°53'46.03" N 119°50'40.73" W elev 2608 ft Streaming 100%

Eye alt 4977 ft

Gobet - Ponds

T 8S R 24E Section 3 Tax Lot 200



0 335 670 1,340 Feet

1 inch equals 400 feet

Center of Reservoir #1: 40 feet North and 1990 feet East of the SW corner of section 3
 Center of Reservoir #2: 235 feet North and 2050 feet East of the SW corner of section 3
 Center of Reservoir #3: 330 feet North and 2120 feet East of the SW corner of section 3
 Center of Reservoir #4: 100 feet North and 250 feet East of the SW corner of section 3
 Center of Reservoir #5: 50 feet North and 725 feet East of the SW corner of section 3

RECEIVED

OCT 20 2008


WATER RESOURCES DEPT.
 SALEM, OREGON




This product is for informational purposes and may not have been prepared for, or be suitable for legal, engineering, or surveying purposes. Users of this information should review or consult the primary data and information sources to ascertain the usability of the information.

SCALE $\frac{1}{4}" = 10'$

Township 8S
Range 24E
Section 3
SW/SW
TAX LOT 200

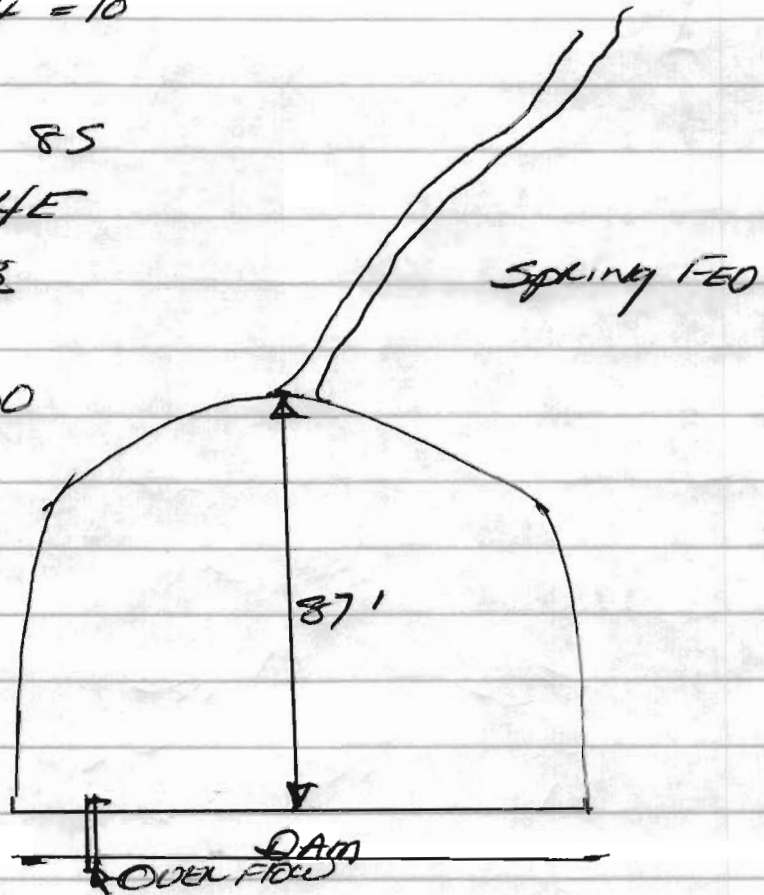

.95 ACRE FEET

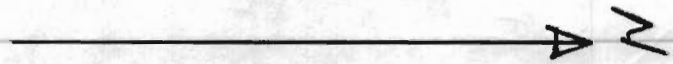

RECEIVED
OCT 20 2008
WATER RESOURCES DEPT.
SALEM, OREGON