


RECEIVED
OCT 20 2008
WATER RESOURCES DEPT.
SALEM, OREGON

T 40S, R 14W, W. M.,
SECTION 1
TAX LOT 307

ADJUSTED APPROX.
CORRECTED SCALE
1" = 800'

SEE MAP 39S 14W

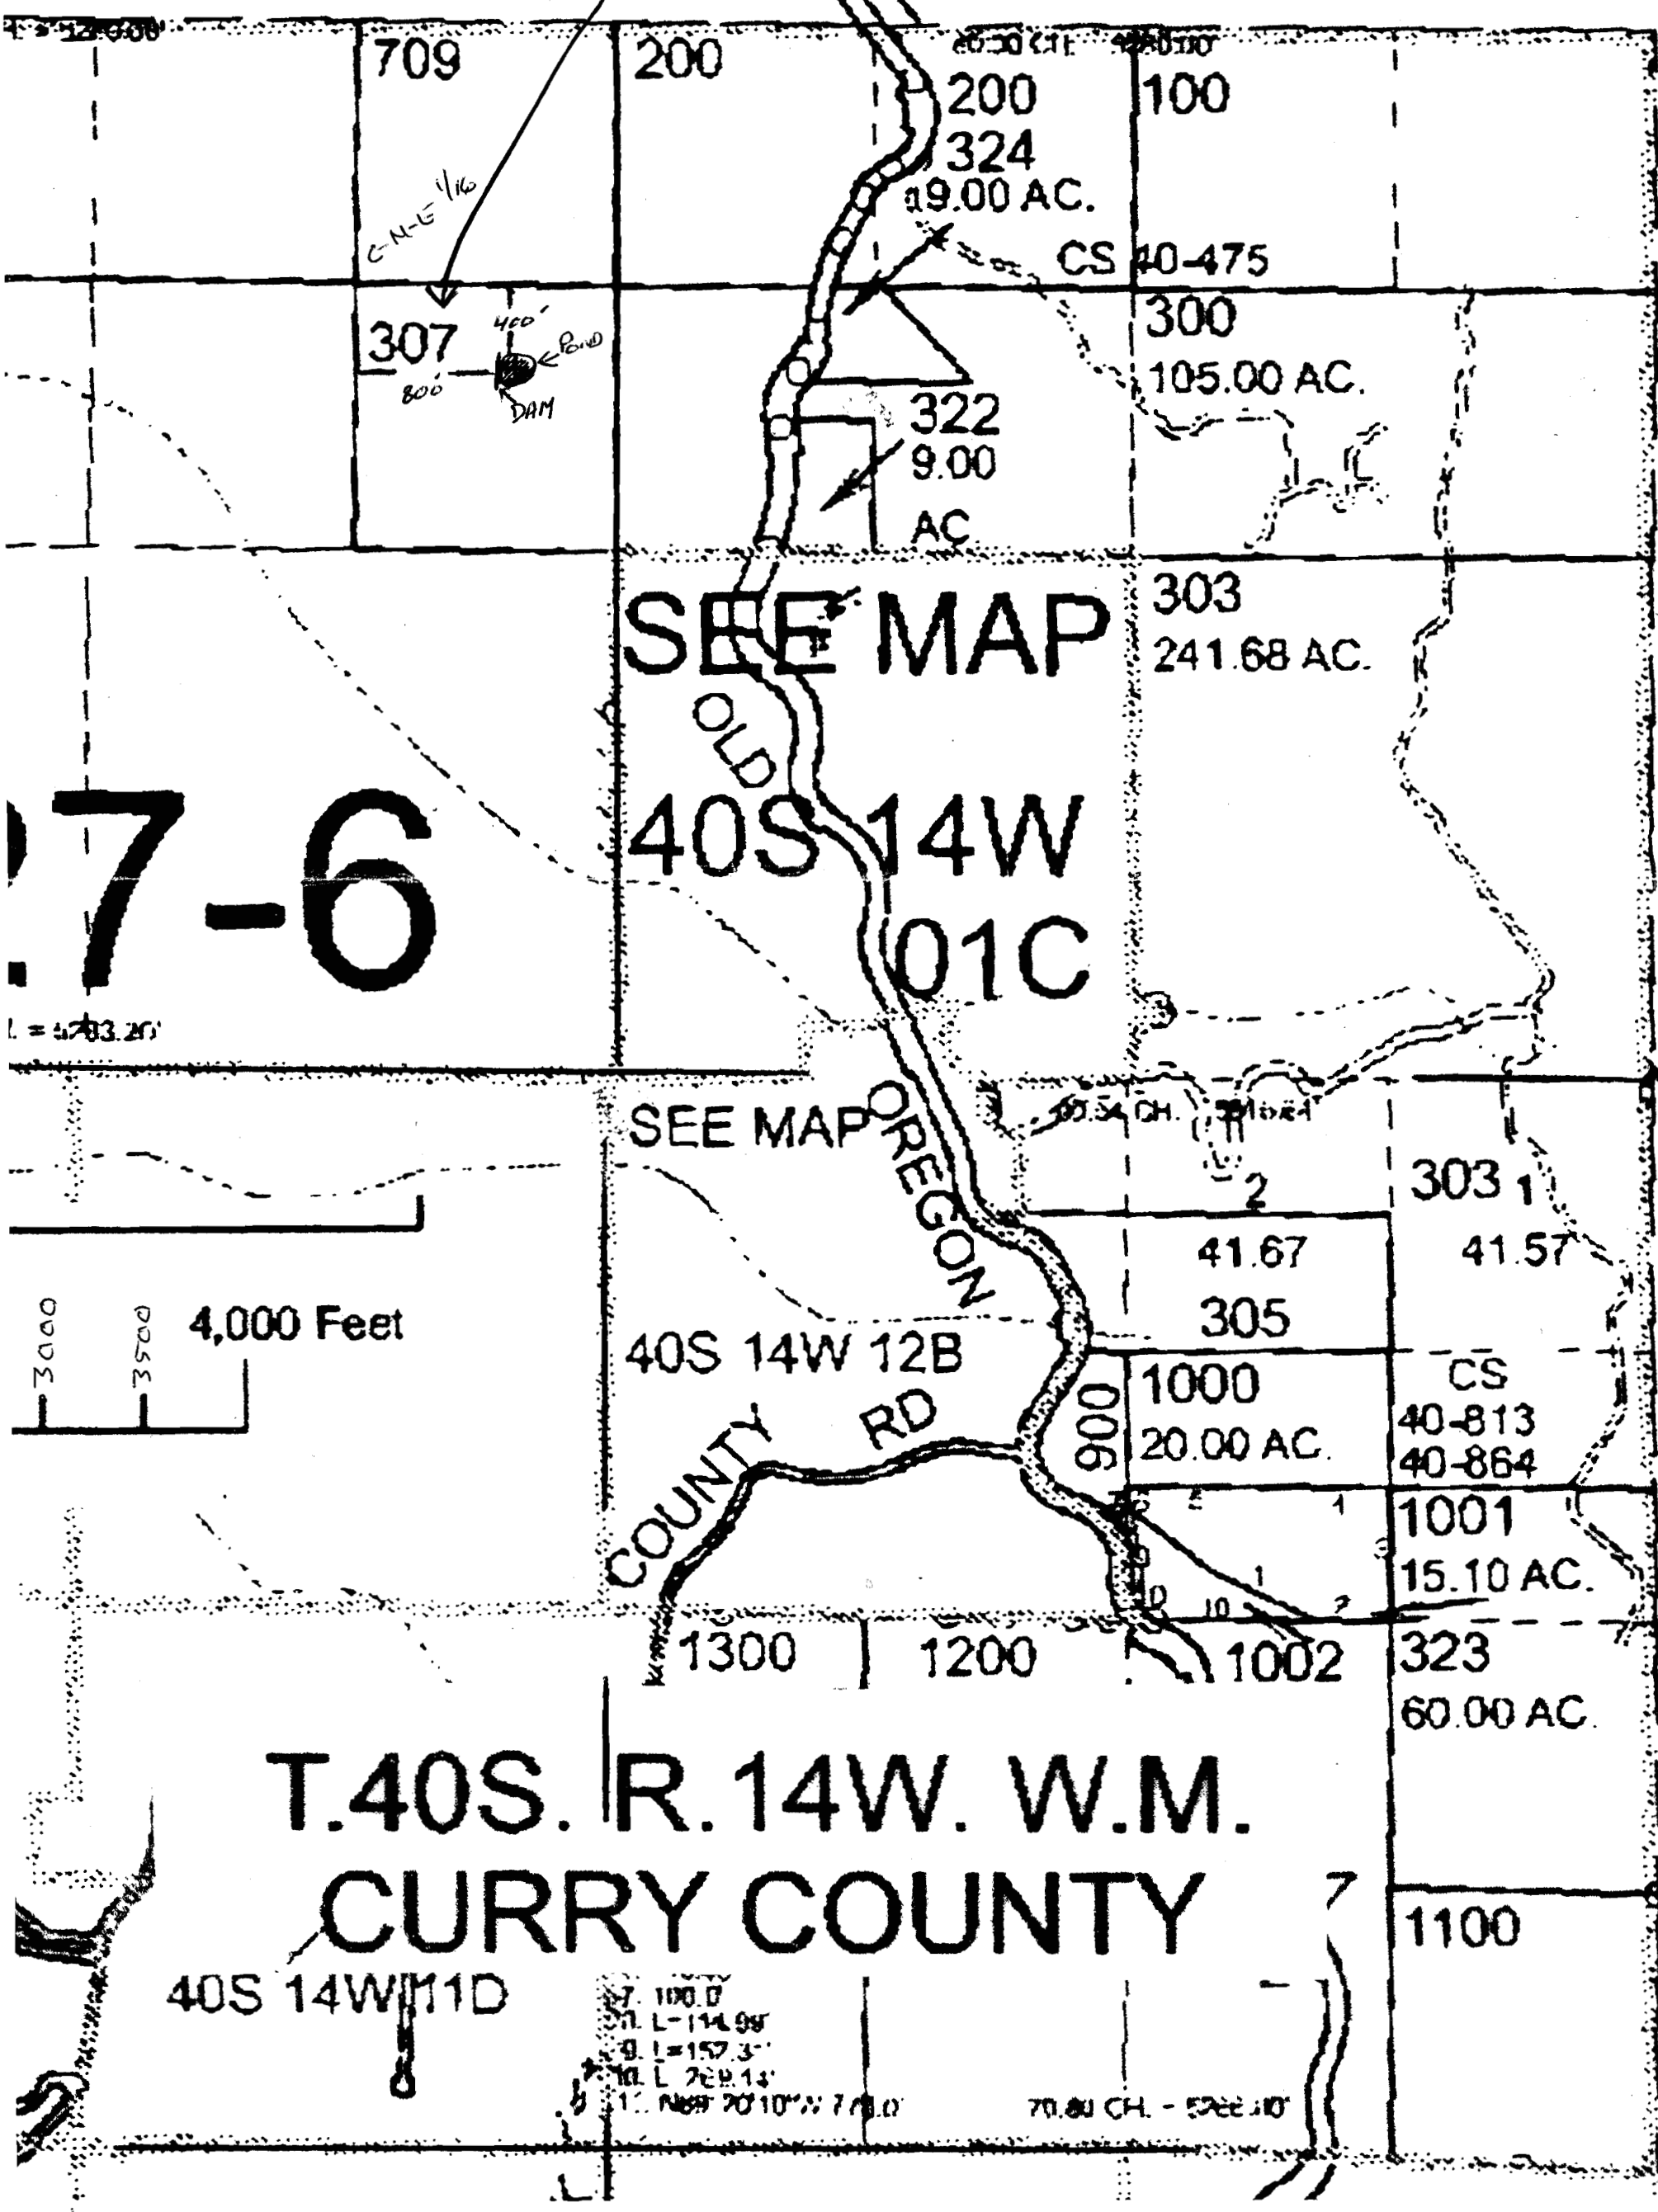

Reservoir (Pond) location
DAM.



T 40 S, R 14 W, W.M.,
SECTION 1
TAX LOT 307

1" = 400ft

RECEIVED
OCT 20 2008
WATER RESOURCES DEPT.
SALEM, OREGON