


Sec 14 T23S, R6E W.M. Unsurveyed

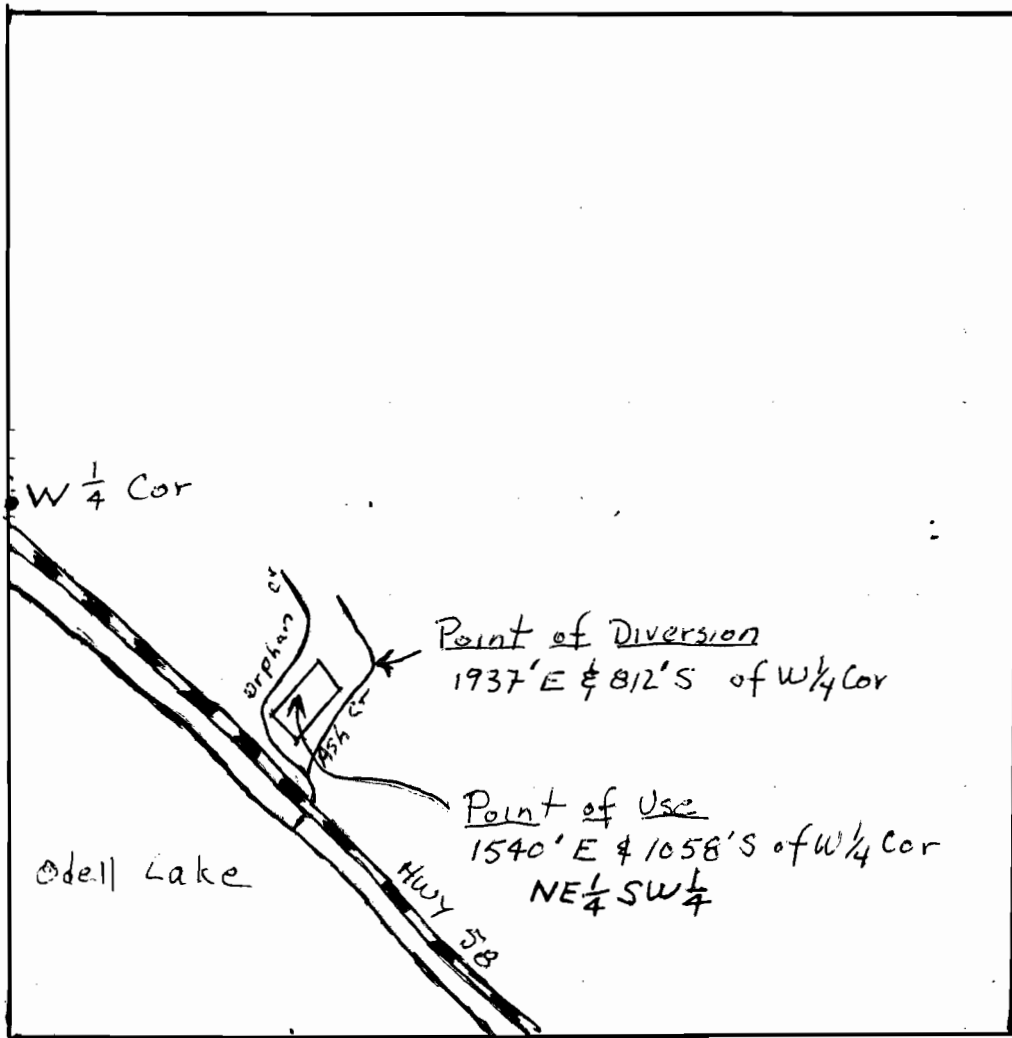

Scale: 1" = 1000'


RECEIVED

OCT 21 2008

WATER RESOURCES DEPT
SALEM, OREGON

Application Map for Louis A Blaser
Recreation Residence Lot G-1B USFS
Odell Lake. Str address 22,433 Hwy 58

2720
BLASER, LOUIS A. & CE
WATER TRANSMISSION
LOT 18, Tract G-1, Odell Lake

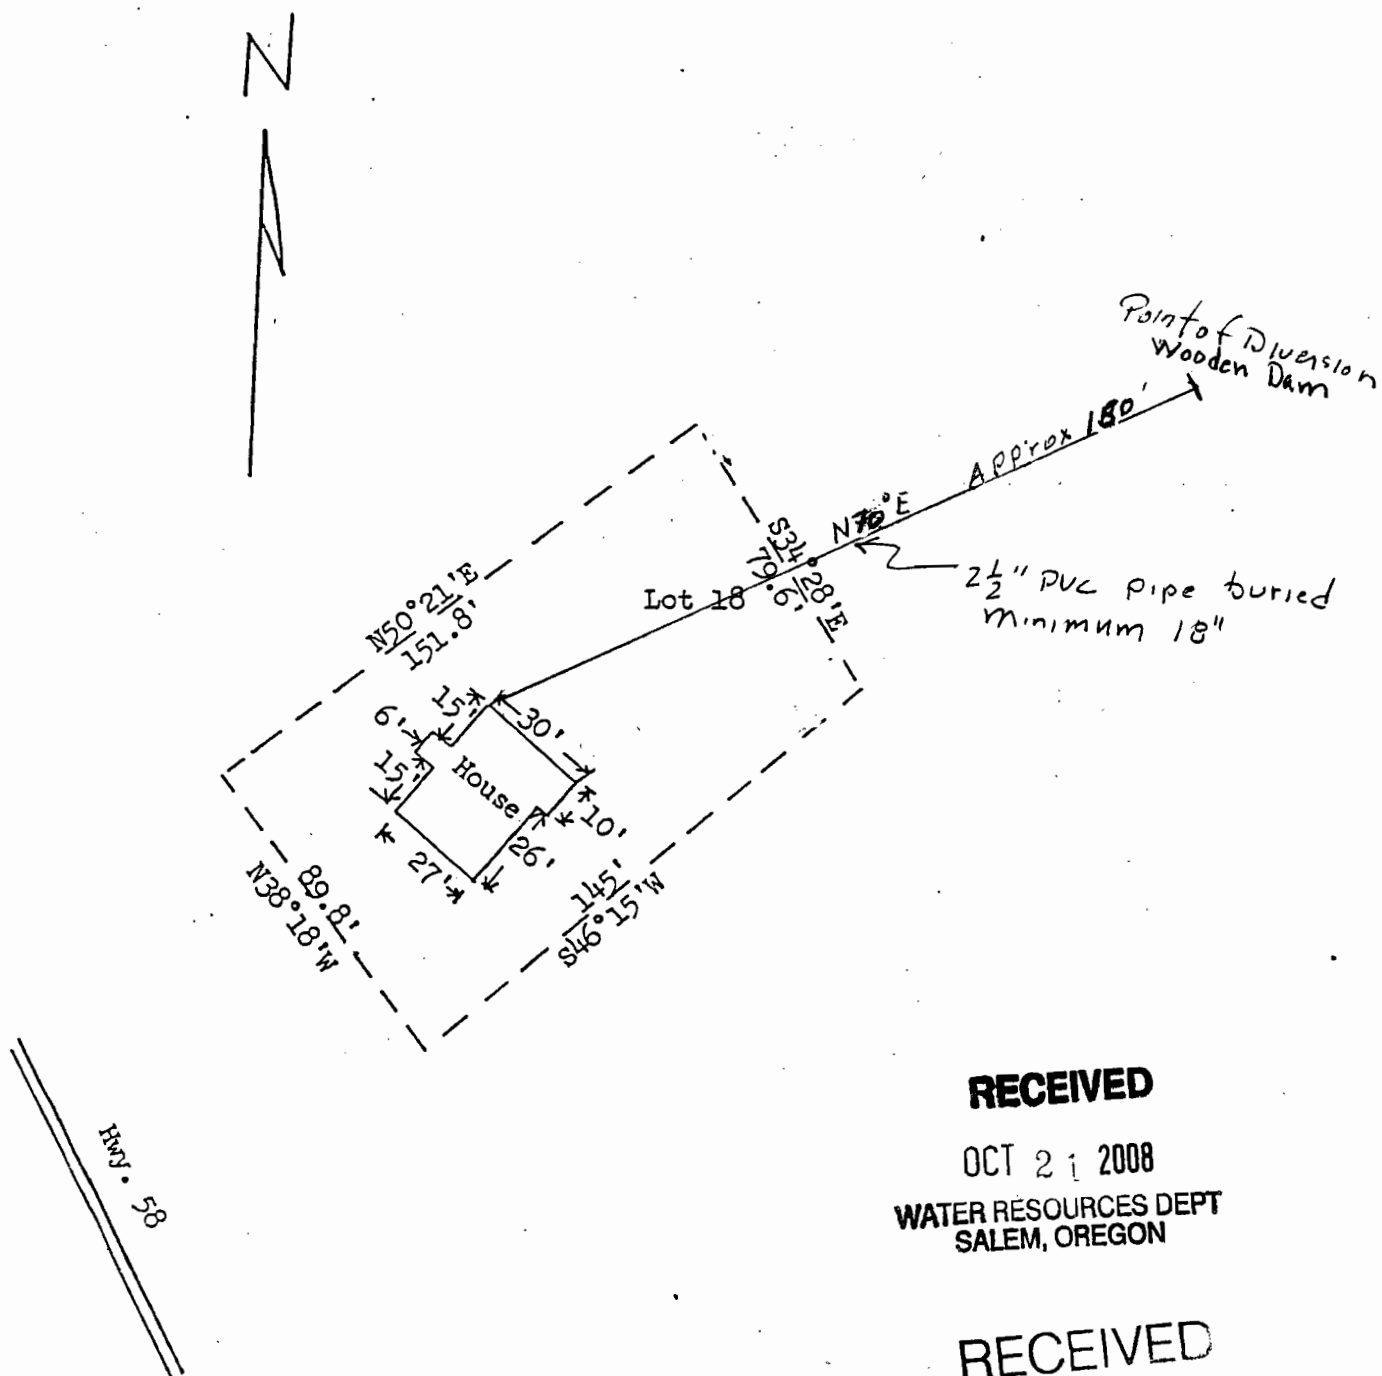

NOTE: Lot corners couldnot be located.

SCALE: 1" = 50'

RECEIVED

OCT 21 2008

WATER RESOURCES DEPT
SALEM, OREGON

RECEIVED

OCT 14 2008

WATER RESOURCES DEPT.
SALEM, OREGON

S.G.E. 10-9-67

Water System Revised
10-01-08

T.23S. R.06E. W.M.
KLAMATH COUNTY

DESCHUTES COUNTY

