


RECEIVED



WATER RESOURCES DEPT
SALEM, OREGON

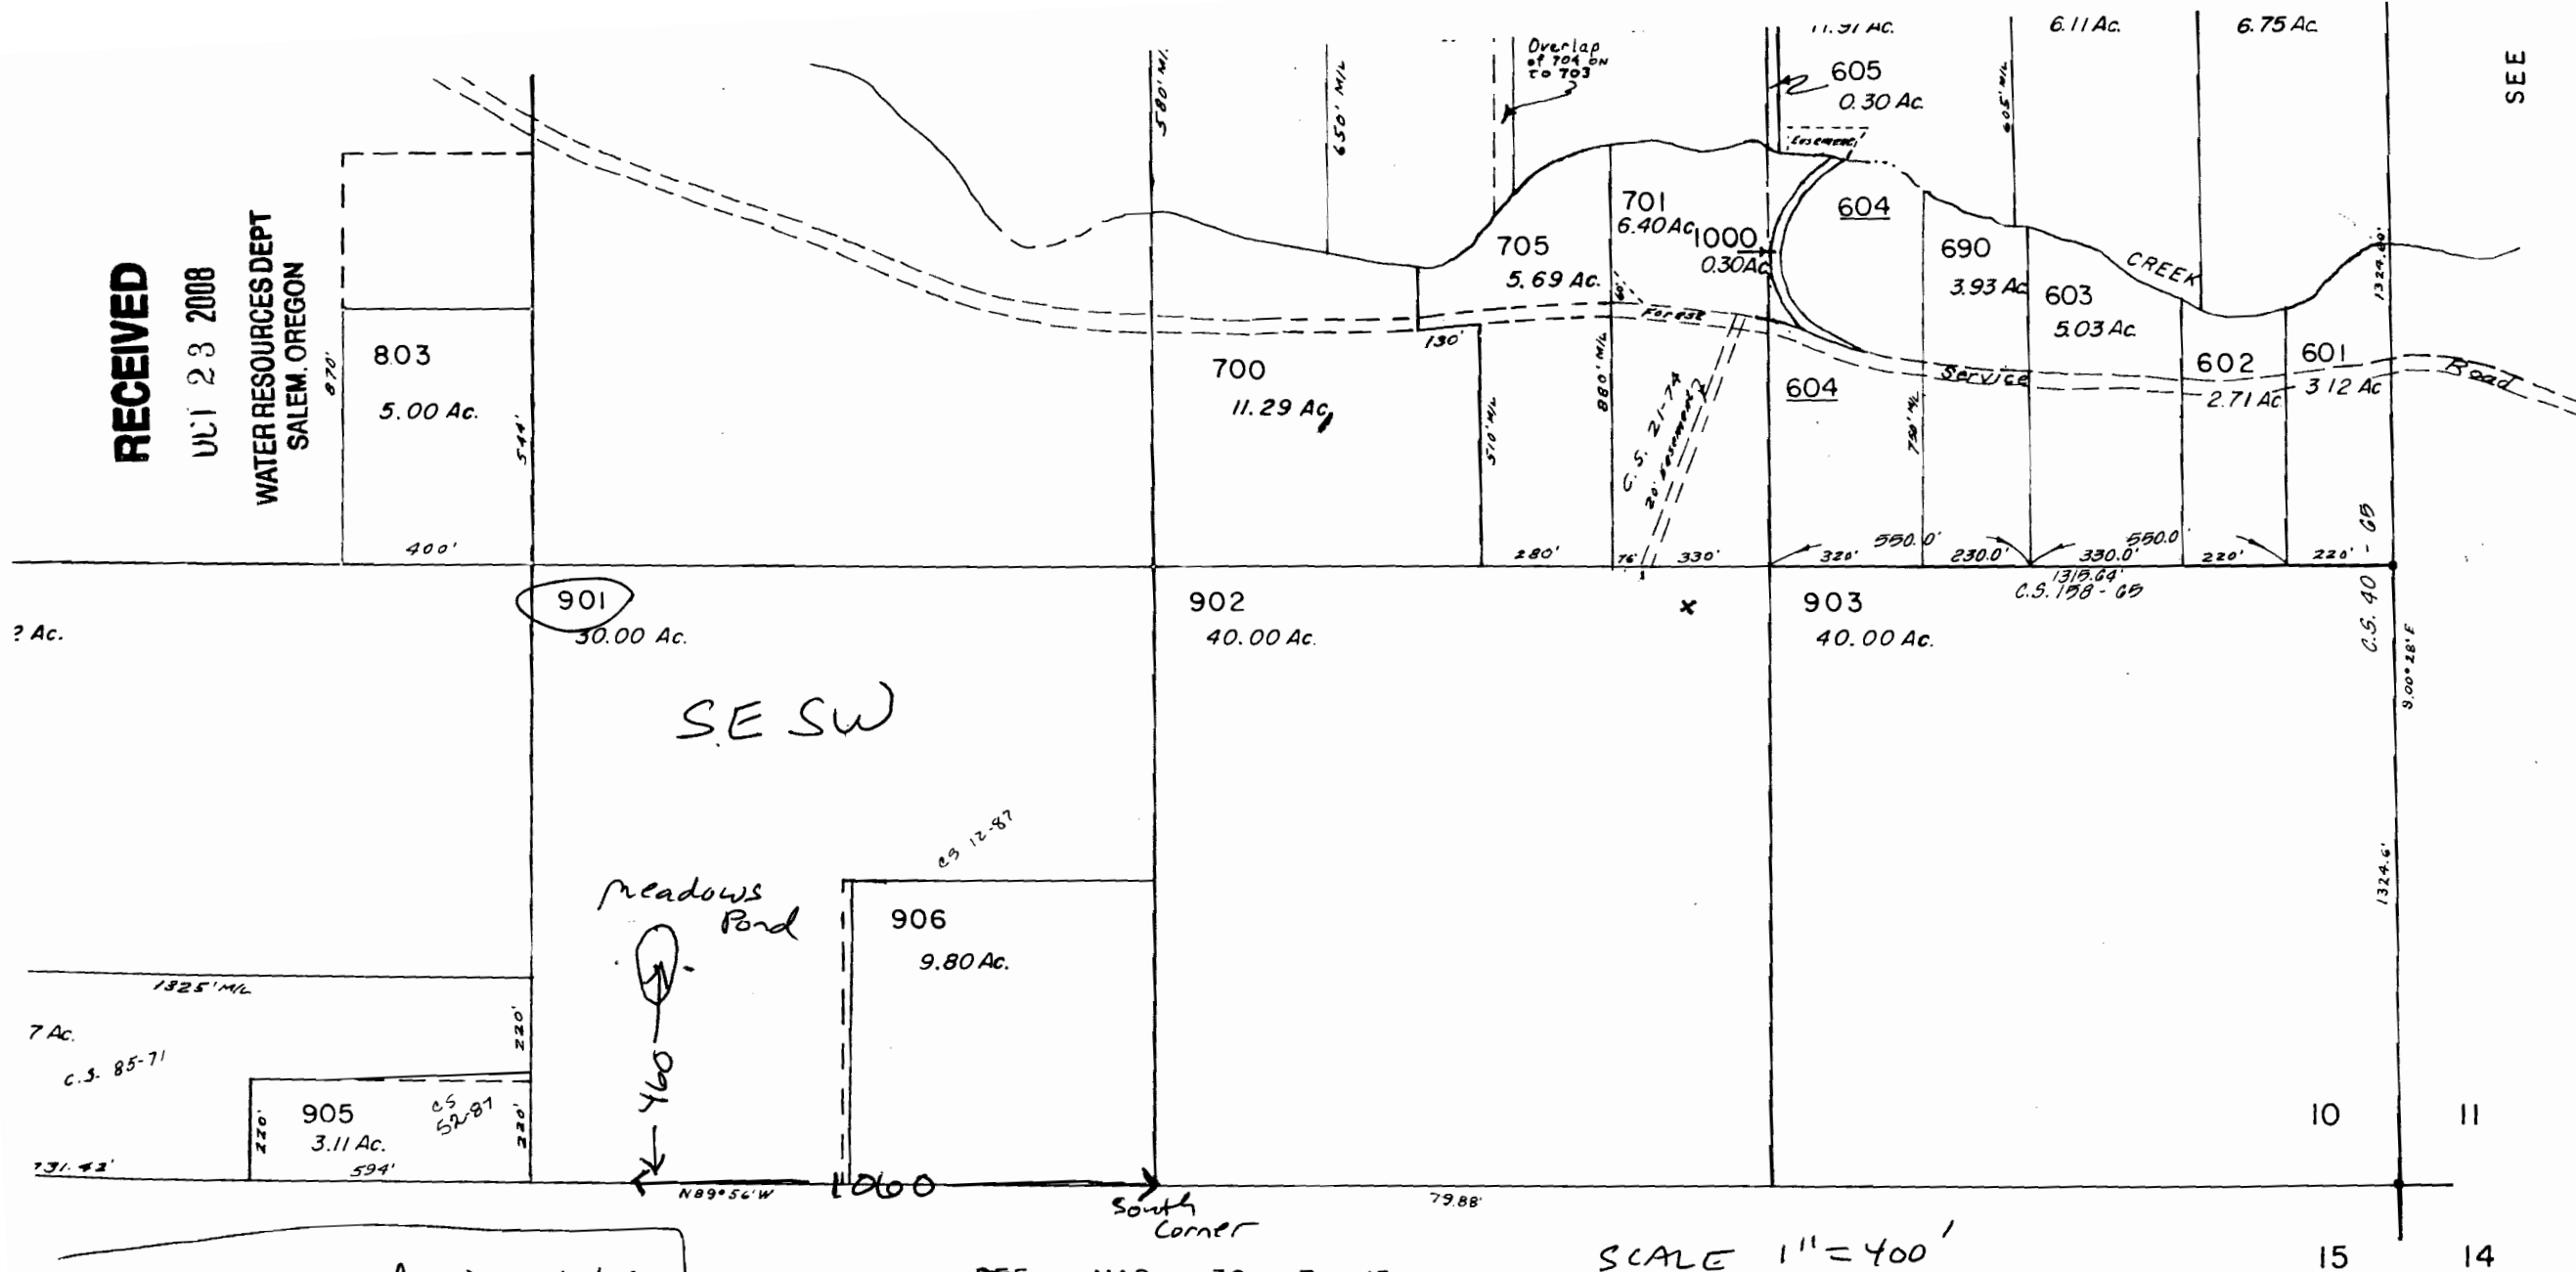

meadows pond is 1060
feet west and
460 feet north
from the south
corner of
T36S R7W Sec 10

Sec 10 T36S R7W

SCALE 1" = 400'

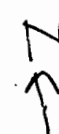

This map was prepared for
assessment purpose only.

SEE MAP 36 7

3 2

RECEIVED

JUL 23 2008

WATER RESOURCES DEPT
SALEM, OREGON