

# Papineau

## T 1S R 25E Section 27 Tax Lot 400, 500, 600



0 175 350 700 Feet

1 inch equals 200 feet

★ Well: location - 1700 feet West and 1470 feet North from the SE corner of Sec 27

--OWRD GIS jtc, WMDistrict21: Papineau\_080925

RECEIVED

OCT 27 2008

WATER RESOURCES DEPT  
SALEM, OREGON



RECEIVED

OCT 06 2008

WATER RESOURCES DEPT  
SALEM, OREGON

This product is for informational purposes and may not have been prepared for, or be suitable for legal, engineering, or surveying purposes. Users of this information should review or consult the primary data and information sources to ascertain the usability of the information.



THIS MAP WAS PREPARED FOR  
ASSESSMENT PURPOSE ONLY

NE1/4 SE1/4 SEC. 27 T.15. R.25E. W.M.  
MORROW COUNTY

IS 25 27DA  
LEXINGTON




SEE MAP IS 25 27DB

SEE MAP IS 25 27DC

SEE MAP IS 25 27DD

SEE MAP IS 25

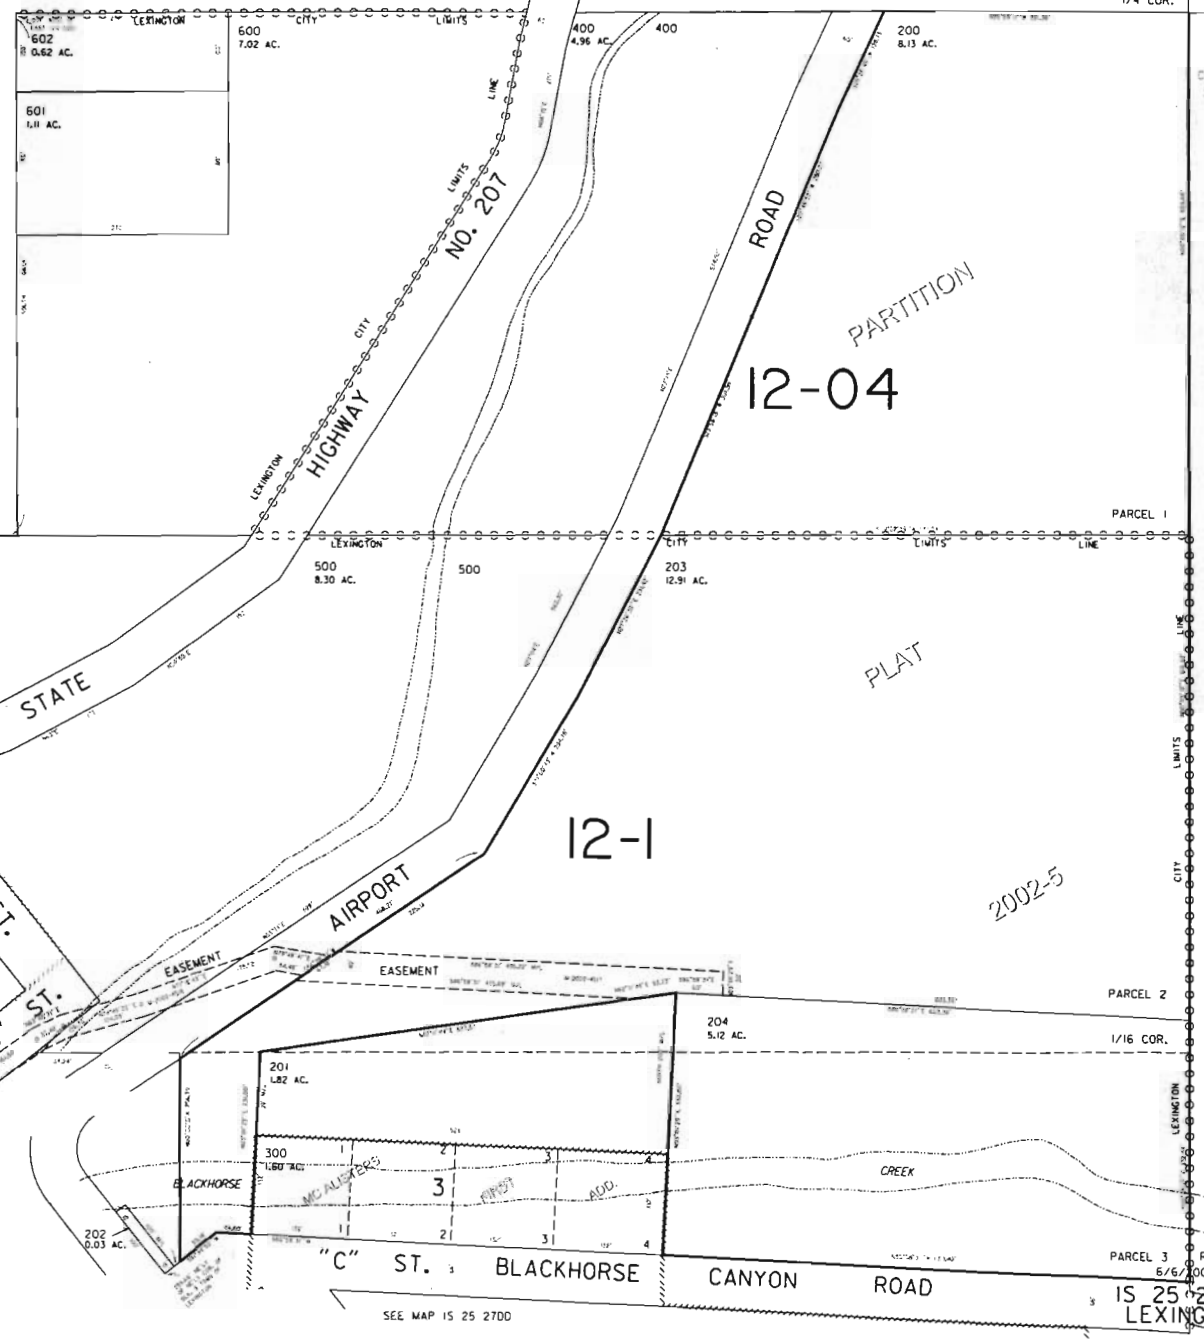

CANCELLED  
NUMBERS  
T.L. 100

2002-5

Revised  
5/6/2006, DLW  
IS 25 27DA  
LEXINGTON

11/20/04

08/11/01

05/11/01

05/11/01