

SECTION PLAT


Section 32

Township 23-S

Range 33-E

County of Harney State of OREGON

NORTH

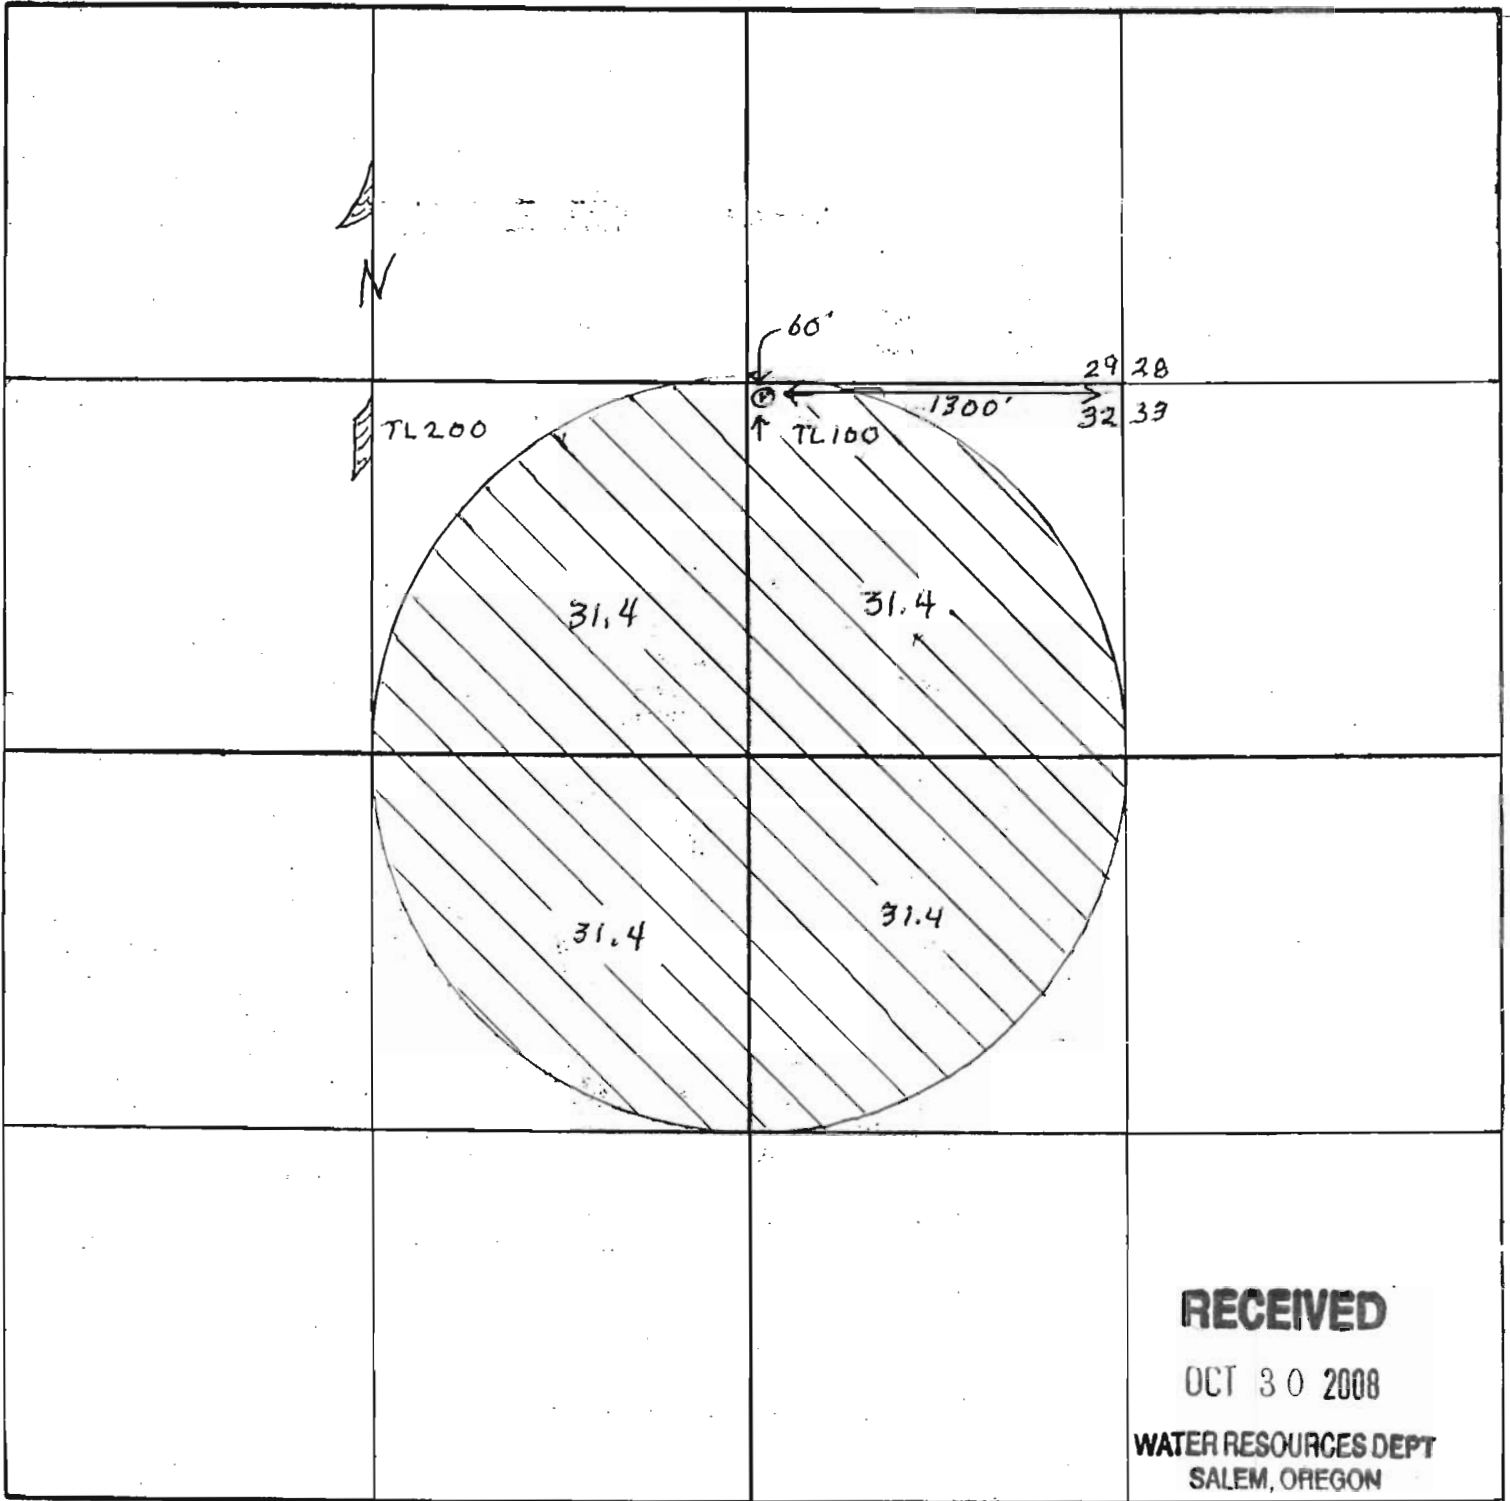

8

Remarks scale - 8" = 1 mile - 660' -