

SECTION PLAT


Section 10 Township 23-S Range 33-E

County of Harney State of OR

NORTH



TL 1600

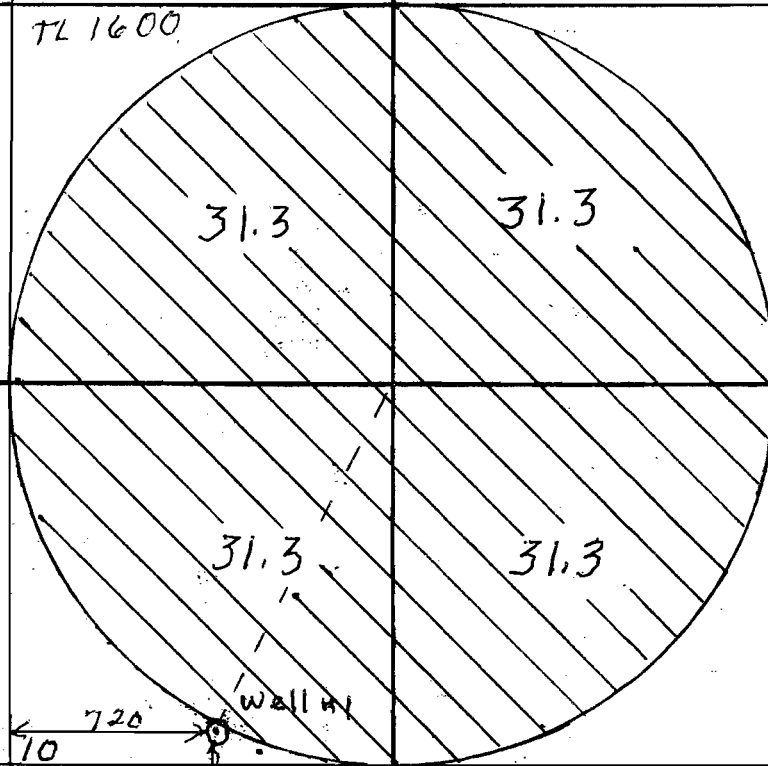

RECEIVED

OCT 30 2008

WATER RESOURCES DEPT
SALEM, OREGON

RECEIVED

OCT 30 2008

WATER RESOURCES DEPT
SALEM, OREGON

S

Remarks scale - 8" = 1 mile - 660' -