


WORK
COPY

SECTION PLAT

Section 2 Township 25S Range 32 1/2 E
County of Harney State of Oregon

NORTH

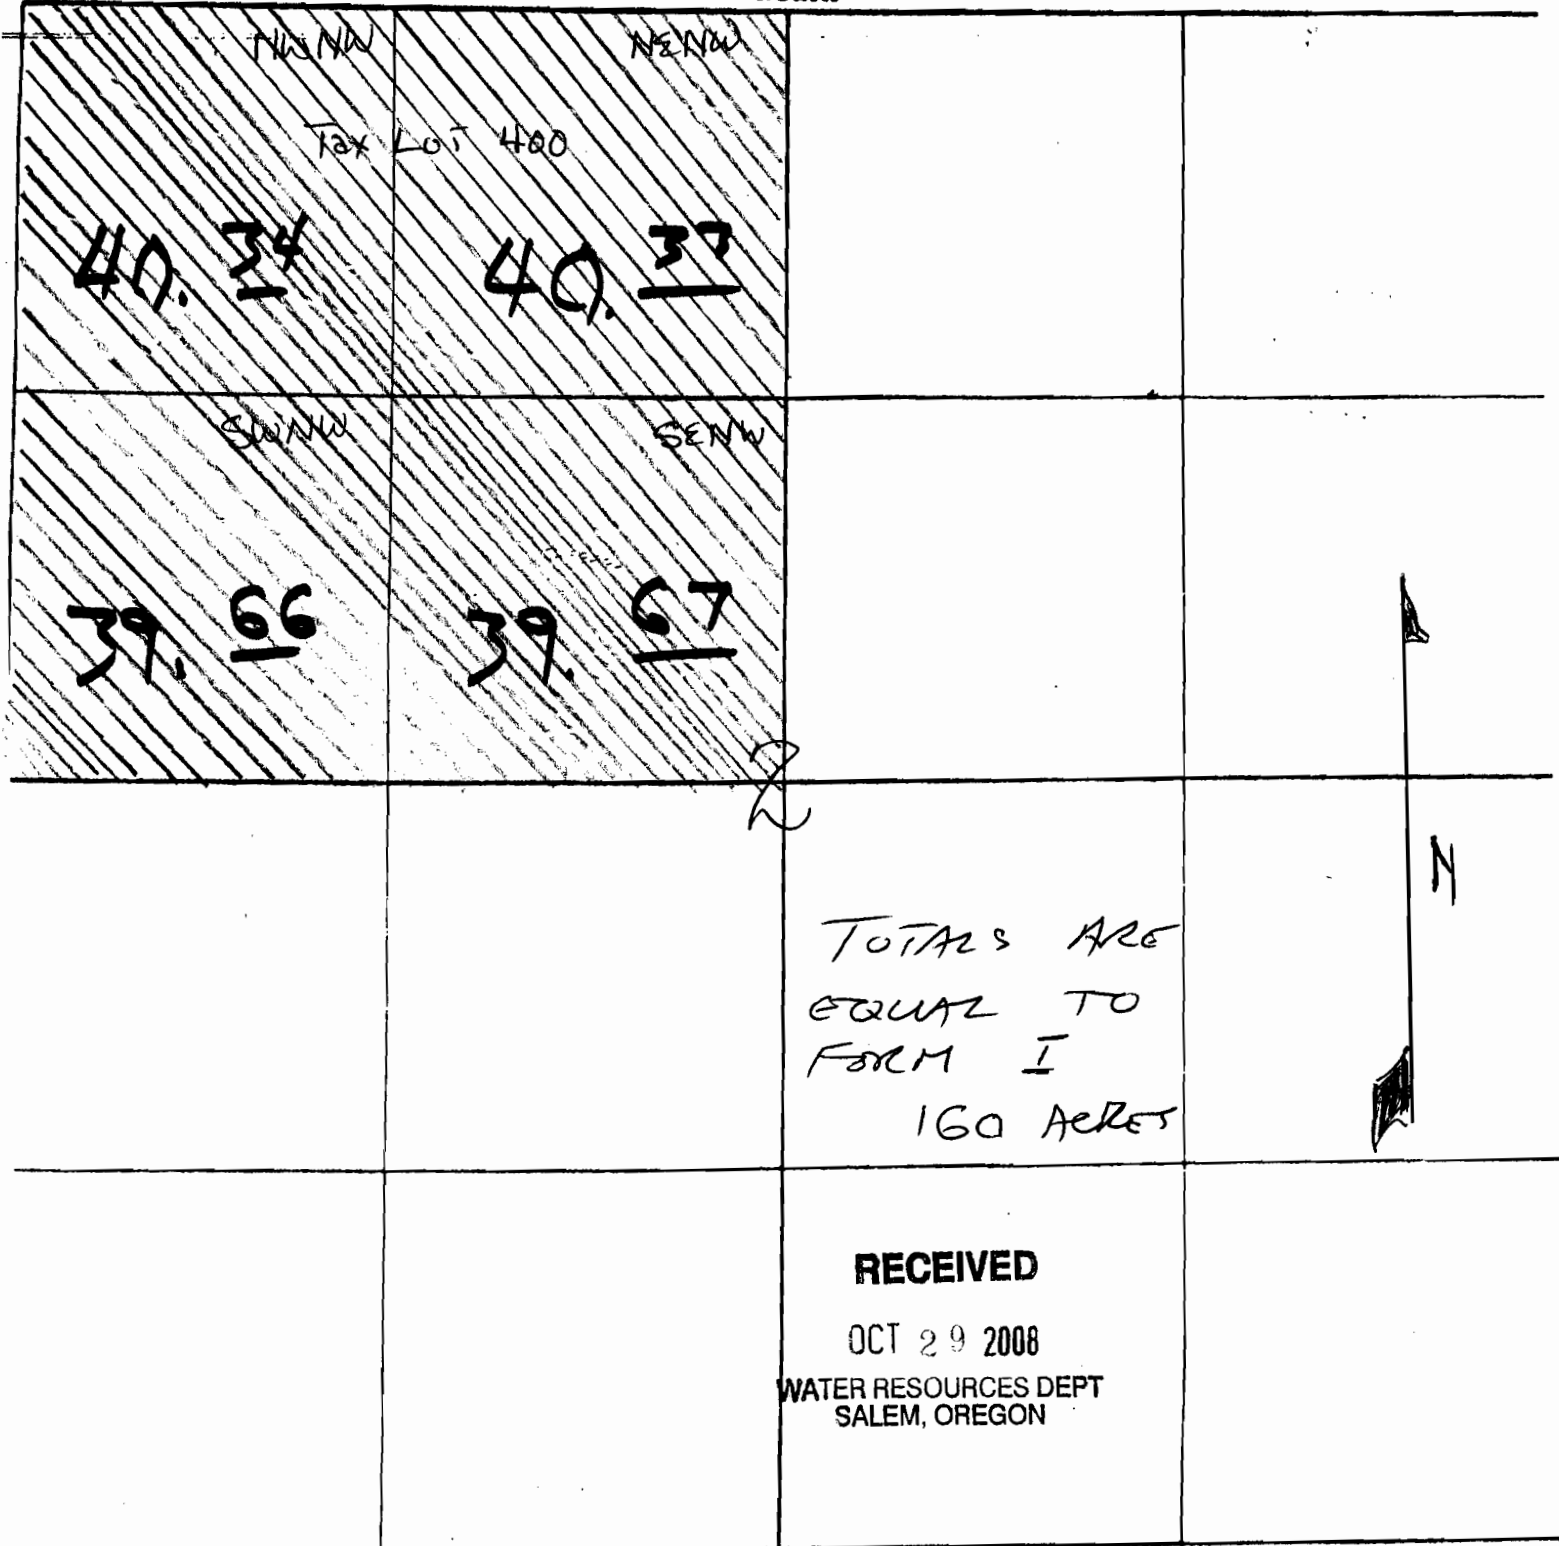


8" - 1 mile

Dave Miller

SECTION PLAT

Section 2 Township 25S Range 32 1/2 E
County of Harney State of Oregon

NORTH

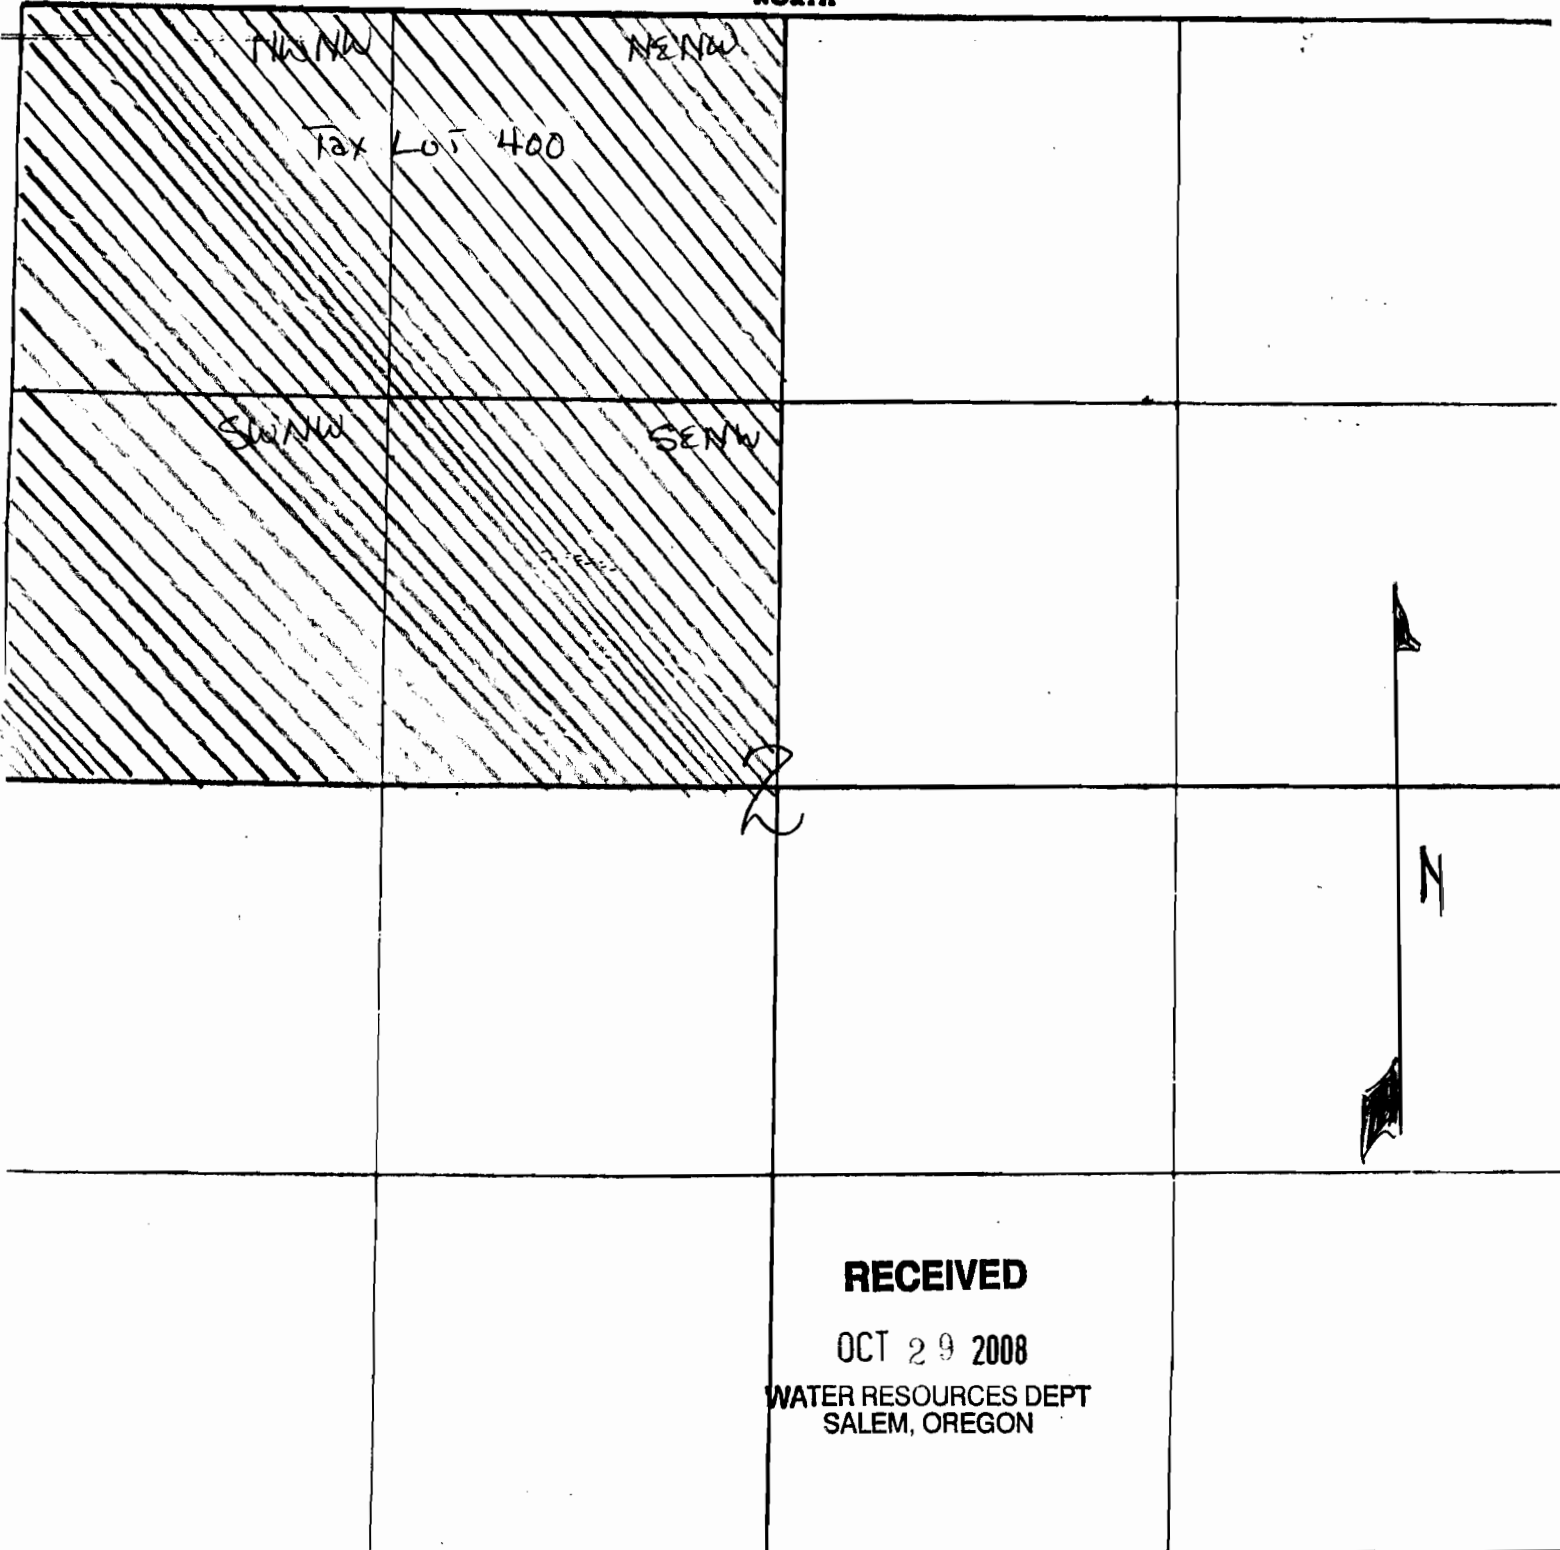

8" - 1 mile


Dave Miller

RECEIVED

OCT 29 2008

WATER RESOURCES DEPT
SALEM, OREGON

EE MAP 24S 32VE

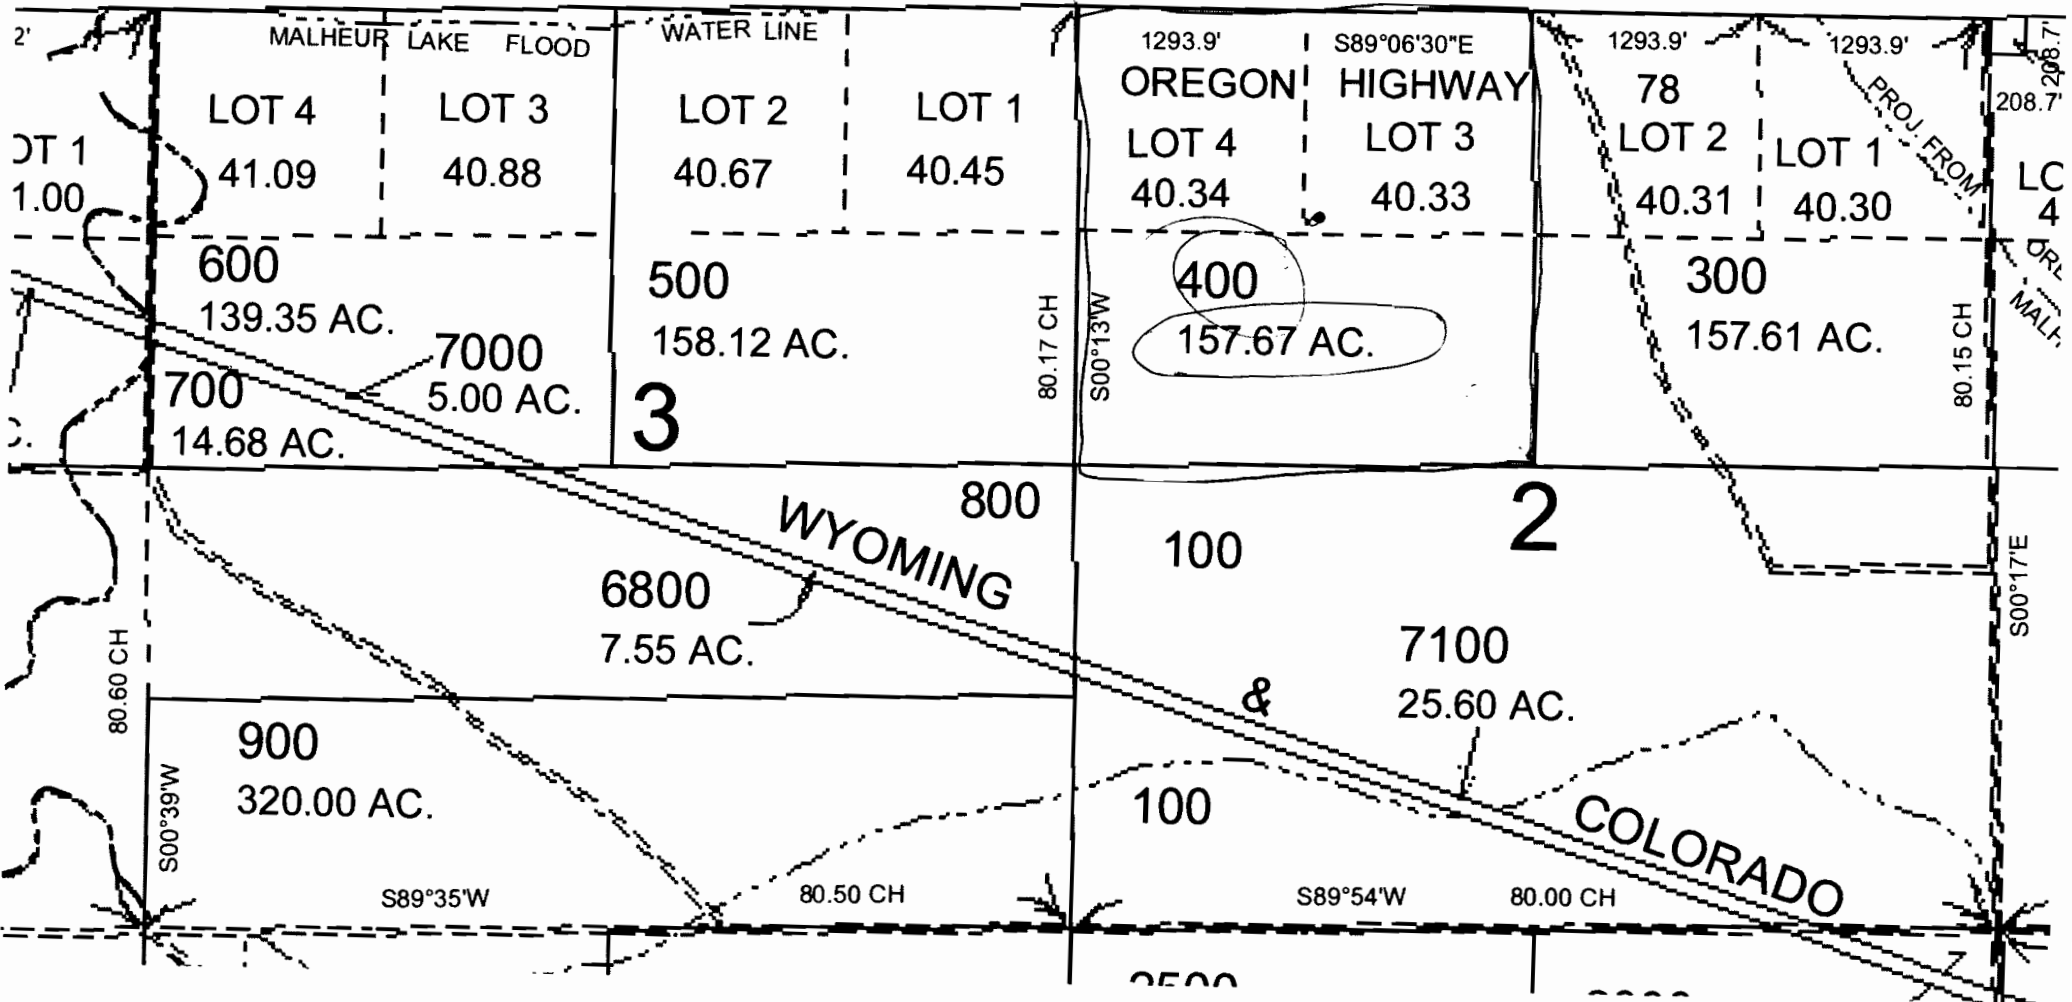

ANDERSON VALLEY SUPJ

WRD 1ST FL

5144939545

10/30/2008 15:09

10/30/2008 09:35

00.17 CH

5039860901

1293.9' | S89°06'30"E
OREGON HIGHWAY

REVISED ADJUSTED
COLLECTED SCALE

1" = 400 FEET

LOT 4

NW 1/4 NW 1/4

40.34

LOT 3

NE 1/4 NW 1/4

40.33

1293.9'

78

LOT 2

L

40.31

300

157.61

400

157.67 AC.

Dave Miller
EE MAP 24S 32VE

← WELL

WELL LOCATED FROM
CENTER SECTION 2
1430 ft NORTH
1230 ft WEST

CENTER
SECTION 2

2

1000

I would say the point marked as well is very

G-17131