



FINAL PROOF SURVEY

Under
Application No. 5224 Permit No. 3163

In Name of

BLUE MOUNTAIN DITCH CO.

Inspected 25826 June 1957
By R.H. Whitby

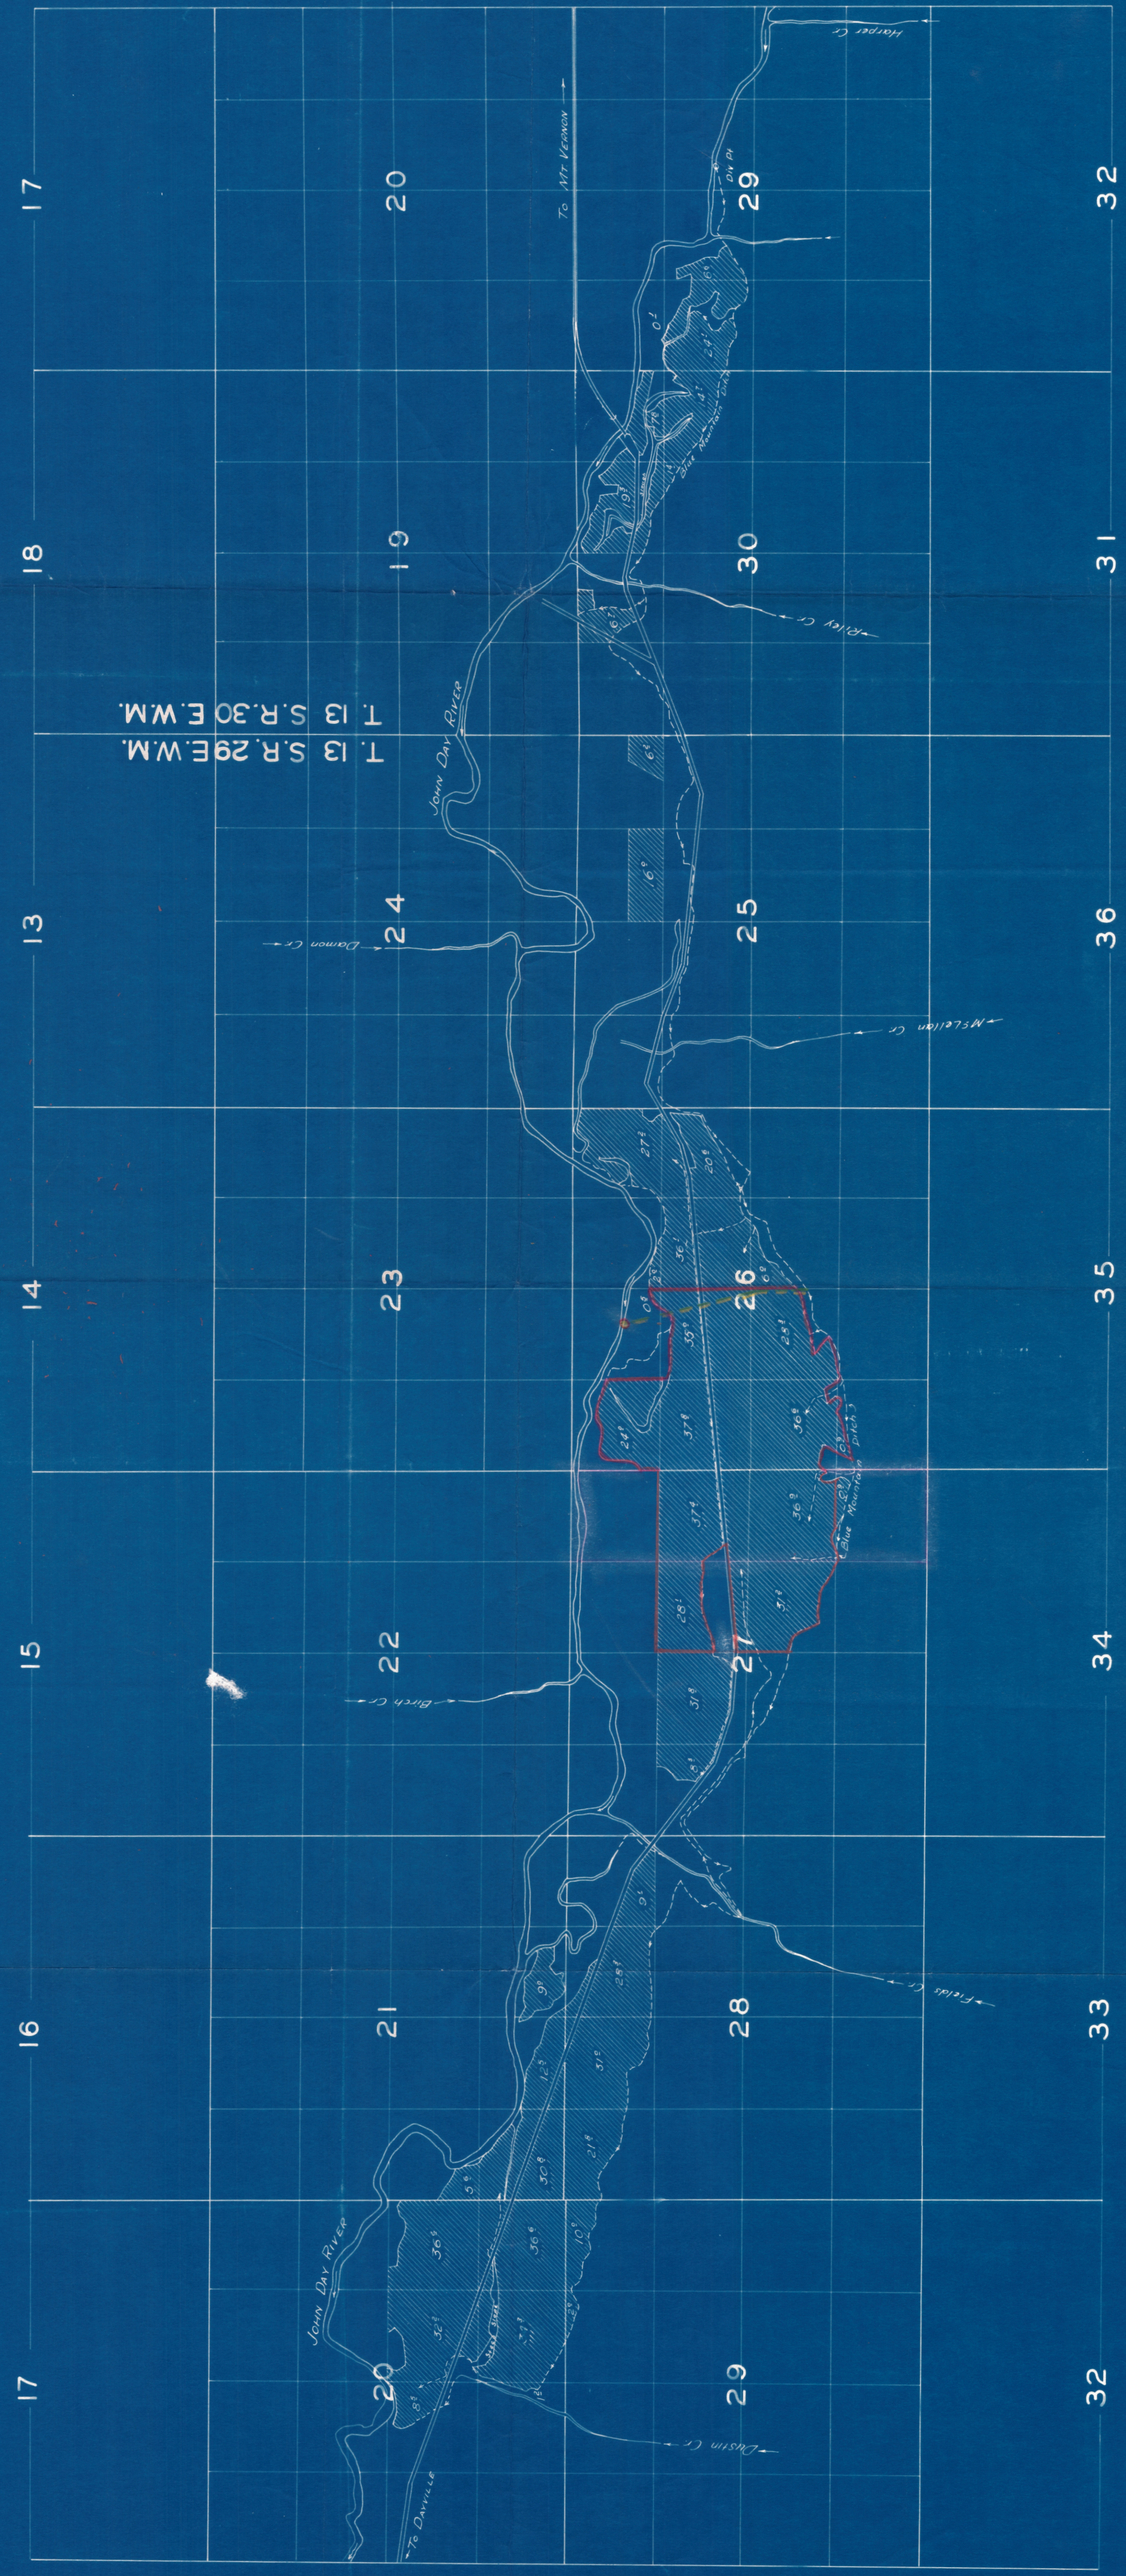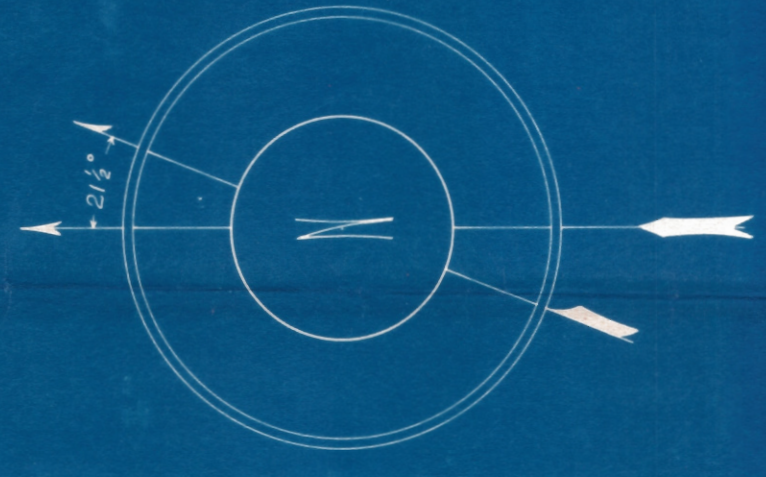

T. 13 S. R. 29 E. W. M.
T. 13 S. R. 30 E. W. M.