

SECTION PLAT

Section 9 & 10


Township 24-S

Range 30-E

County of Harney

State of OR

NORTH

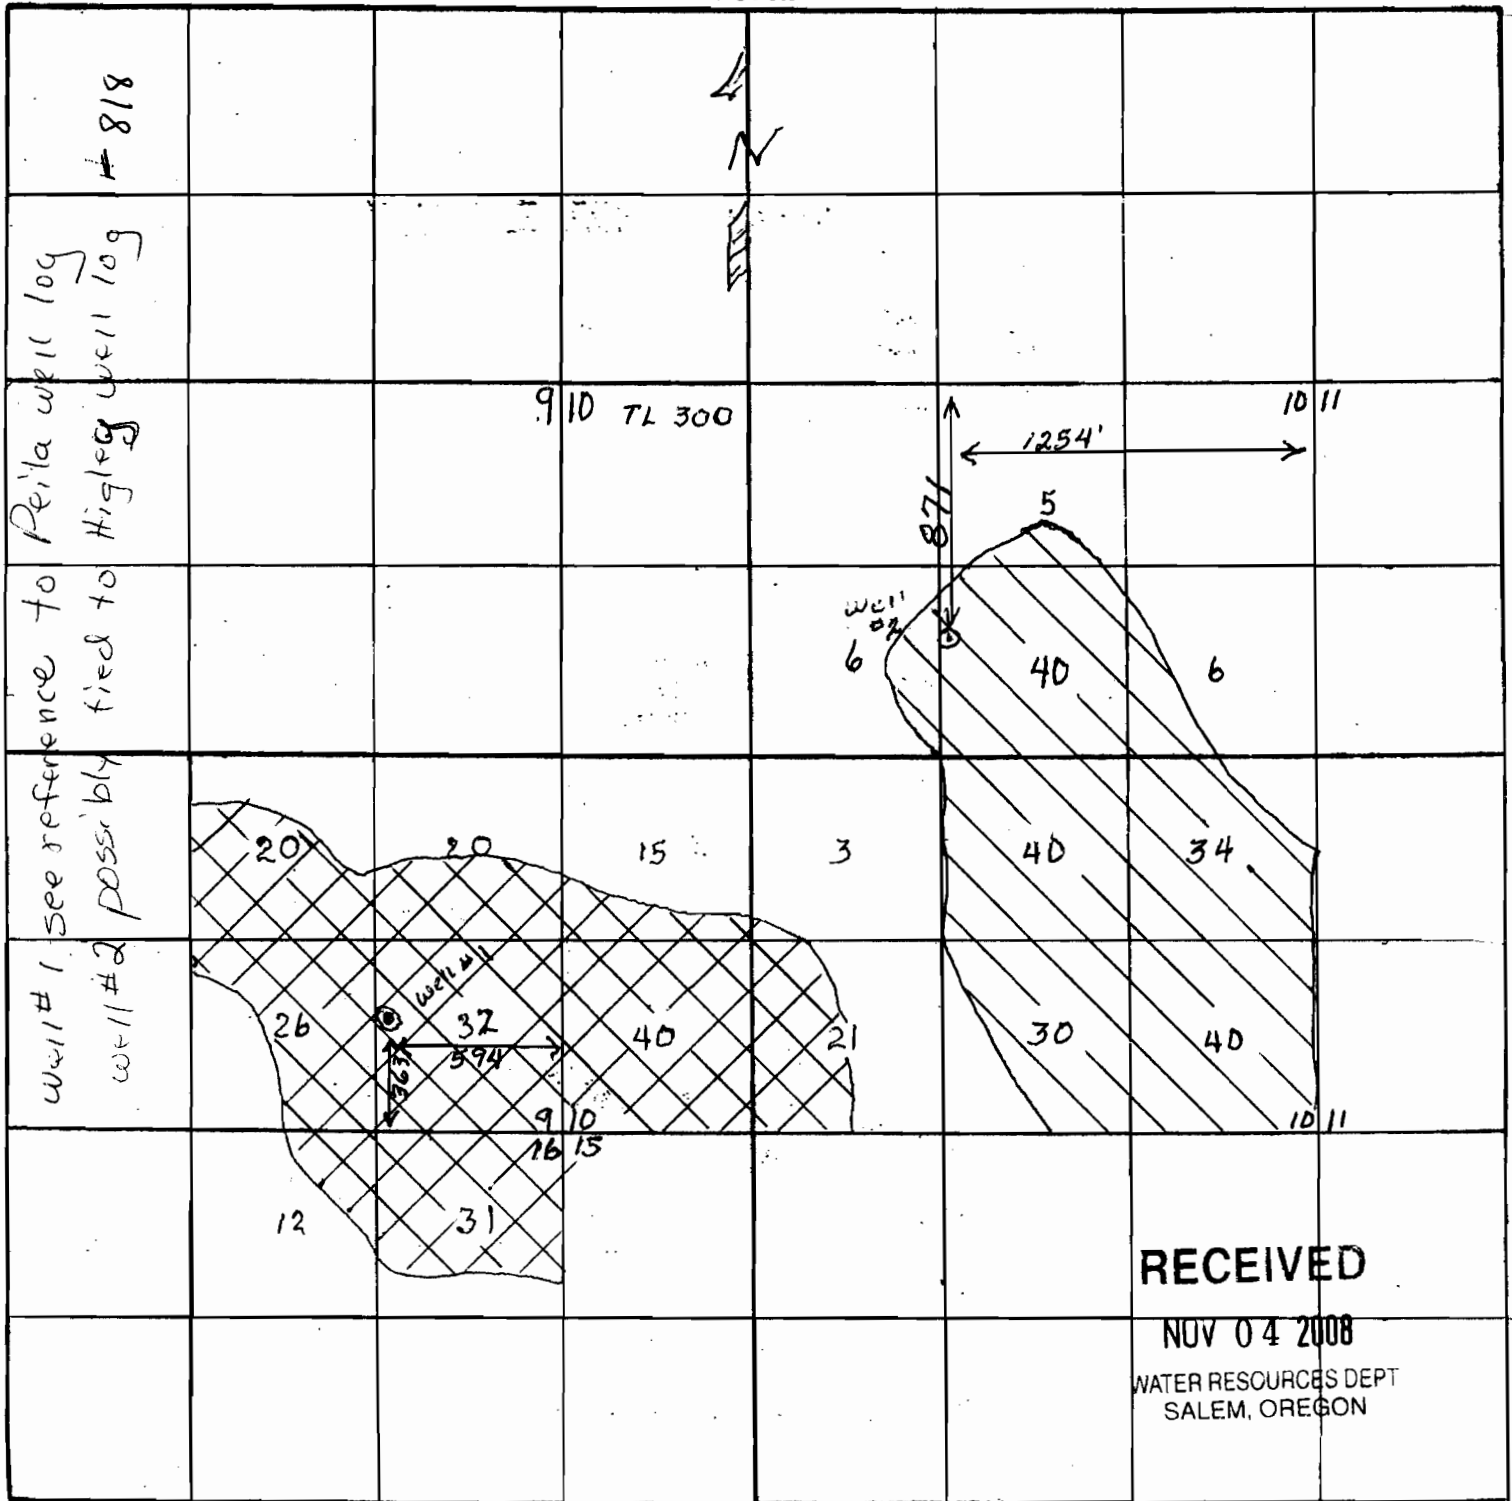

Remarks scale - 8" = 1 mile - 660' -