


SEE MAP
1S 32 09
R PARCELS 1 & 2

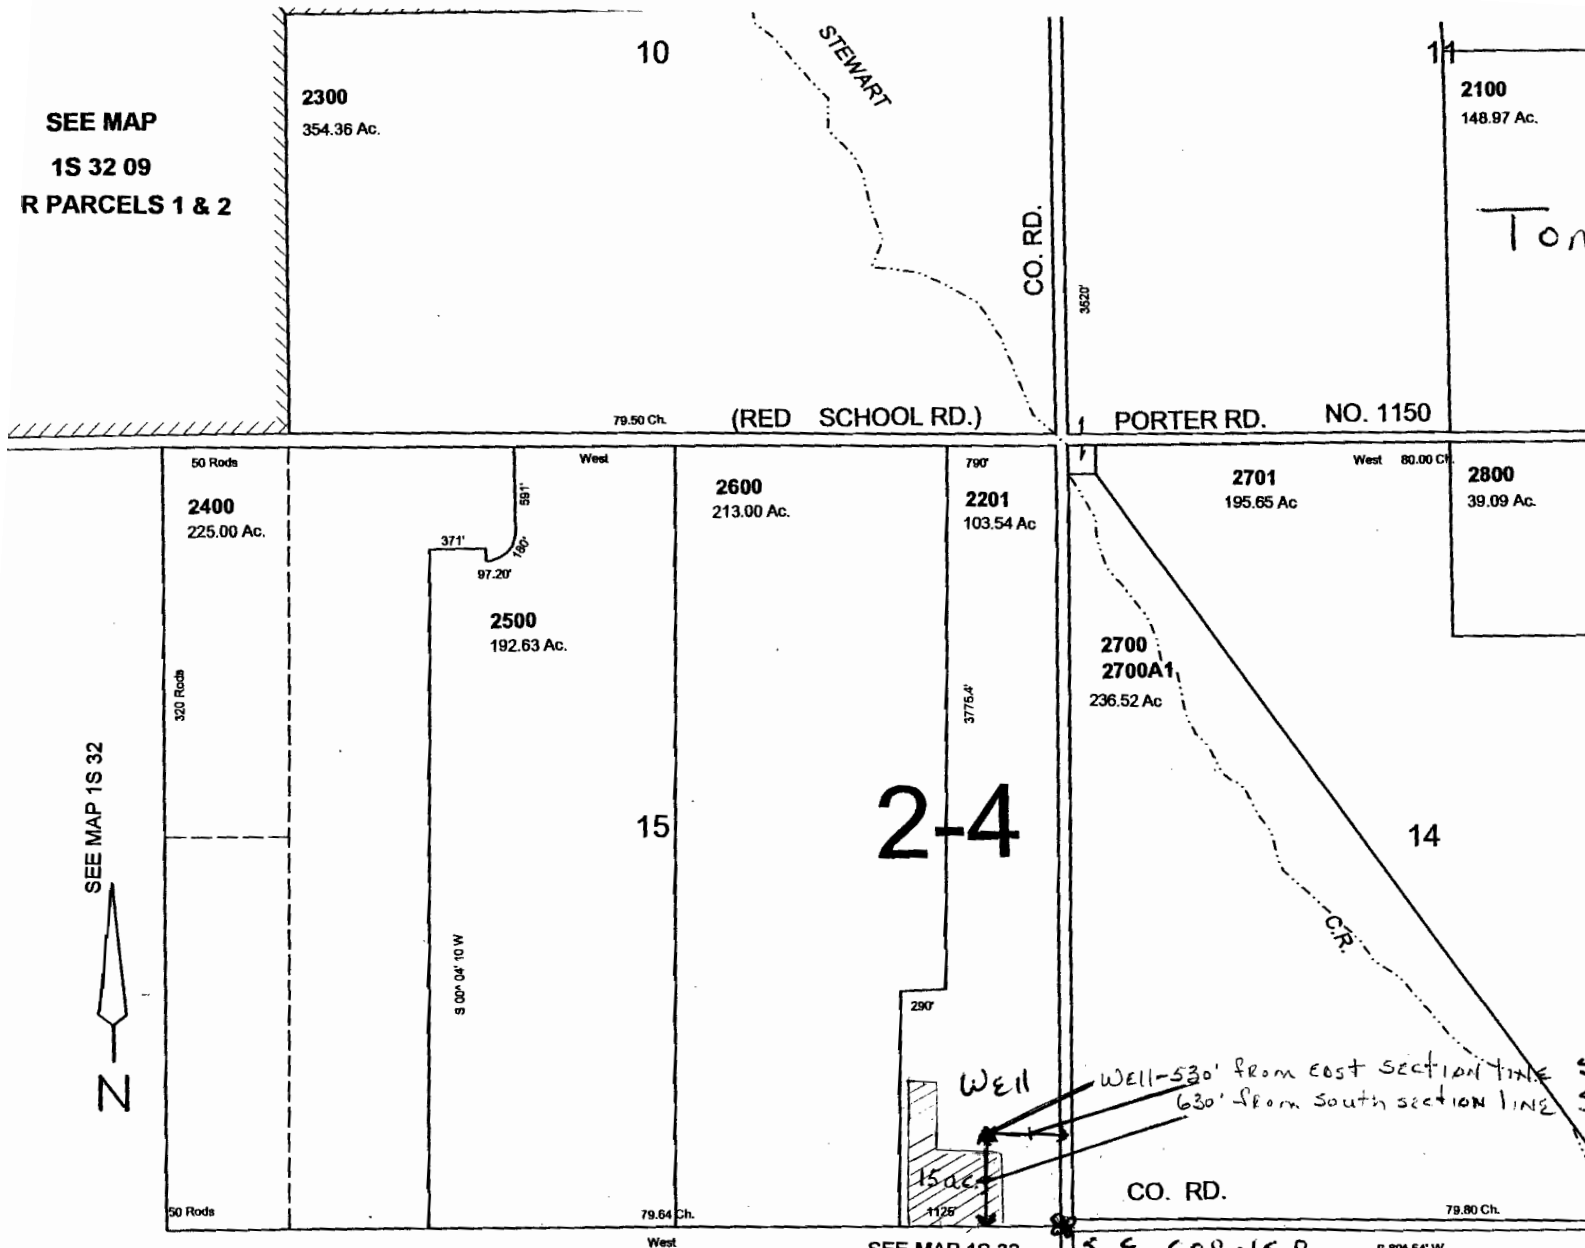

Tom & Maureen Ruge

RECEIVED

NOV 14 2008

WATER RESOURCES DEPT
SALEM, OREGON

Map Scale 1" = 1320'
4" = 1 mile

T 1S R 32E Sec. 15

Assessor map # 1S 32A0-00-00001

ACRES

15 acres in S.E. corner of S.E. 1/4 Sec. 15

Tax lot 2001