

Nov 14, 2008

# Application MAP for DARYL ROBISON

JUL - 3 1989

## John P. Prahar LAND PLANNING AND SURVEYING

WATER RESOURCES DEPT  
SALEM, OREGON

Fern Park Building, Suite 1 • 1045 Baltimore Ave. • Bandon, Oregon 97411 • (503) 347-9517

R-69982d


Application No. 69983

Permit No. R11243 51053

Section 33 T 31 S R 15 W W.M TL1400

SIXES AIRPORT ROAD

NE CORNER OF NW 1/4 SE 1/4 SEC. 33

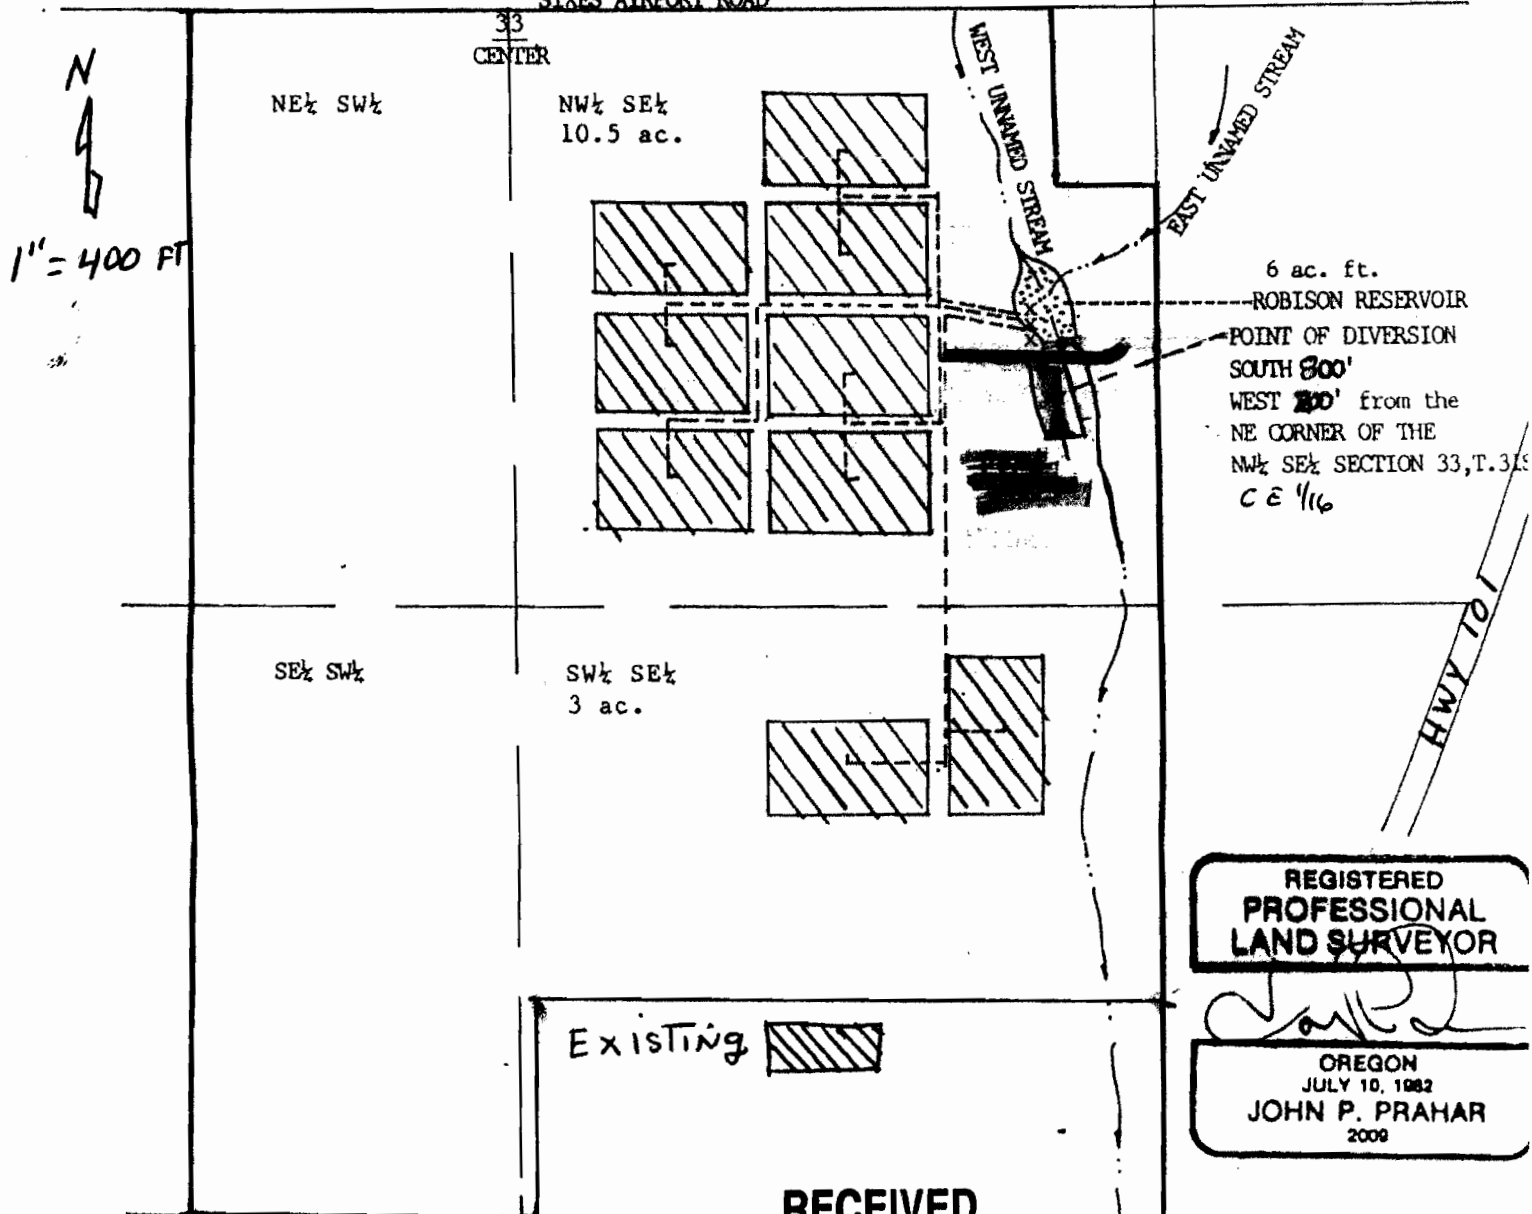

REGISTERED  
PROFESSIONAL  
LAND SURVEYOR

*John P. Prahar*

OREGON  
JULY 10, 1982  
JOHN P. PRAHAR  
2009

RECEIVED

NOV 17 2008

WATER RESOURCES DEPT  
SALEM, OREGON

MAP FOR APPLICATION TO APPROPRIATE SURFACE WATER AND CONSTRUCT A RESERVOIR  
IN THE N.W. 1/4 OF THE S.E. 1/4 AND THE S.W. 1/4 OF THE S.E. 1/4 OF SECTION 33, TOWNSHIP 31 SOUTH, RGE.  
COUNTY OF CURRY STATE OF OREGON