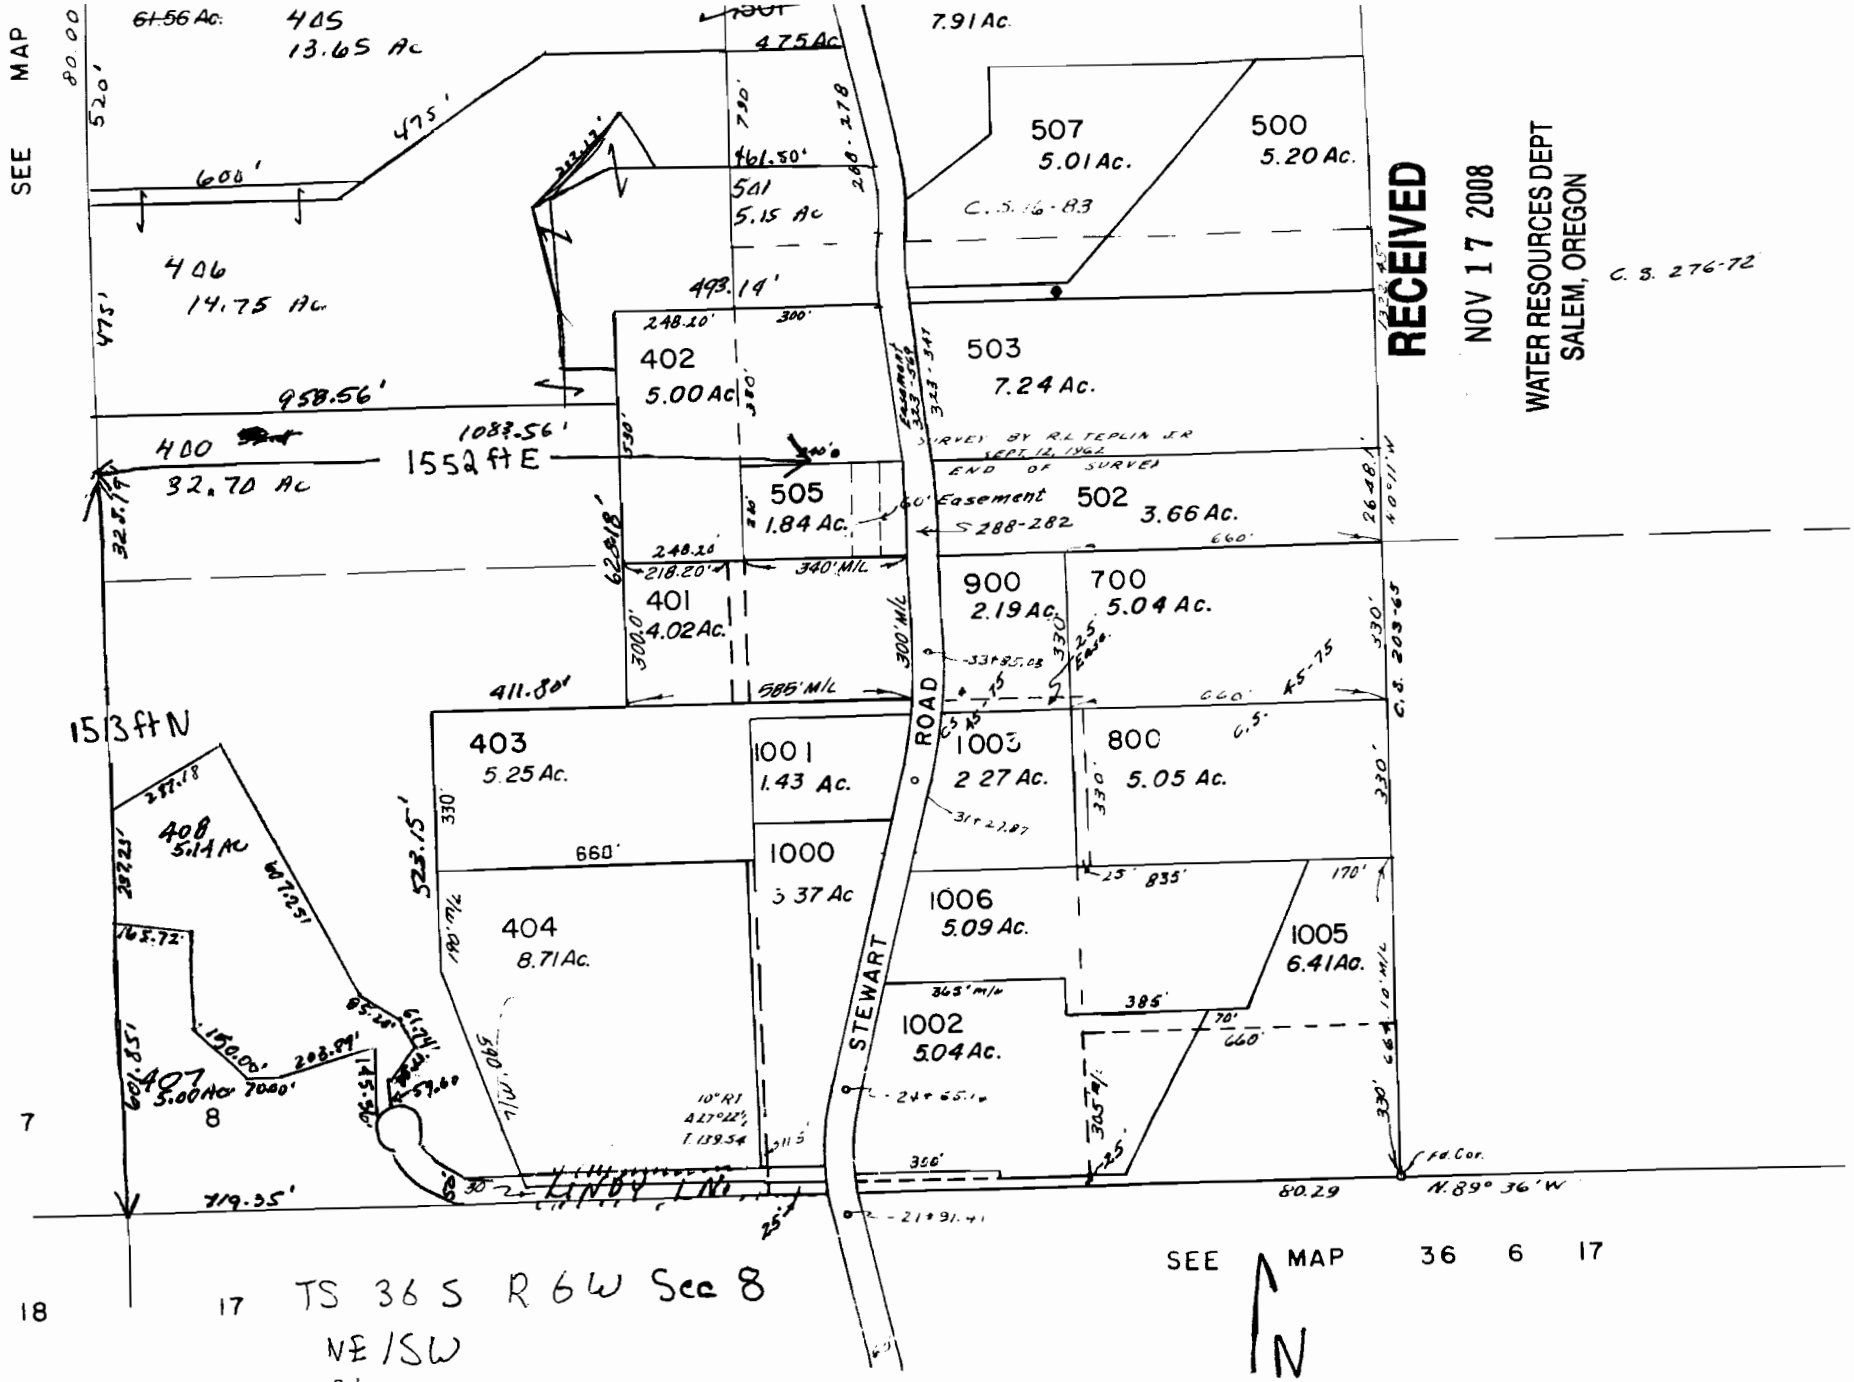

TS 36 S R 6 W Sec 8

NE/SW

1513 ft North and 1552 ft E

of the SW corner of Section 8