


S-87349

Odell Lake Tract G Section 14 T. 23 S. R. 6 E.

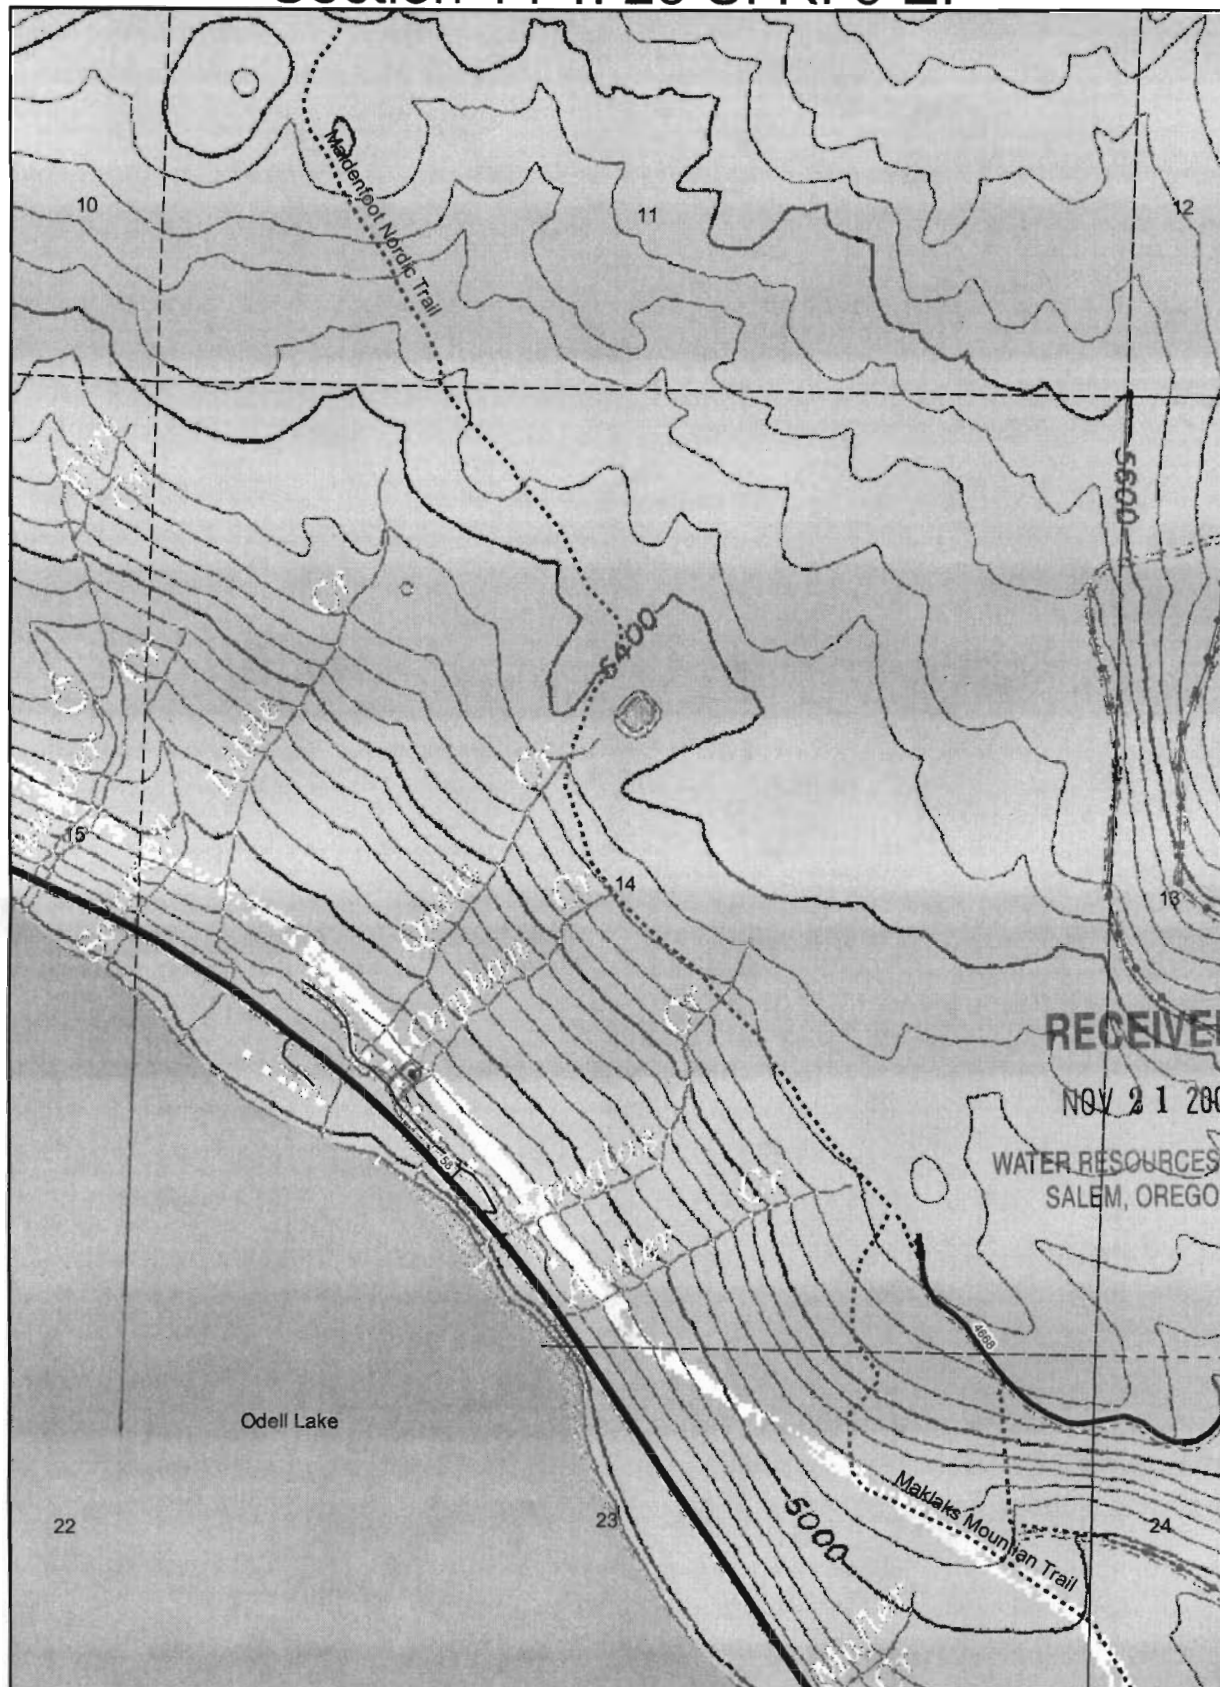

0 500 1,000 2,000 Feet


1500 E
3650 S

R. Grim
9/18/2008

or NW corner

Odell Lake Tract G
Section 14 T. 23 S. R. 6 E.

S-87349

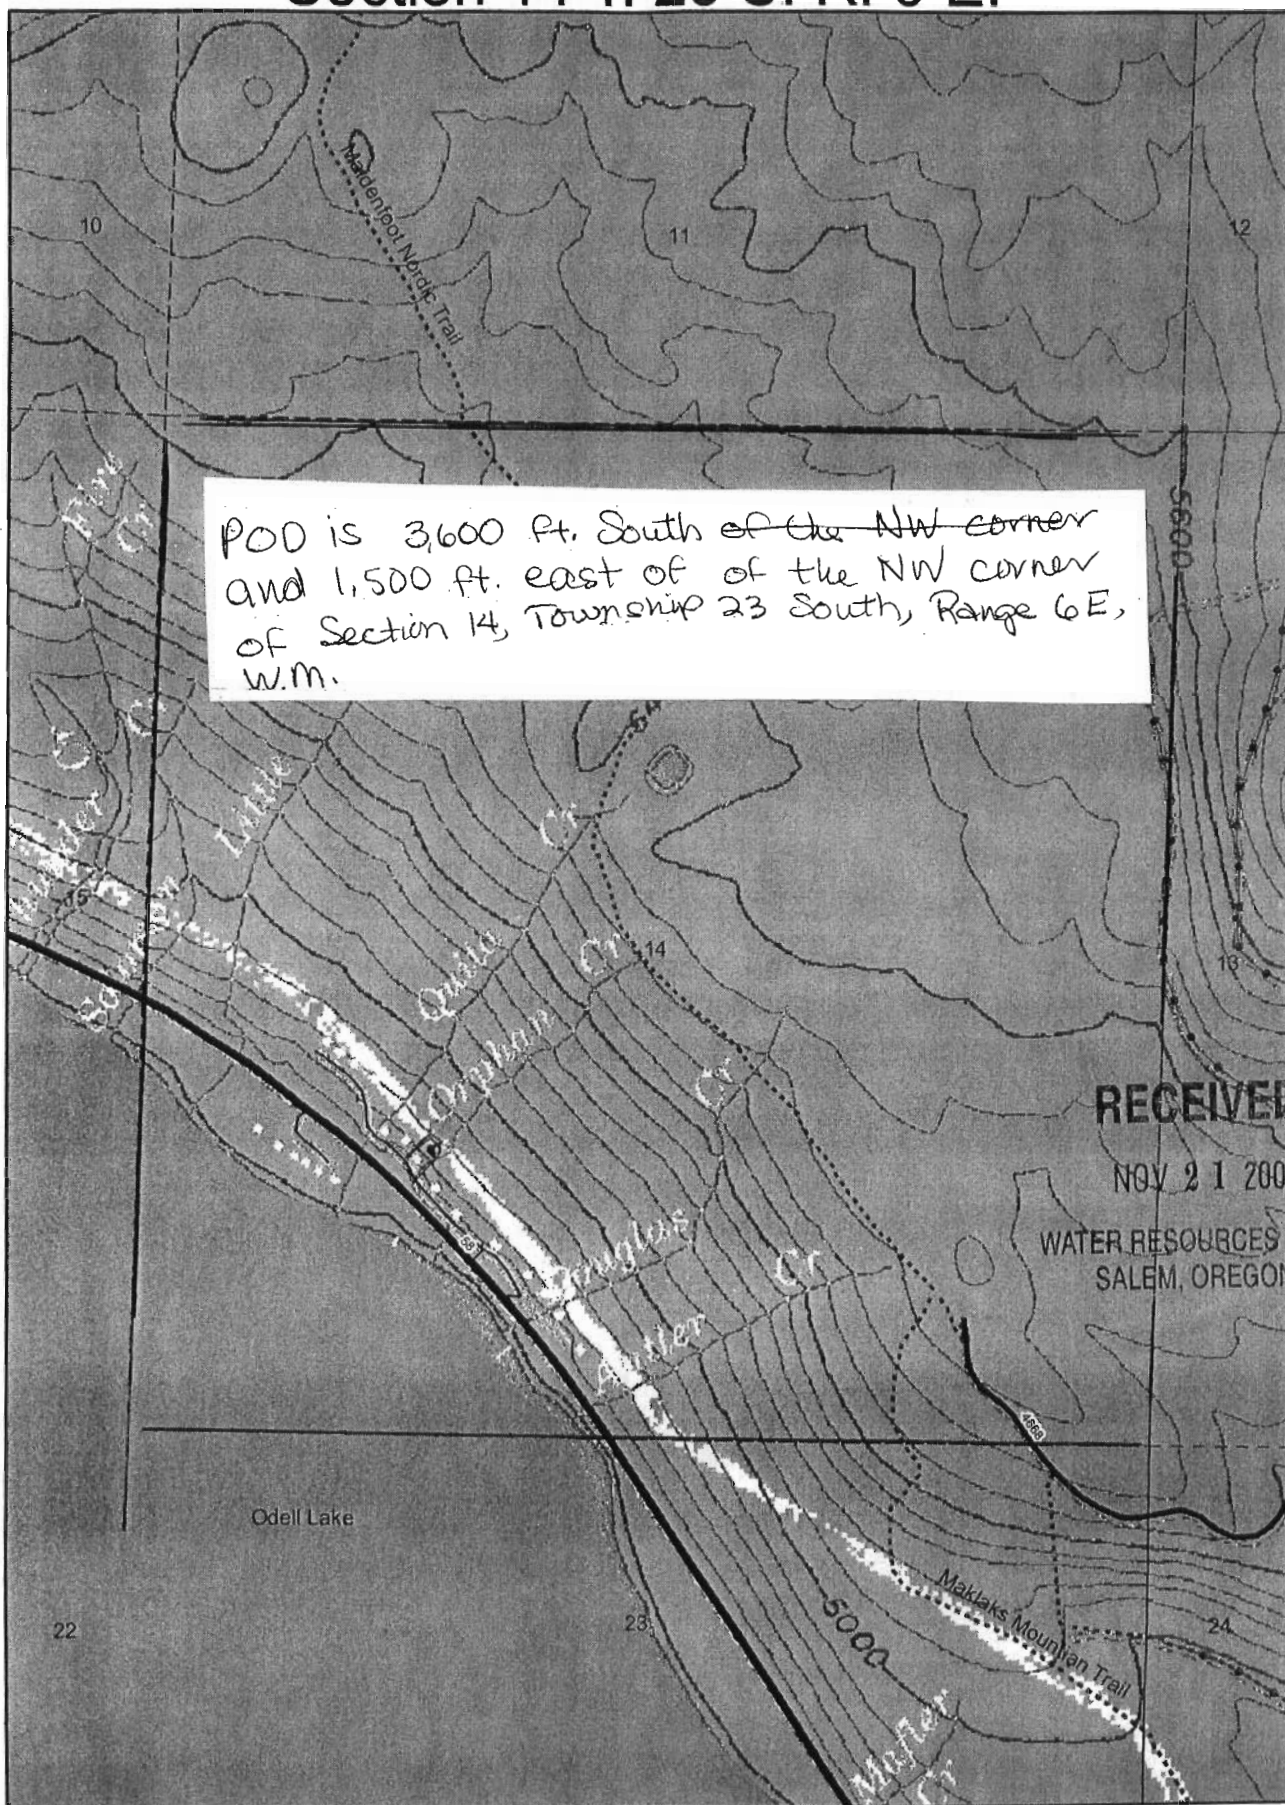

RECEIVED

NOV 21 2008

WATER RESOURCES DEPT
SALEM, OREGON

0 500 1,000 2,000 Feet

1500 E

R. Grim
9/18/2008