

MAP NO. 1
COUNTY
SCALE 1" = 300'



C.A.D. SYS.

SEE MAP 18 04 05

RK
PY


CORRECTED APPROX
ADJUSTED SCALE
1" = 300 FEET

LCCM 18-03-05 W1/4

CANCELLED
1905

POND LOCATED FROM
SOUTH 1/4 CORNER
SECTION 6.

110 FEET NORTH
300 FEET WEST

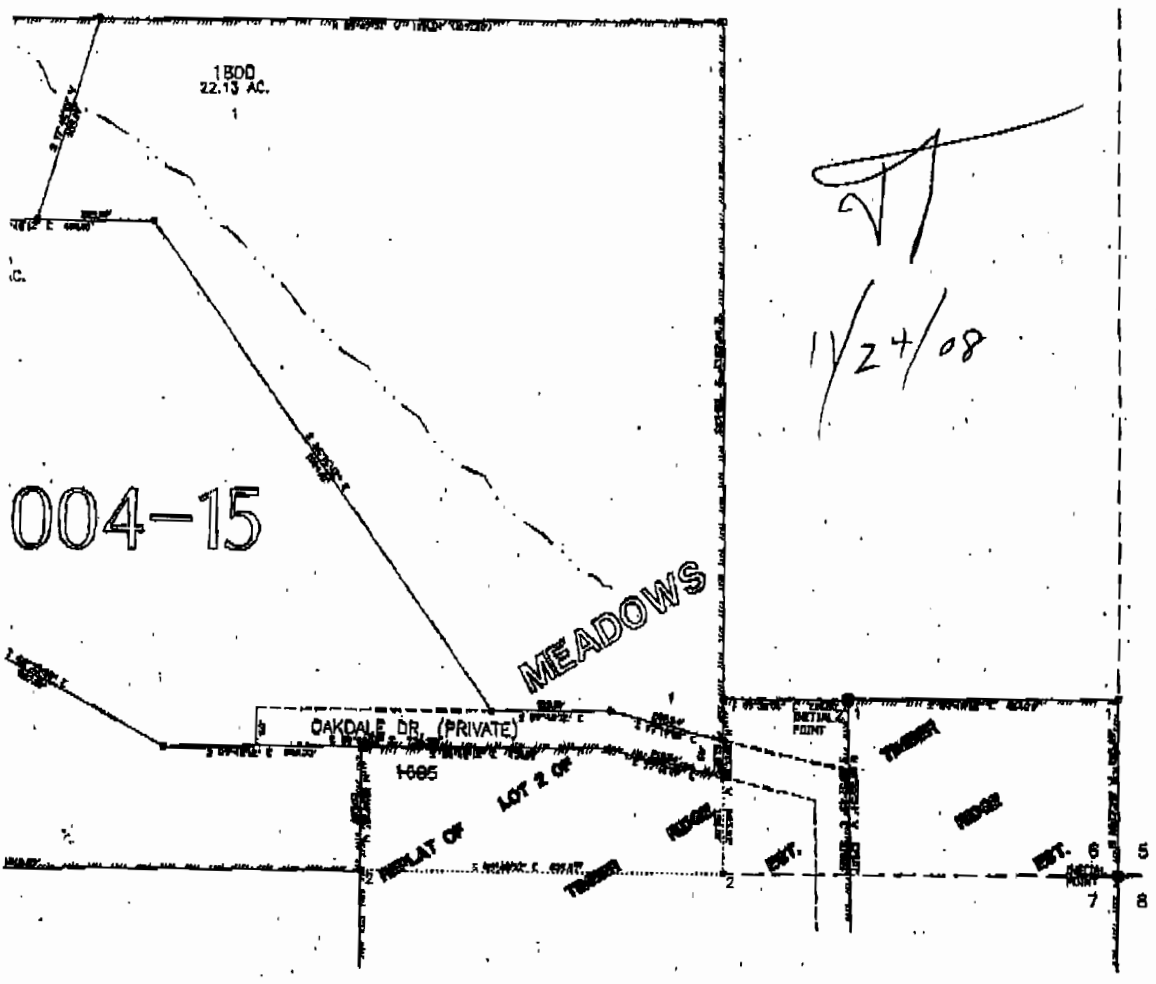

SEE MAP 18 04 05

004-15


1800
22.15 AC.

MEADOWS

OAKDALE DR (PRIVATE)

LOT 2 OF

EST. 6
5
7
8

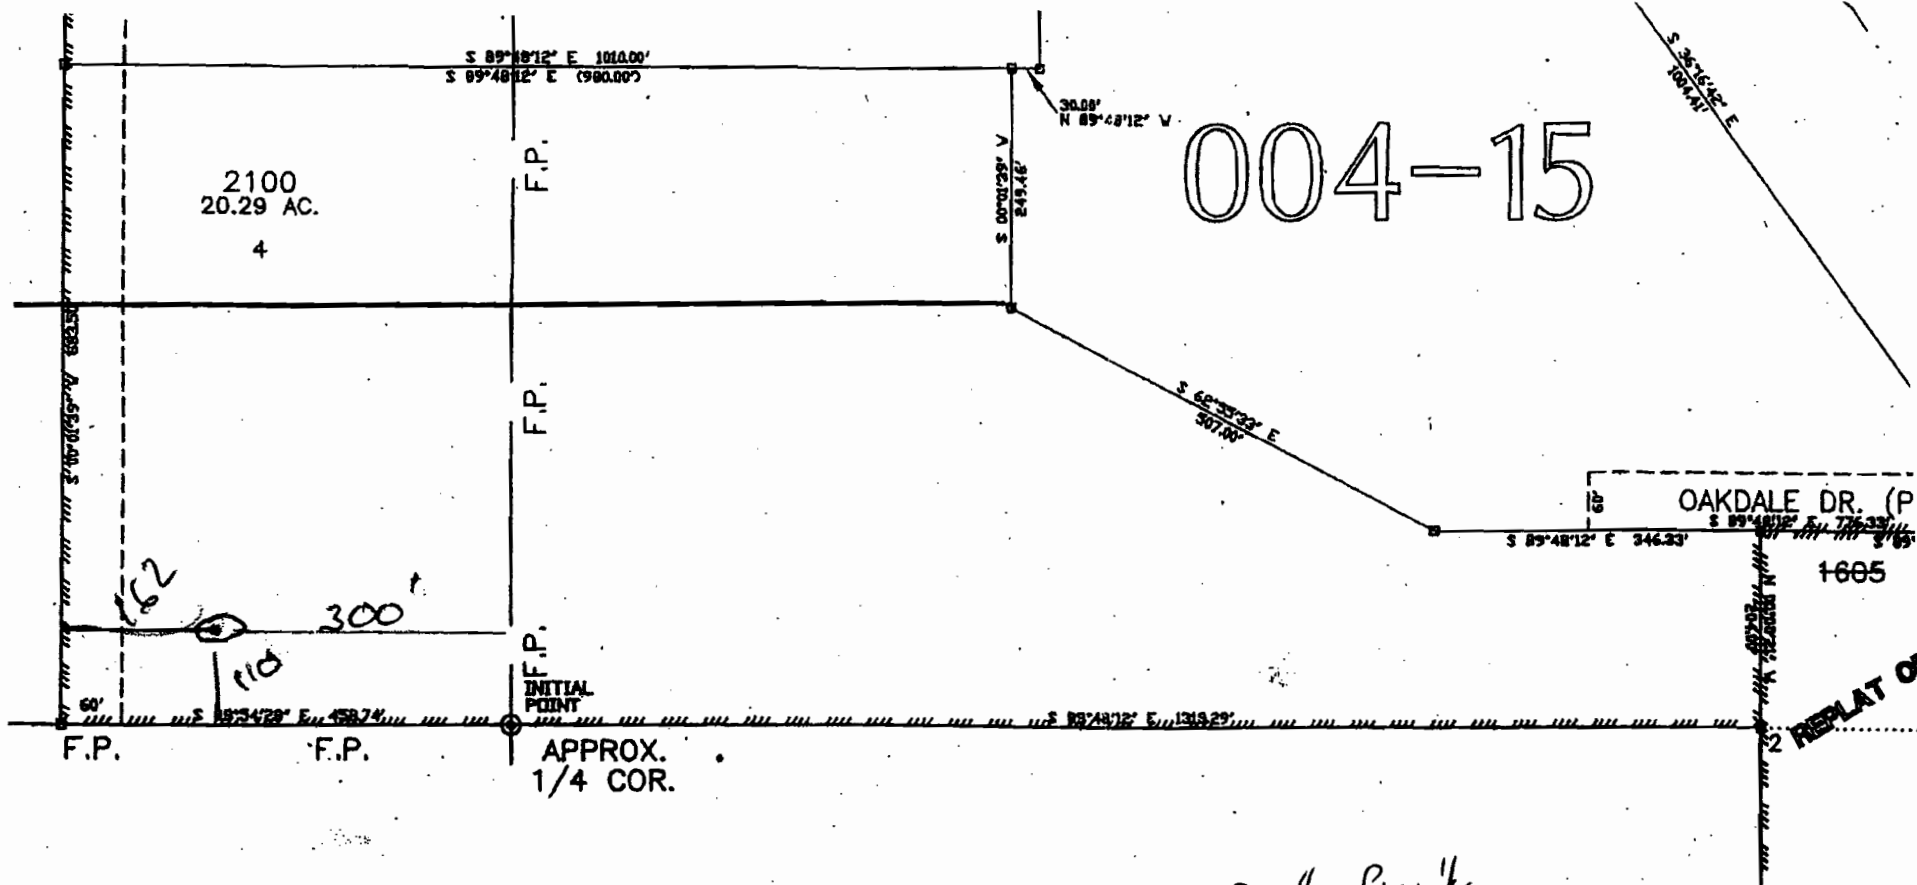

WORK COPY

SE 1/4, SW 1/4

RESURVEYED @ 1" = 200 FEET
 APPROX REVISED
 CORRECTED

R-87510

DETAIL MAP NO. 1
LANE COUNTY

SCALE 1" = 300'

SEE MAP 18 04 06

7/15/99	NEW MAP ON CAS SYSTEM	LCA1479
7/15/99	PTN. 1804400-1605 INTO OAKRIDGE MEADOWS	LCA1479
7/15/99	CORR. 1804400-1605 TRIM REPEAT OF LOT 2 OF THUNDER RIDGE ESTATES	LCA1479

DETAIL MAP NO. 1

R-27340

C.A.D. SYS.

LCCM 18-03-05 W1/4
LCSA 1987

CANCELLED
1605

SEE MAP 18 04 05

WORK
COPY

CORRECTED APPROX
ADJUSTED SCALE
1" = 300 FEET

