

Mike Weedman
P.O. Box 376
Wasco, Oregon
97065


RECEIVED

MAR - 9 1977
WATER RESOURCES DEPT
SALEM, OREGON

T 15 R 18 E

10 11
15 14

11 12
14 13

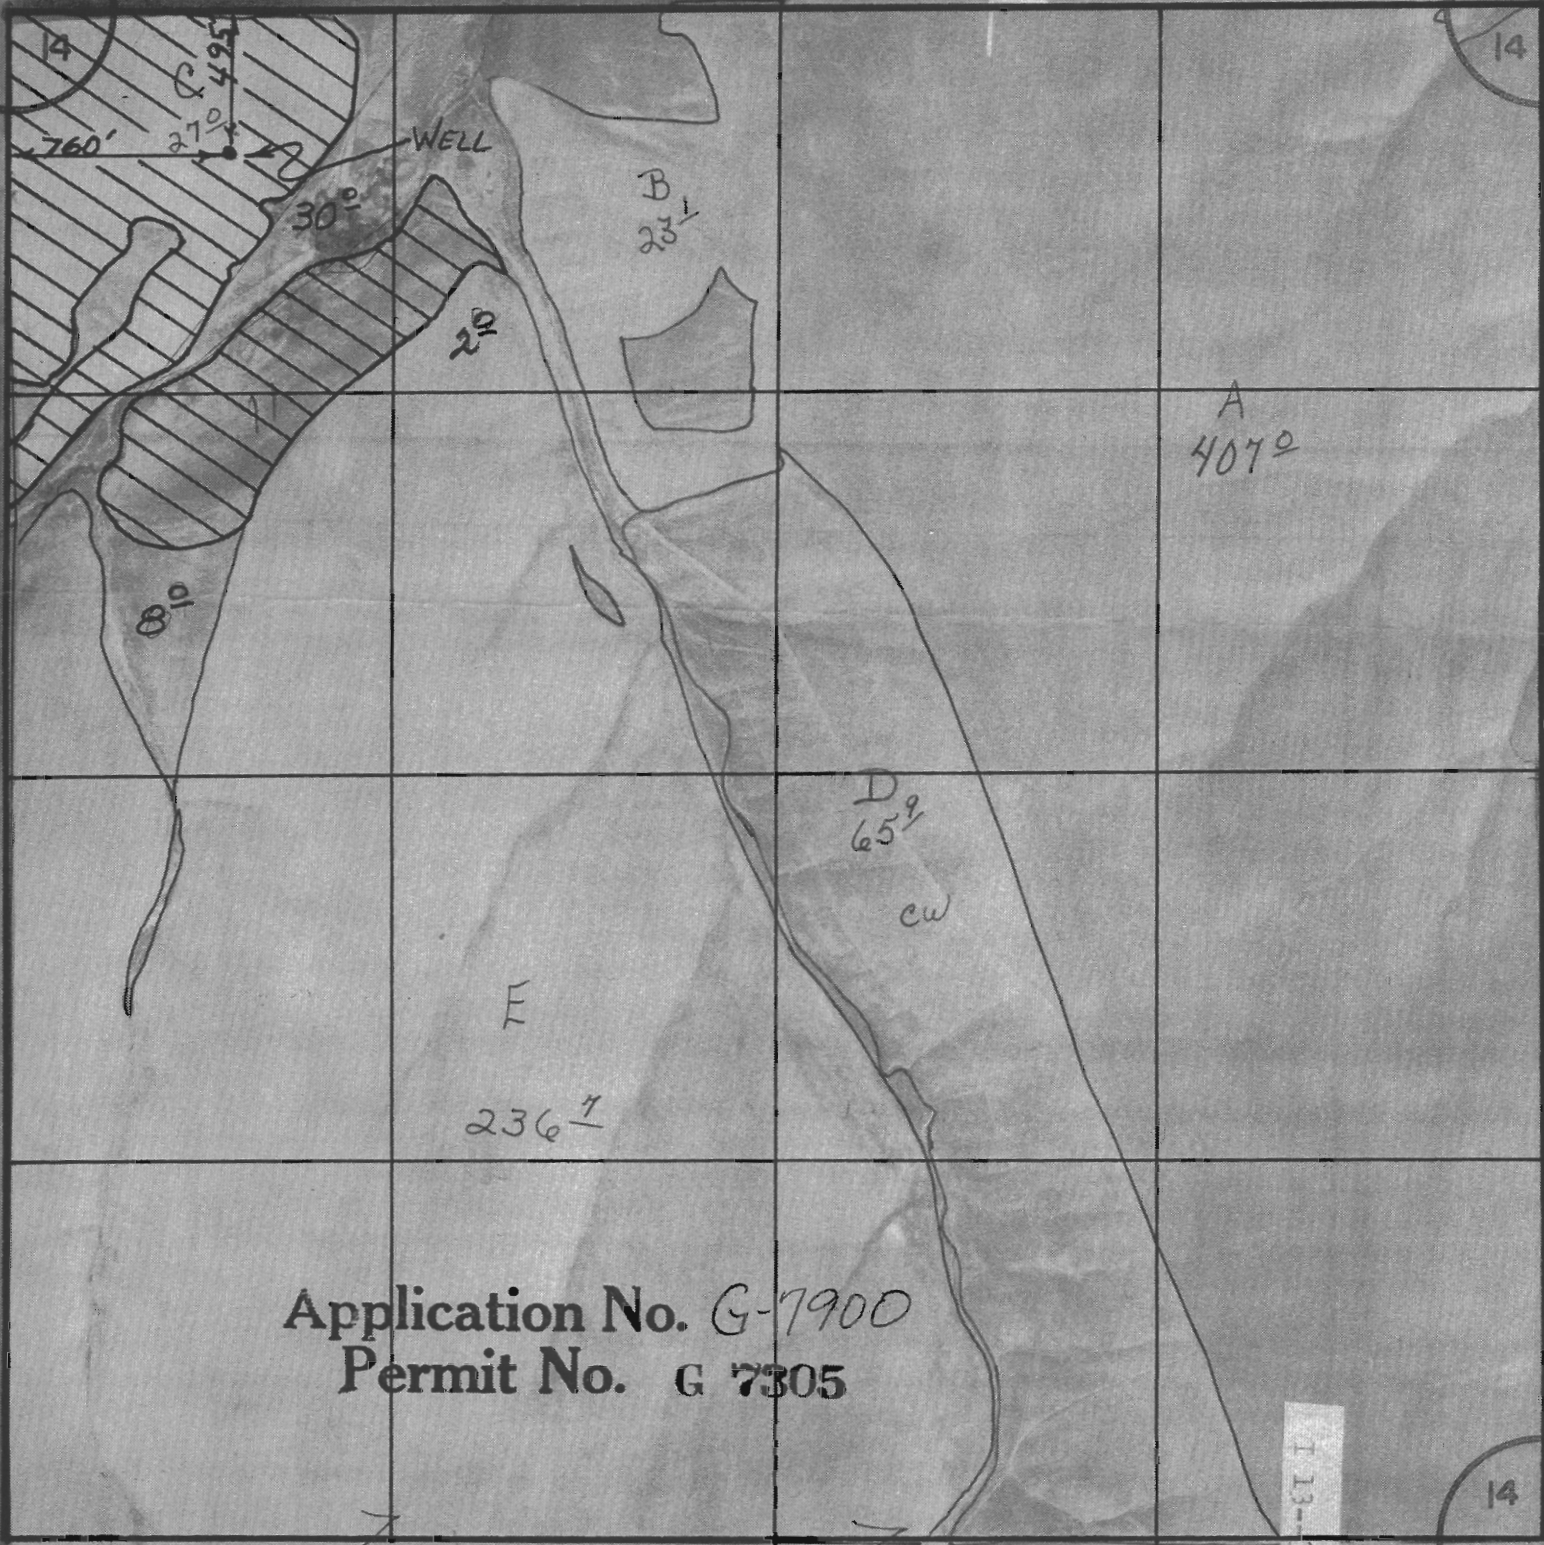

Application No. G-7900
Permit No. G 7305

SCALE 8" = 1 MILE

NOT TO SCALE

1 13-3

14 13
23 2