SECTION PLAT

Section 34 4 Township 25-S 26-S Range 30-E 30-E G-17146

County of Harney State of OR

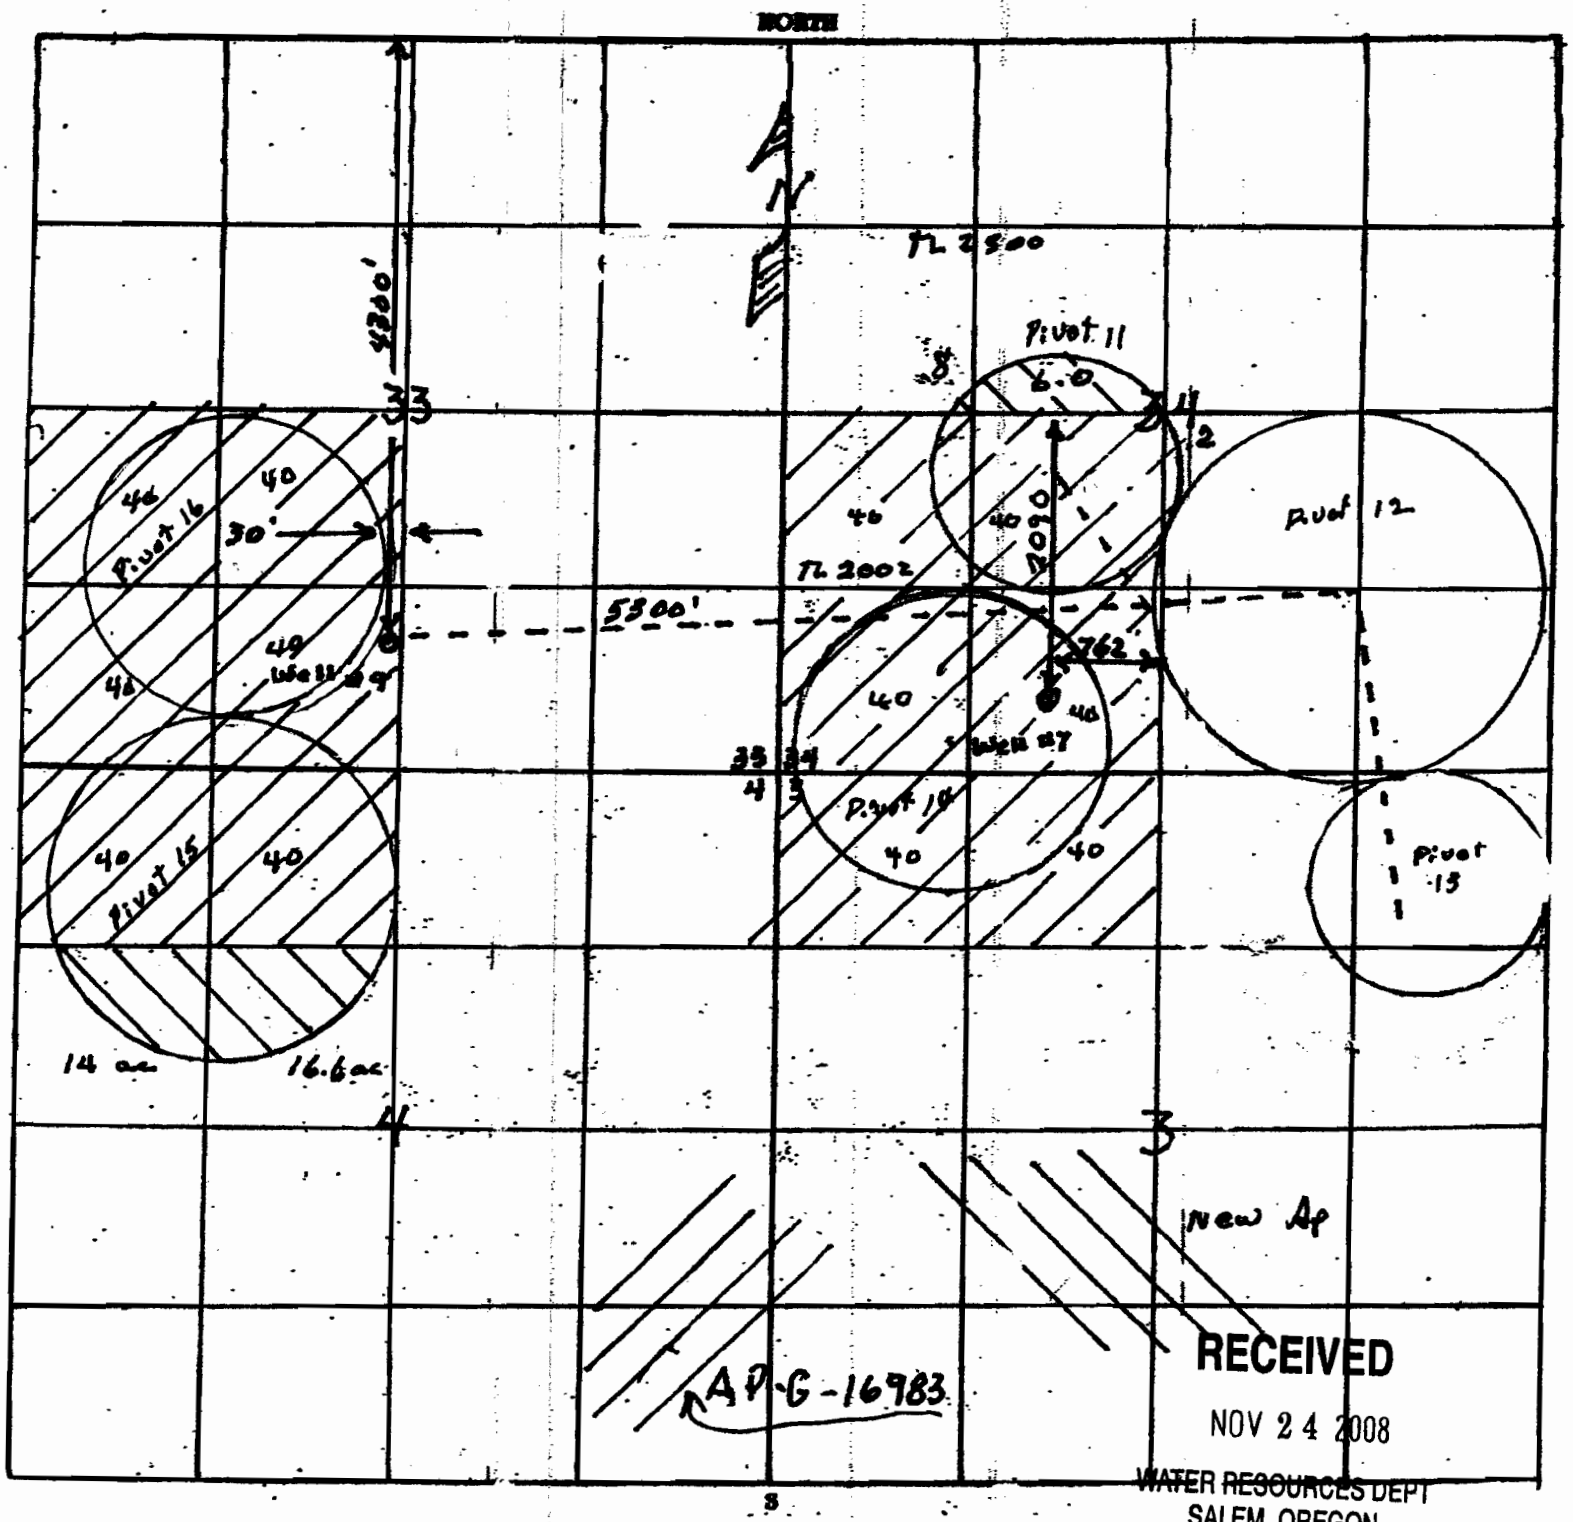

RECEIVED
NOV 24 2008
WATER RESOURCES DEPT
SALEM, OREGON

Remarks scale - 8" = 1 mile - 660' -