

UNSUH

12

11

10

PRINCESS

ROSARY

NE 1/4

16

OLD CR

TITLE CR

FREE CR

TRADER CR

LITTLE CR

15

14

OUTA CR

COFFMAN

BOULDER CR

WATER CR

23

Point of Diversion is approx. 4300 ft South and 2800 ft West of the NE 1/4 corner of Section 14, T23S R6E W1M

POD - Little Ash Creek

13

SEE DETAIL MAP NO. 1 TRACT E-1

APPROX ADJUSTED REVISIED SCALE 1" = 1000 FEET

T.23S. R.06E. W.M. KLAMATH COUNTY

SEE DETAIL MAP NO. 1 TRACT G-1

LAKE


SERENITY

RECEIVED

NOV 25 2008

WATER RESOURCES DEPT SALEM, OREGON

Odell Lake Tract G
Section 14 T. 23 S. R. 6 E.

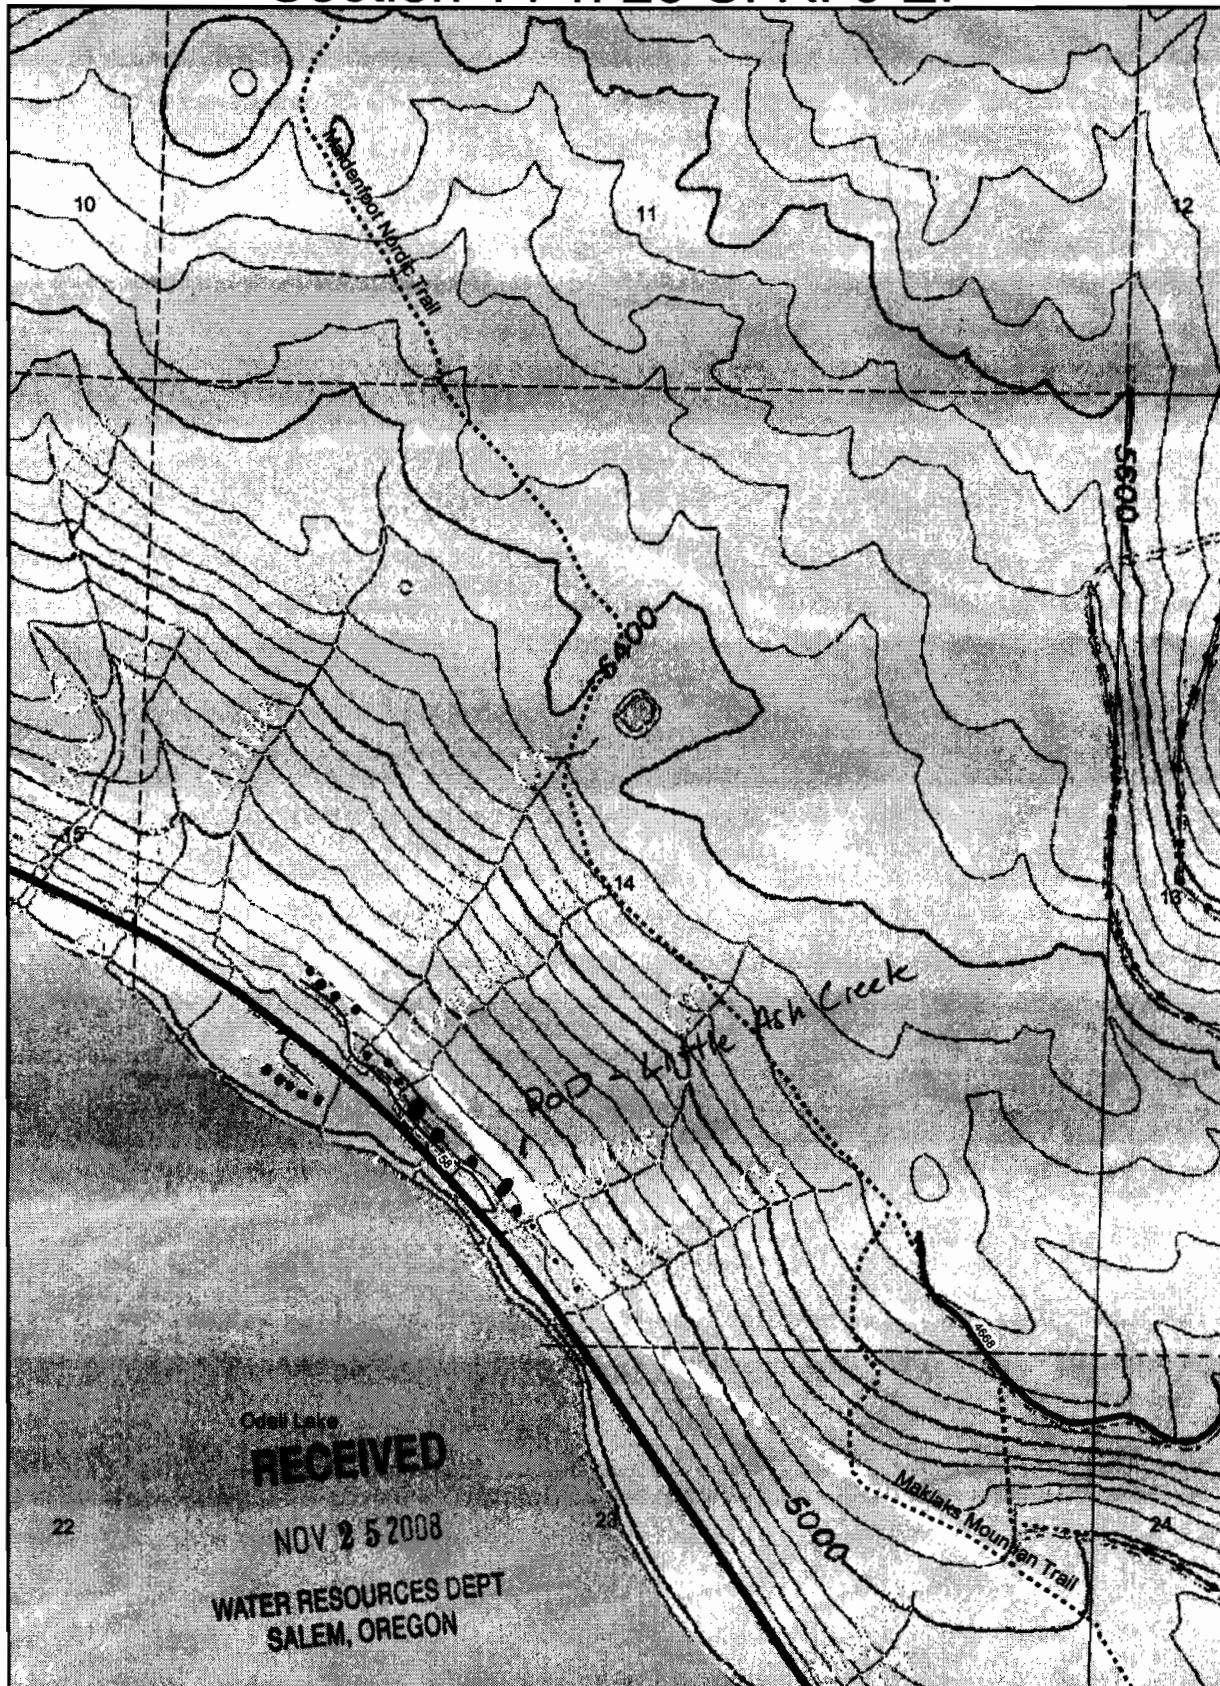

0 500 1,000 2,000 Feet

Point of Diversion
is approx 4300'
south and 2800 ft
west of the NE 1/4
corner of sec. 14

R. Grim
9/18/2008