


Lloyd M. Haines

Application Map Store Water in a Reservoir T40S, R3W, W.M. Section 18

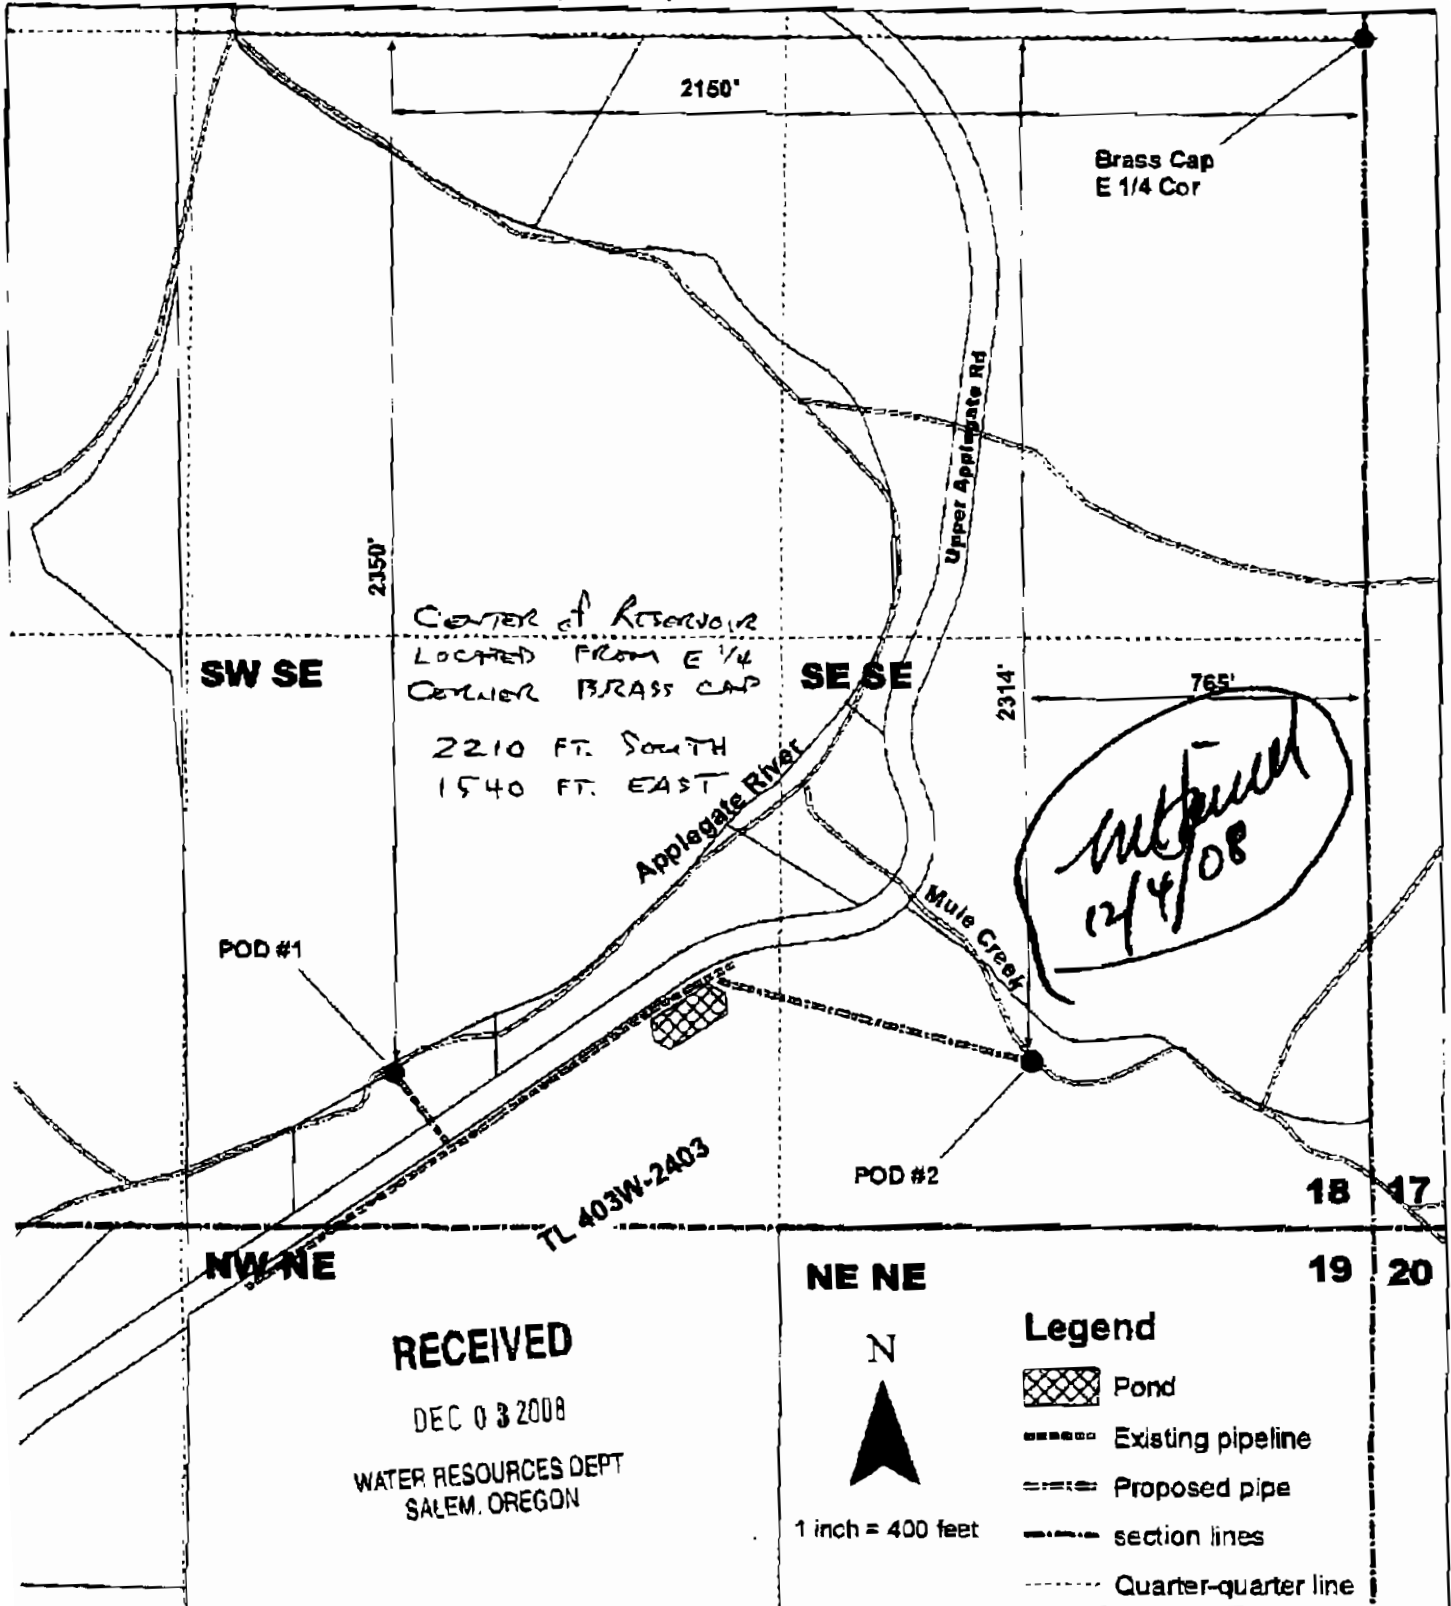

**Application Map
Store Water in a Reservoir
T40S, R3W, W.M. Section 18**

