



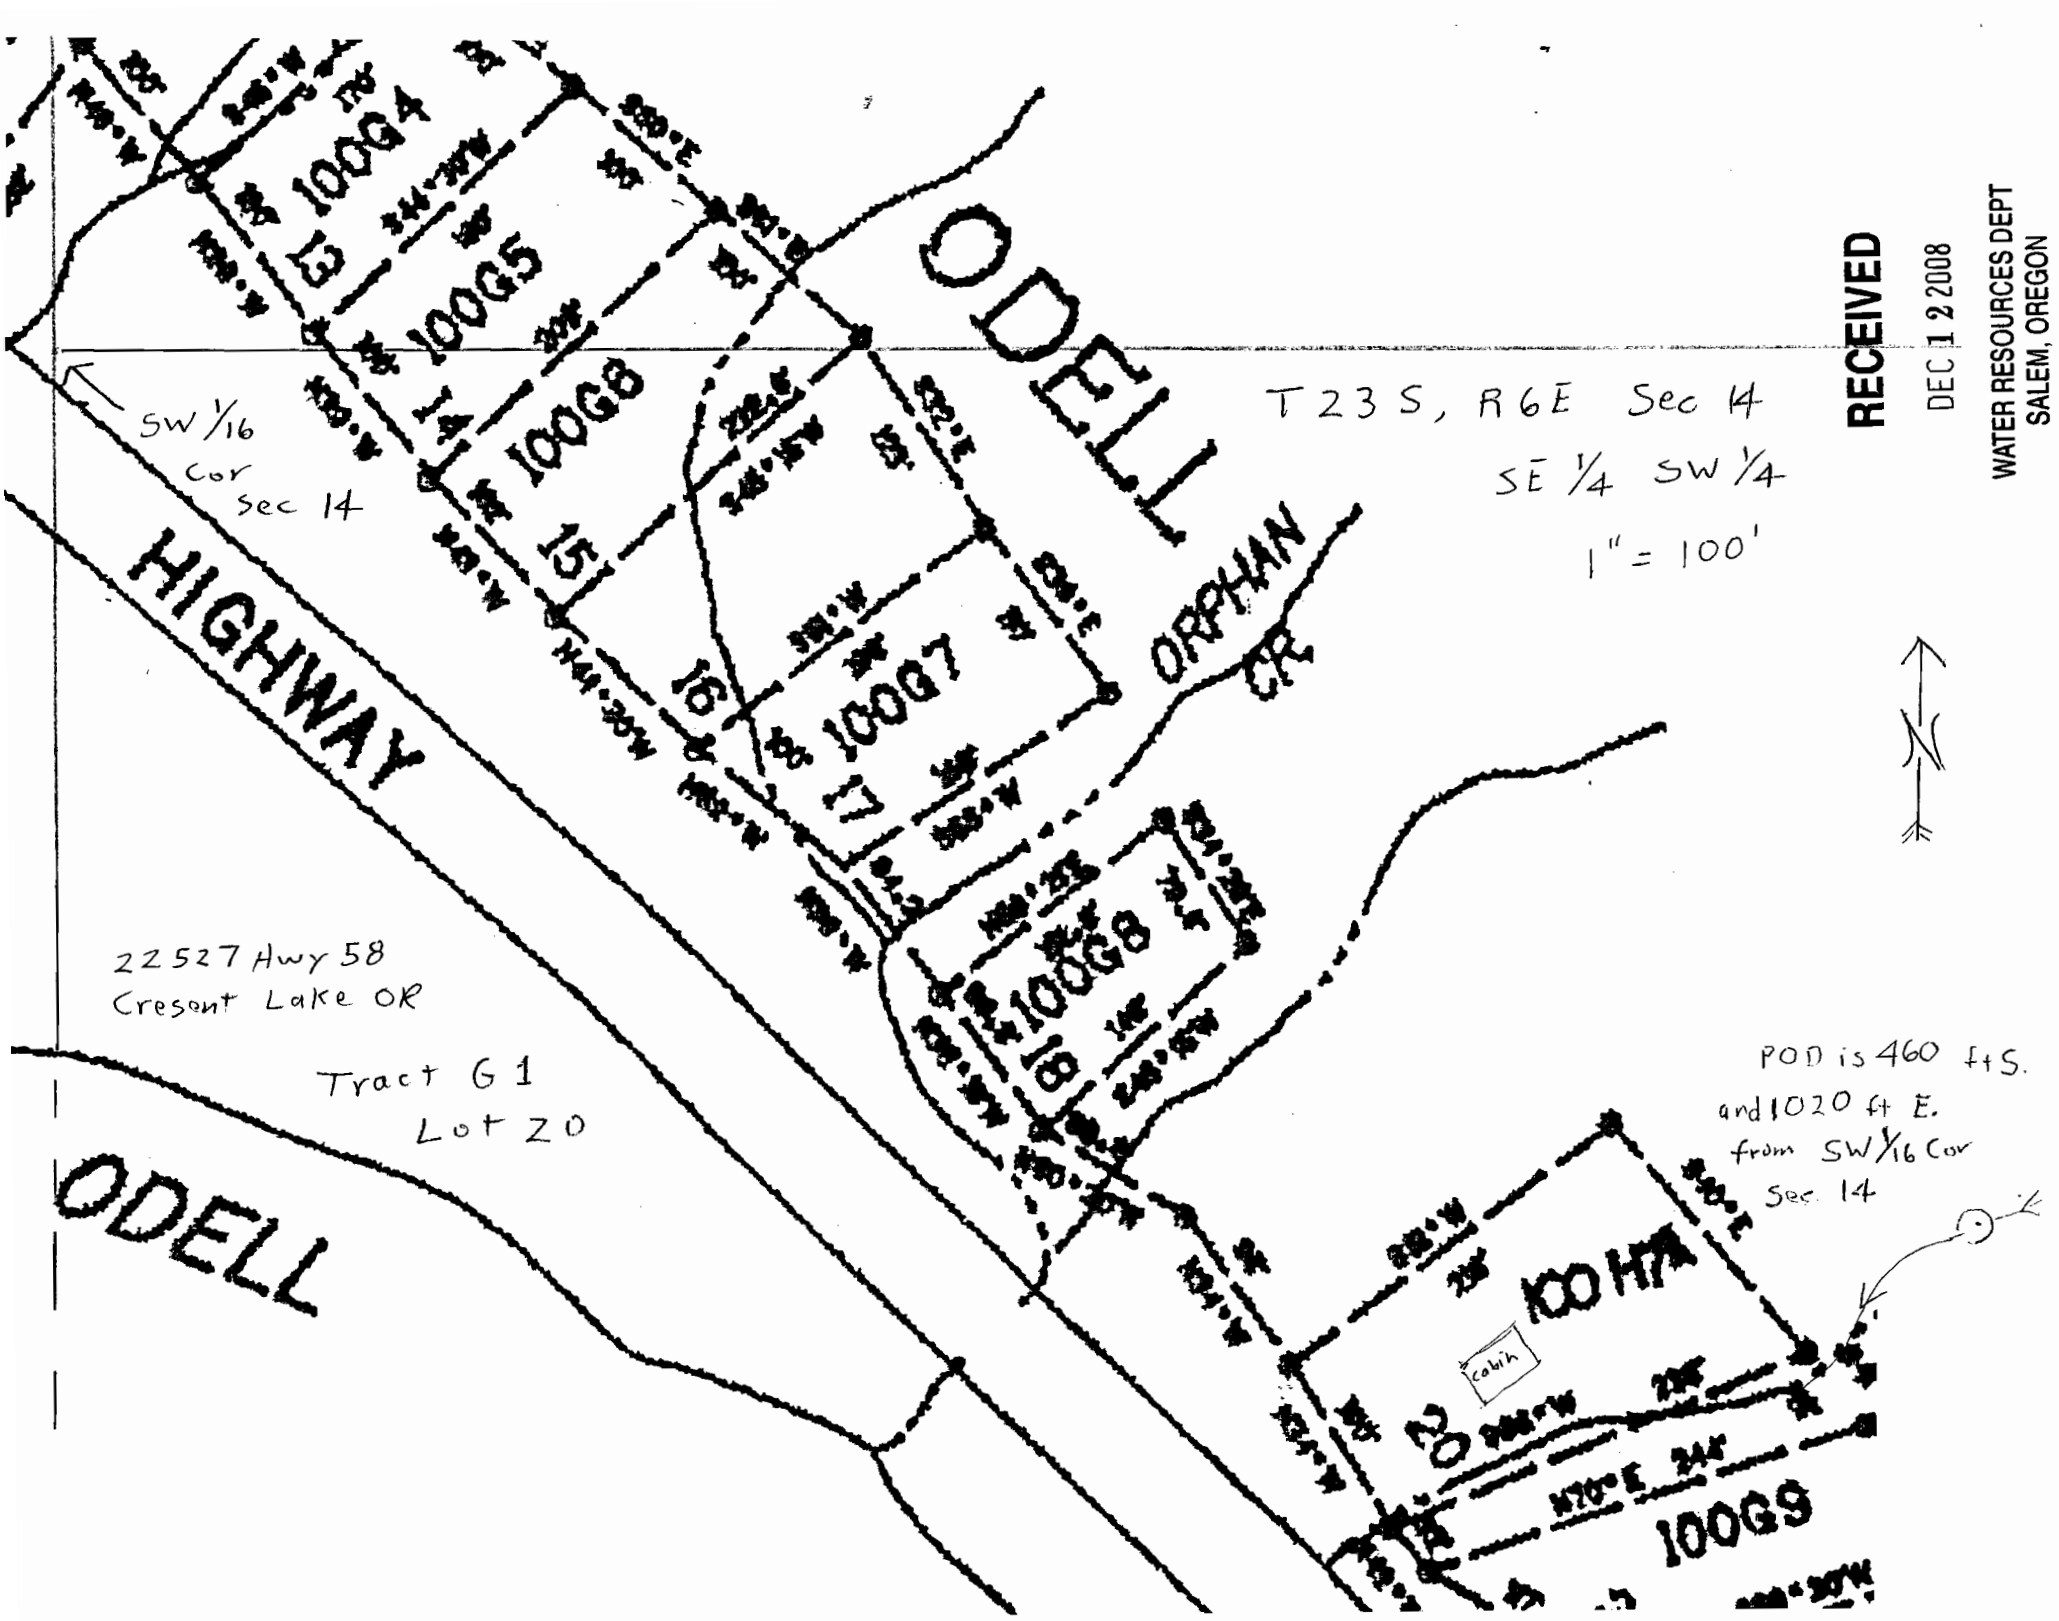

RECEIVED

DEC 12 2008

WATER RESOURCES DEPT
SALEM, OREGON

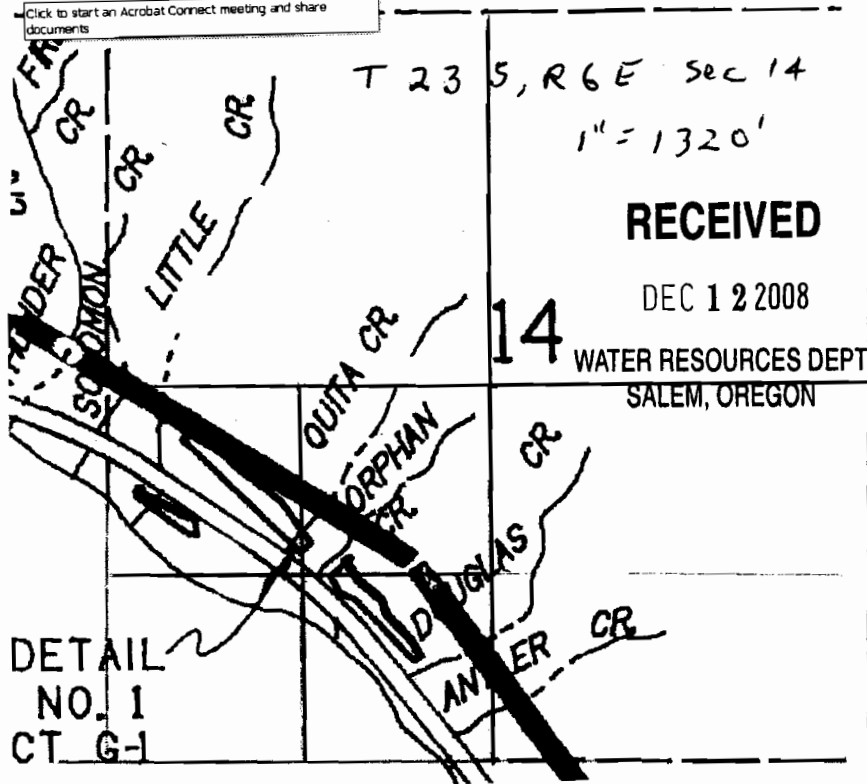


property address
22527 HWY 58

THIS MAP WAS PREPARED FOR
ASSESSMENT PURPOSE ONLY.

DETAIL MAP OF T.23S. R.06E. W.M.
KLAMATH COUNTY

23 06
DETAIL MAP NO. 1

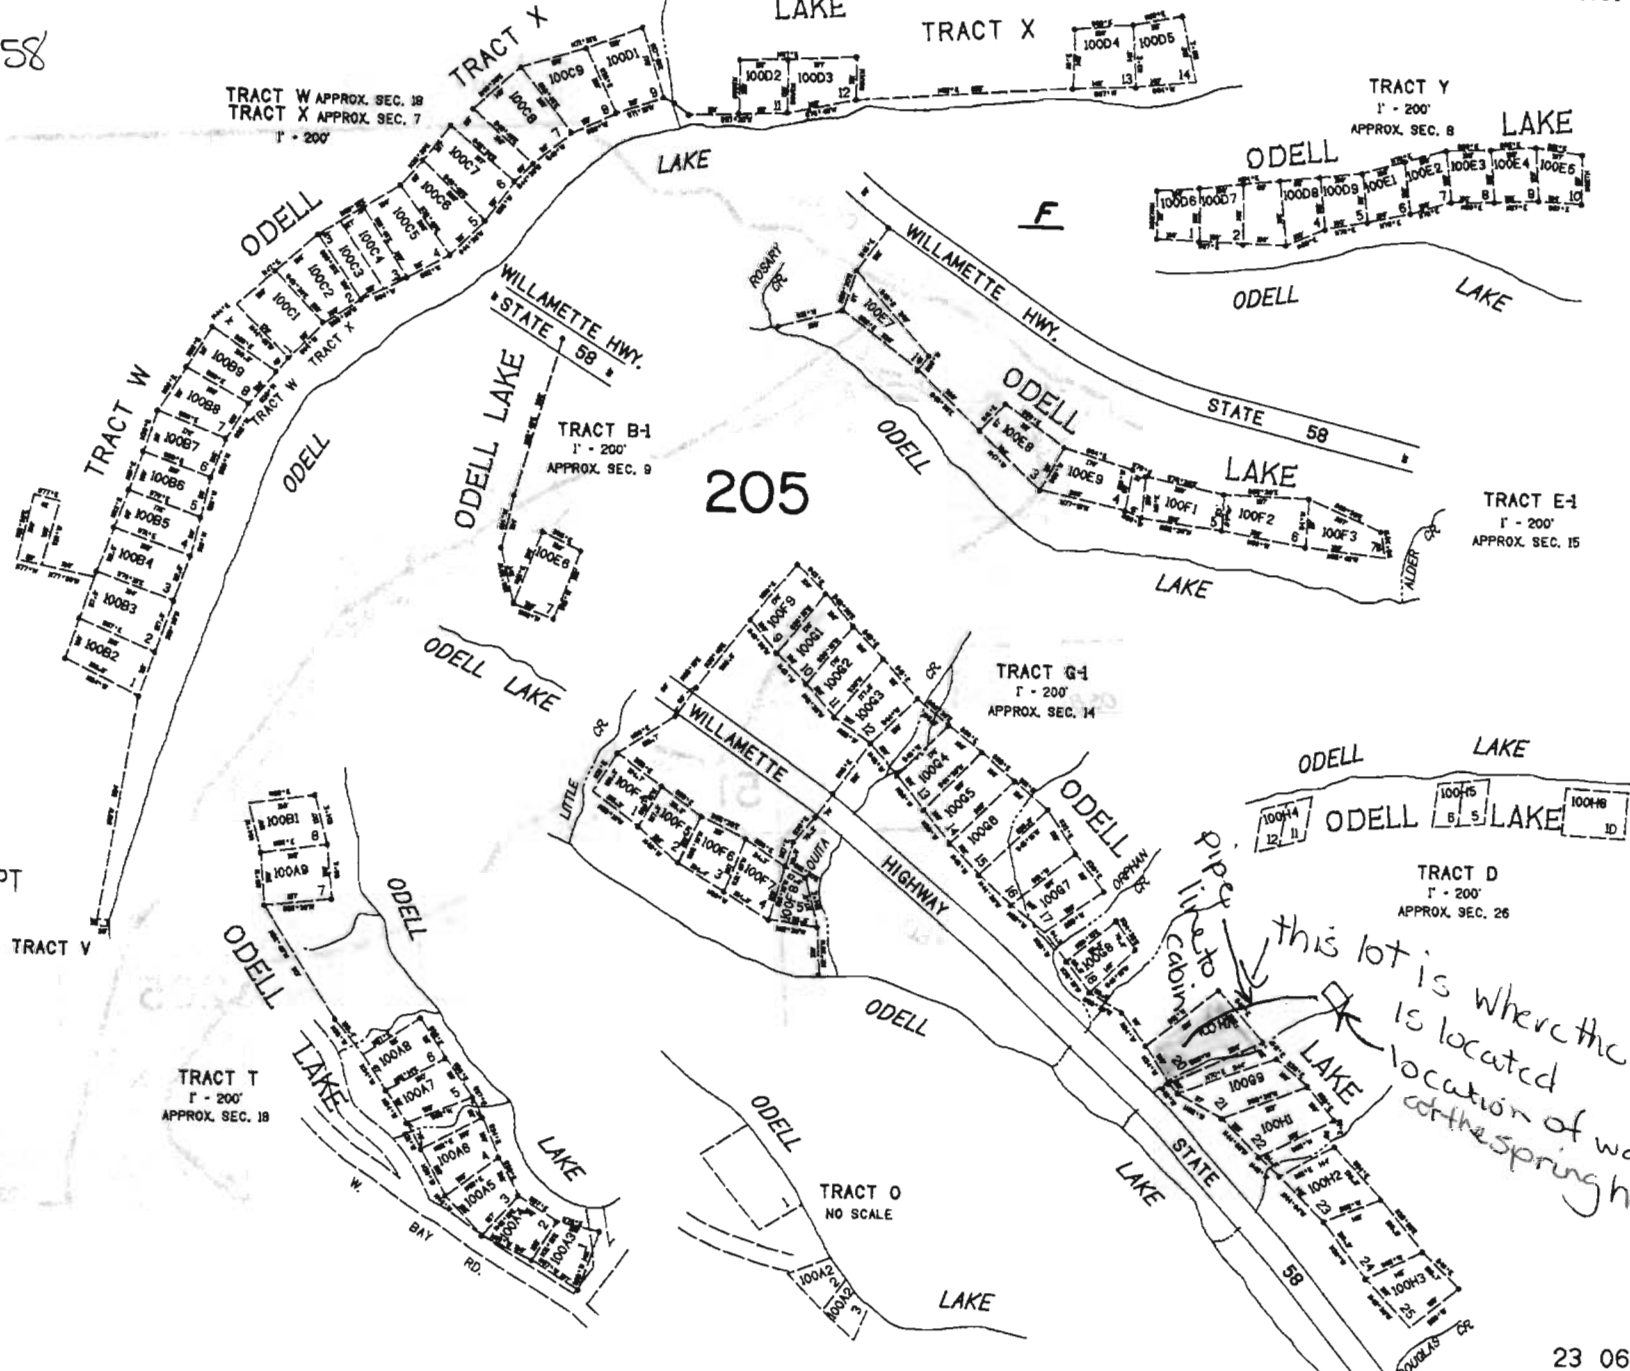


RECEIVED

DEC 12 2008

WATER RESOURCES DEPT
SALEM, OREGON

Odell Lake Tract G

Section 14 T. 23 S. R. 6 E.

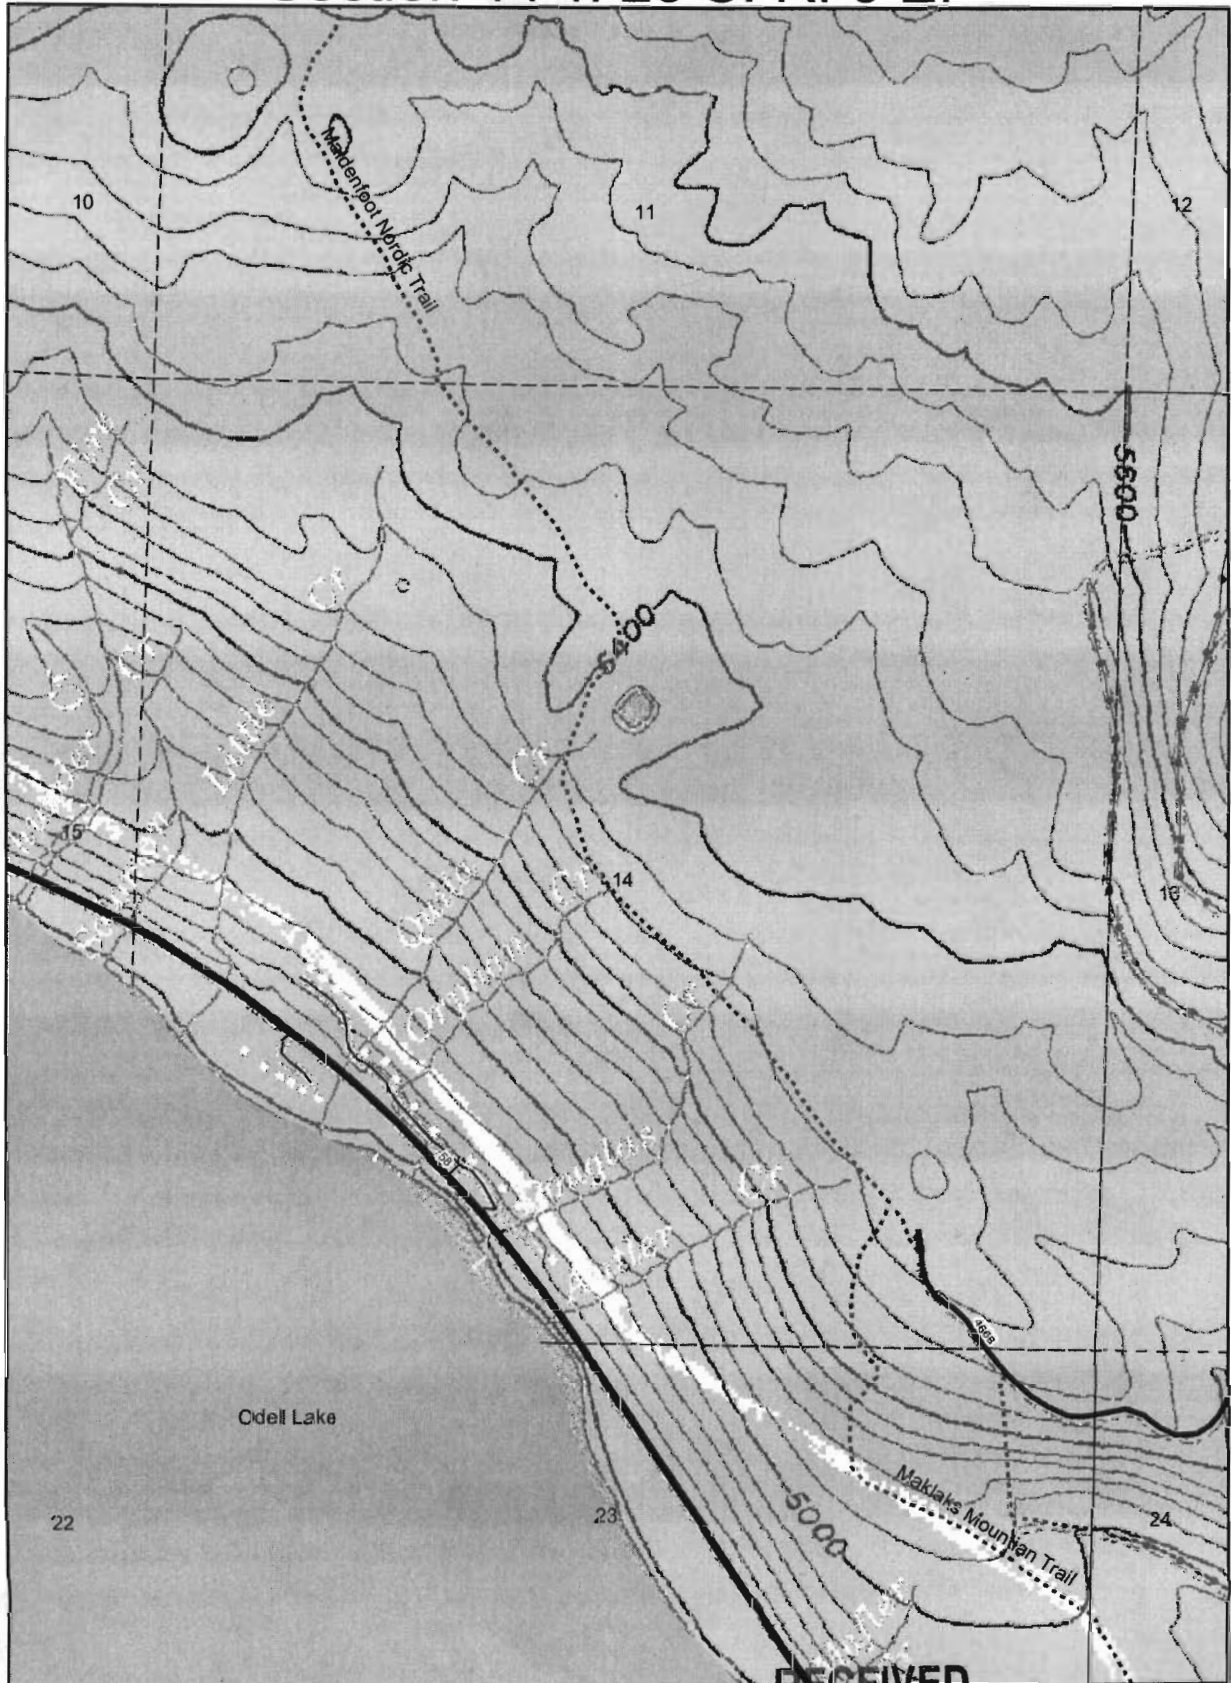

RECEIVED

0 500 1,000 2,000 Feet

DEC 12 2008

R. Grim
9/18/2008

WATER RESOURCES DEPT
SALEM, OREGON

over for detailed
lot maps