


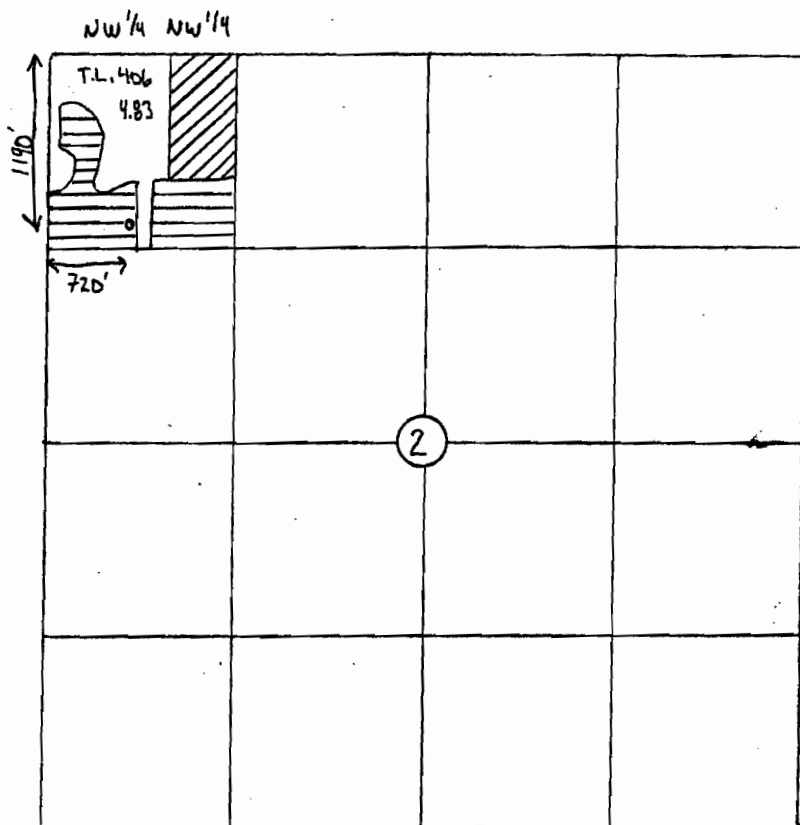

Scale
1" = 1320'

Well Location: 1190' South and 720' East of the NW¹/₄
Corner of Section 2, Township 15 South Range 12 East, W.M.



DAN Oxford Application

▨ - Existing Irrigation under Permit 6-15993

▩ - Additional irrigation under this Application (4.83 Acres)

Application No. Permit No.
IN NAME OF

.....

Surveyed 19....., by

RECEIVED

DEC 15 2008

WATER RESOURCES DEPT
SALEM, OREGON