

SECTION PLAT

6-17155


Section 15

Township 24-S

Range 33-E

County of Harney State of OR

NORTH

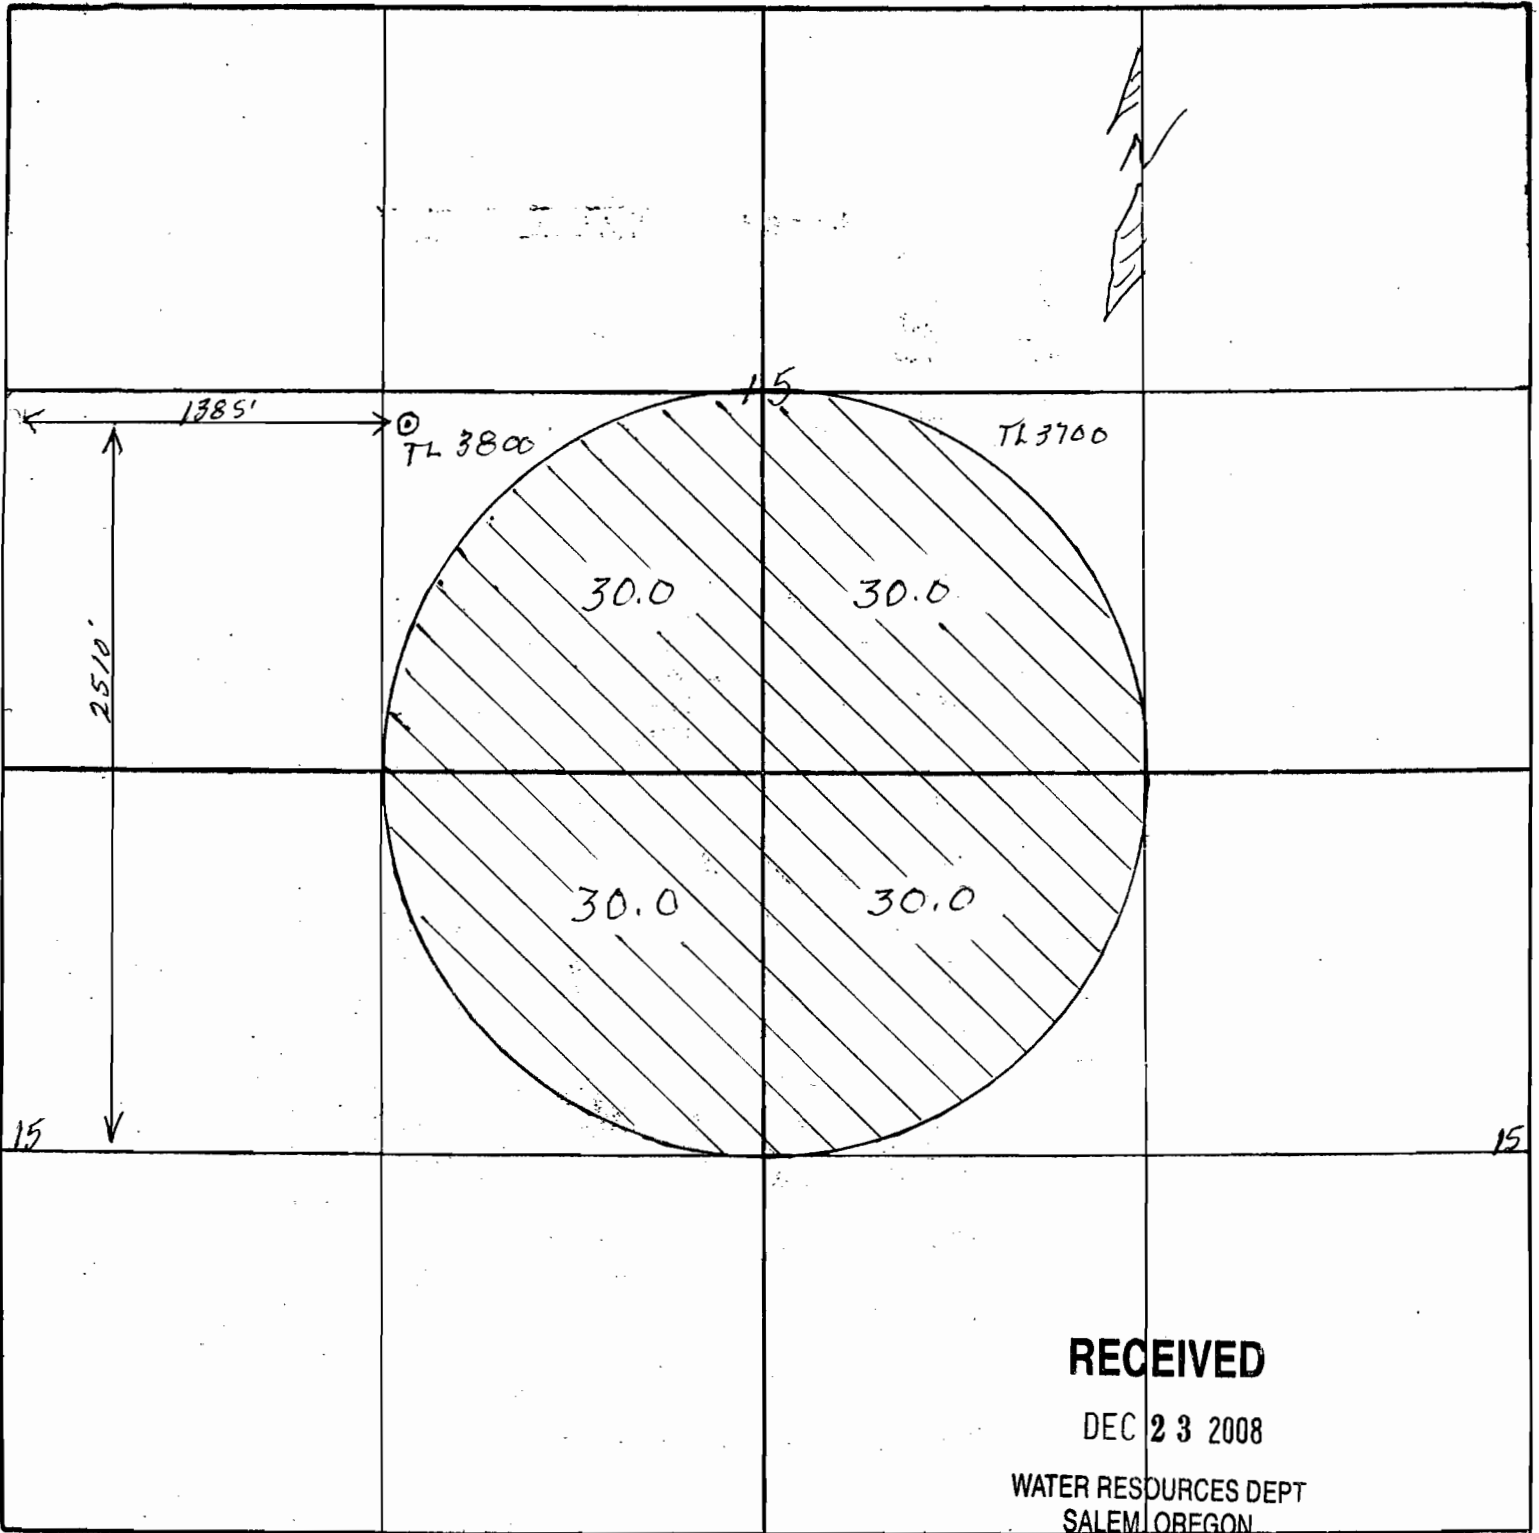

RECEIVED

DEC 23 2008

WATER RESOURCES DEPT
SALEM, OREGON

8

Remarks scale - 8" = 1 mile - 660) .