


T. 1 N. R. 3 E. W. M

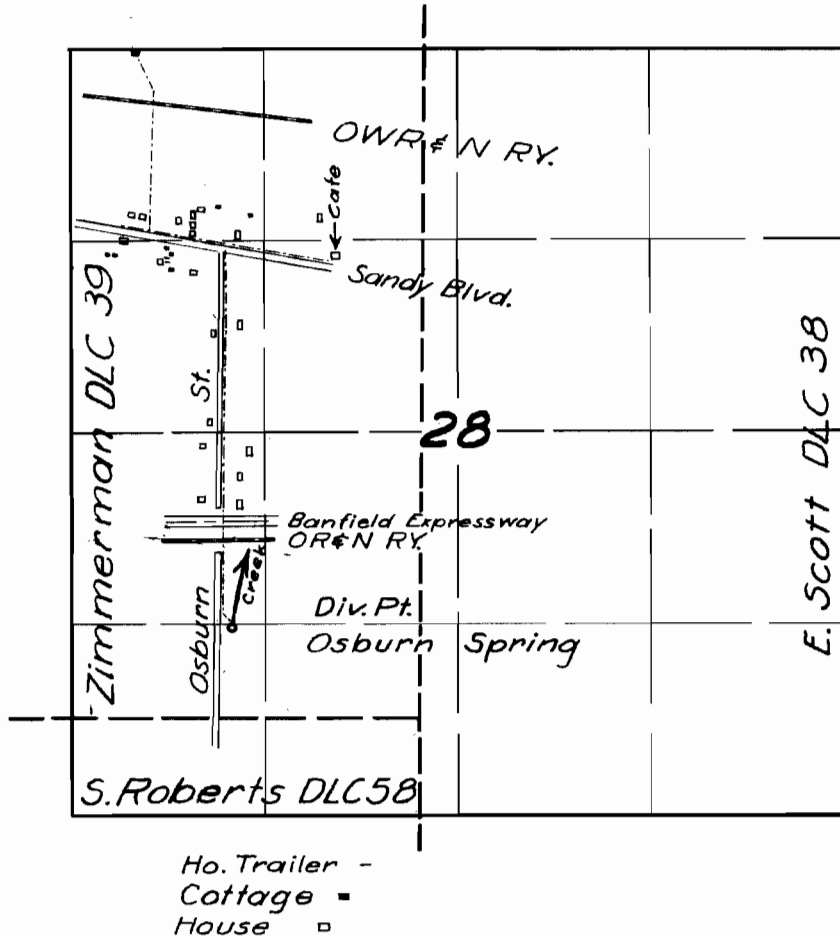

FINAL PROOF SURVEY

UNDER

Application No. 27548.. Permit No. 21728...

IN NAME OF

Paul P. Jr. & Elsie Wilene Schatz

Surveyed 26 July 1956, by *Tom Bish*