


MAP 3: ROADS AND DRAINAGE

EHLERS TRACT
 Sections 29, 32 & 33
 T10S, R6W, Benton Co.
 Map Scale: 1" = 600'

- Surfaced roads
- - - Unsurfaced roads
- ★ Stream crossing structure
- ★ Drainage structure

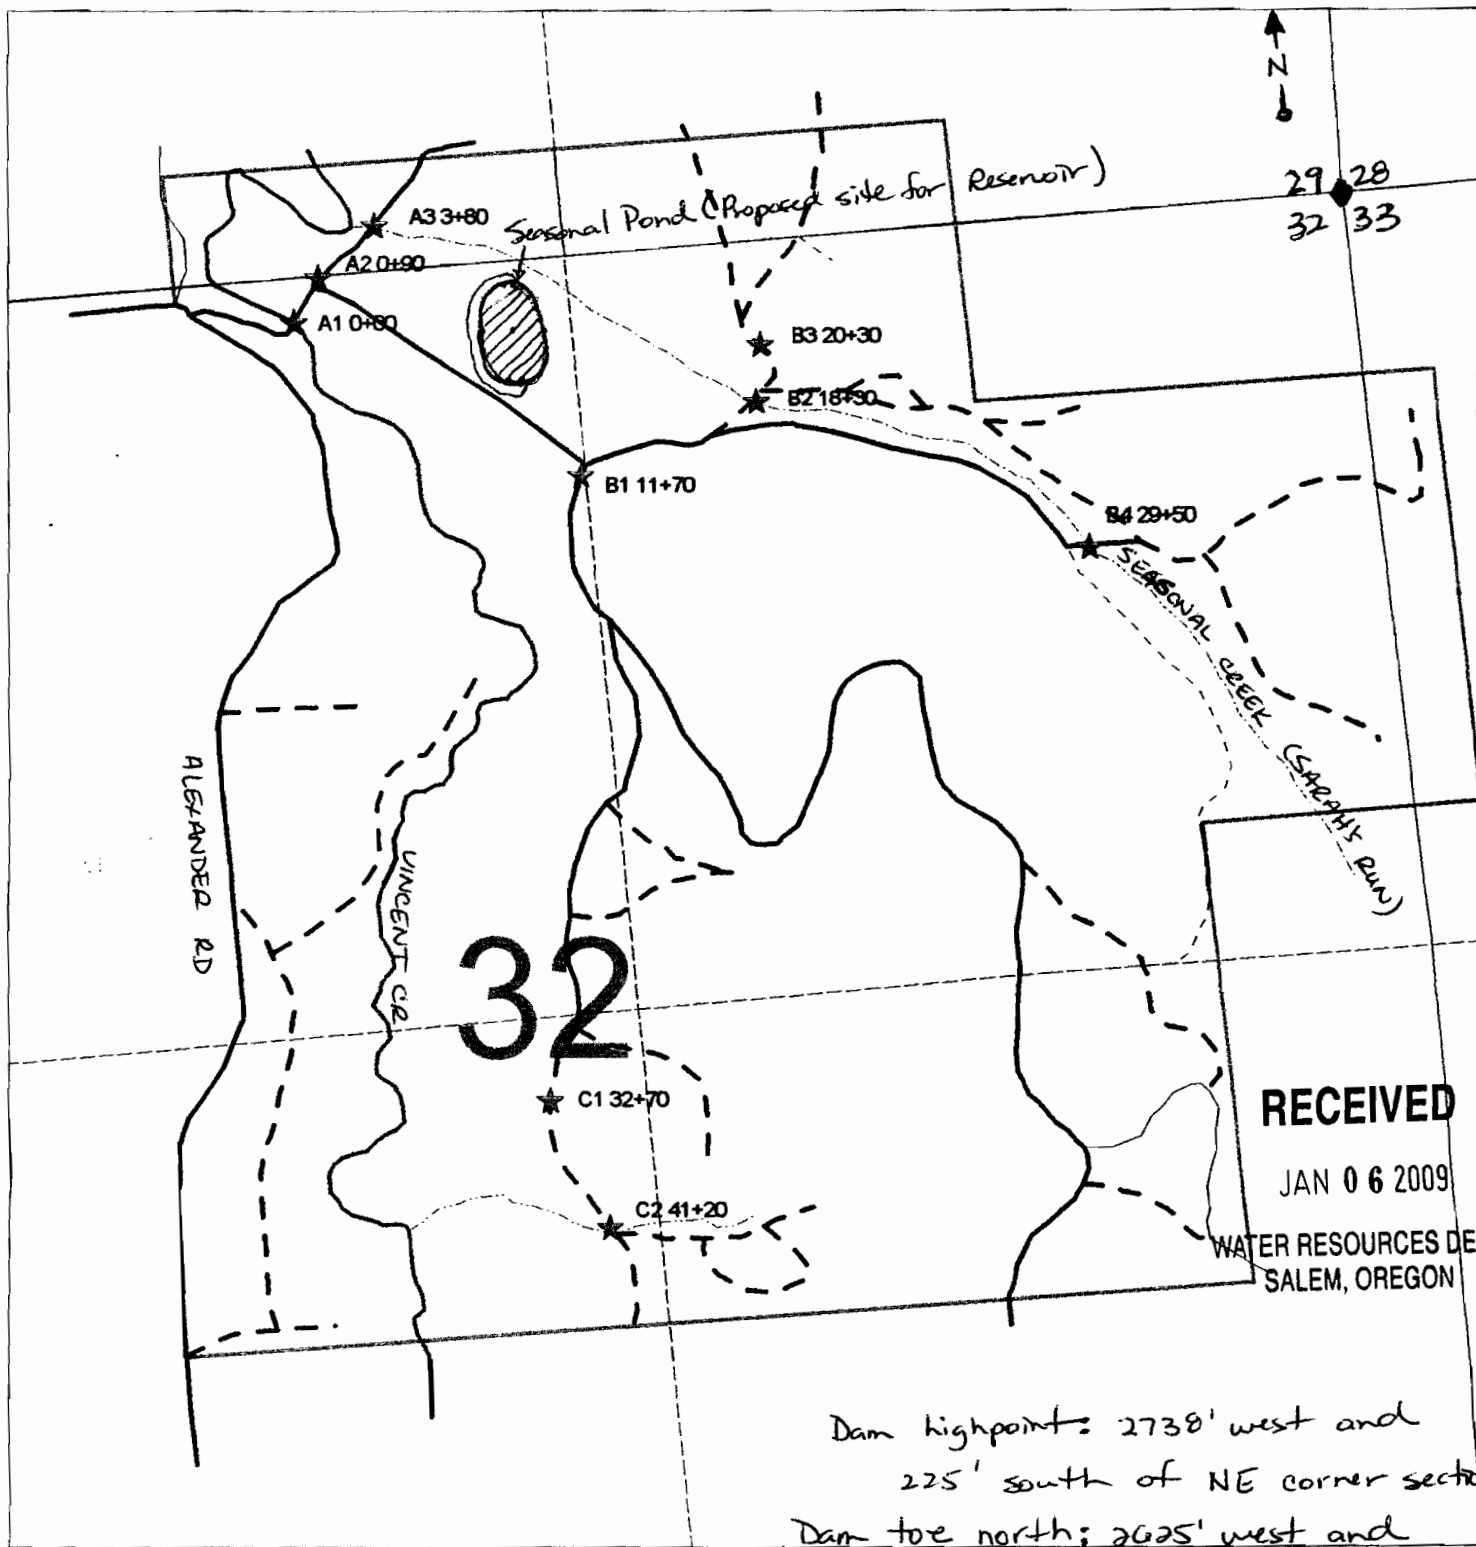

Dam highpoint: 2738' west and
 225' south of NE corner section 32
 Dam toe north: 2625' west and
 75' south of NE corner section 32
 Dam toe south: 2425' west and
 375' south of NE corner section 32


POND: T10S
 R6W
 S32
 NW 1/4 NE 1/4
 Tax Lot #100

MAP 3: ROADS AND DRAINAGE

WORK
COPY

EHLERS TRACT
Sections 29, 32 & 33
T10S, R6W, Benton Co.
Map Scale: 1" = 600'
APPROX CORRECTED
ADJUSTED SCALE

- Surfaced roads
- - - Unsurfaced roads
- ★ Stream crossing structure
- ★ Drainage structure

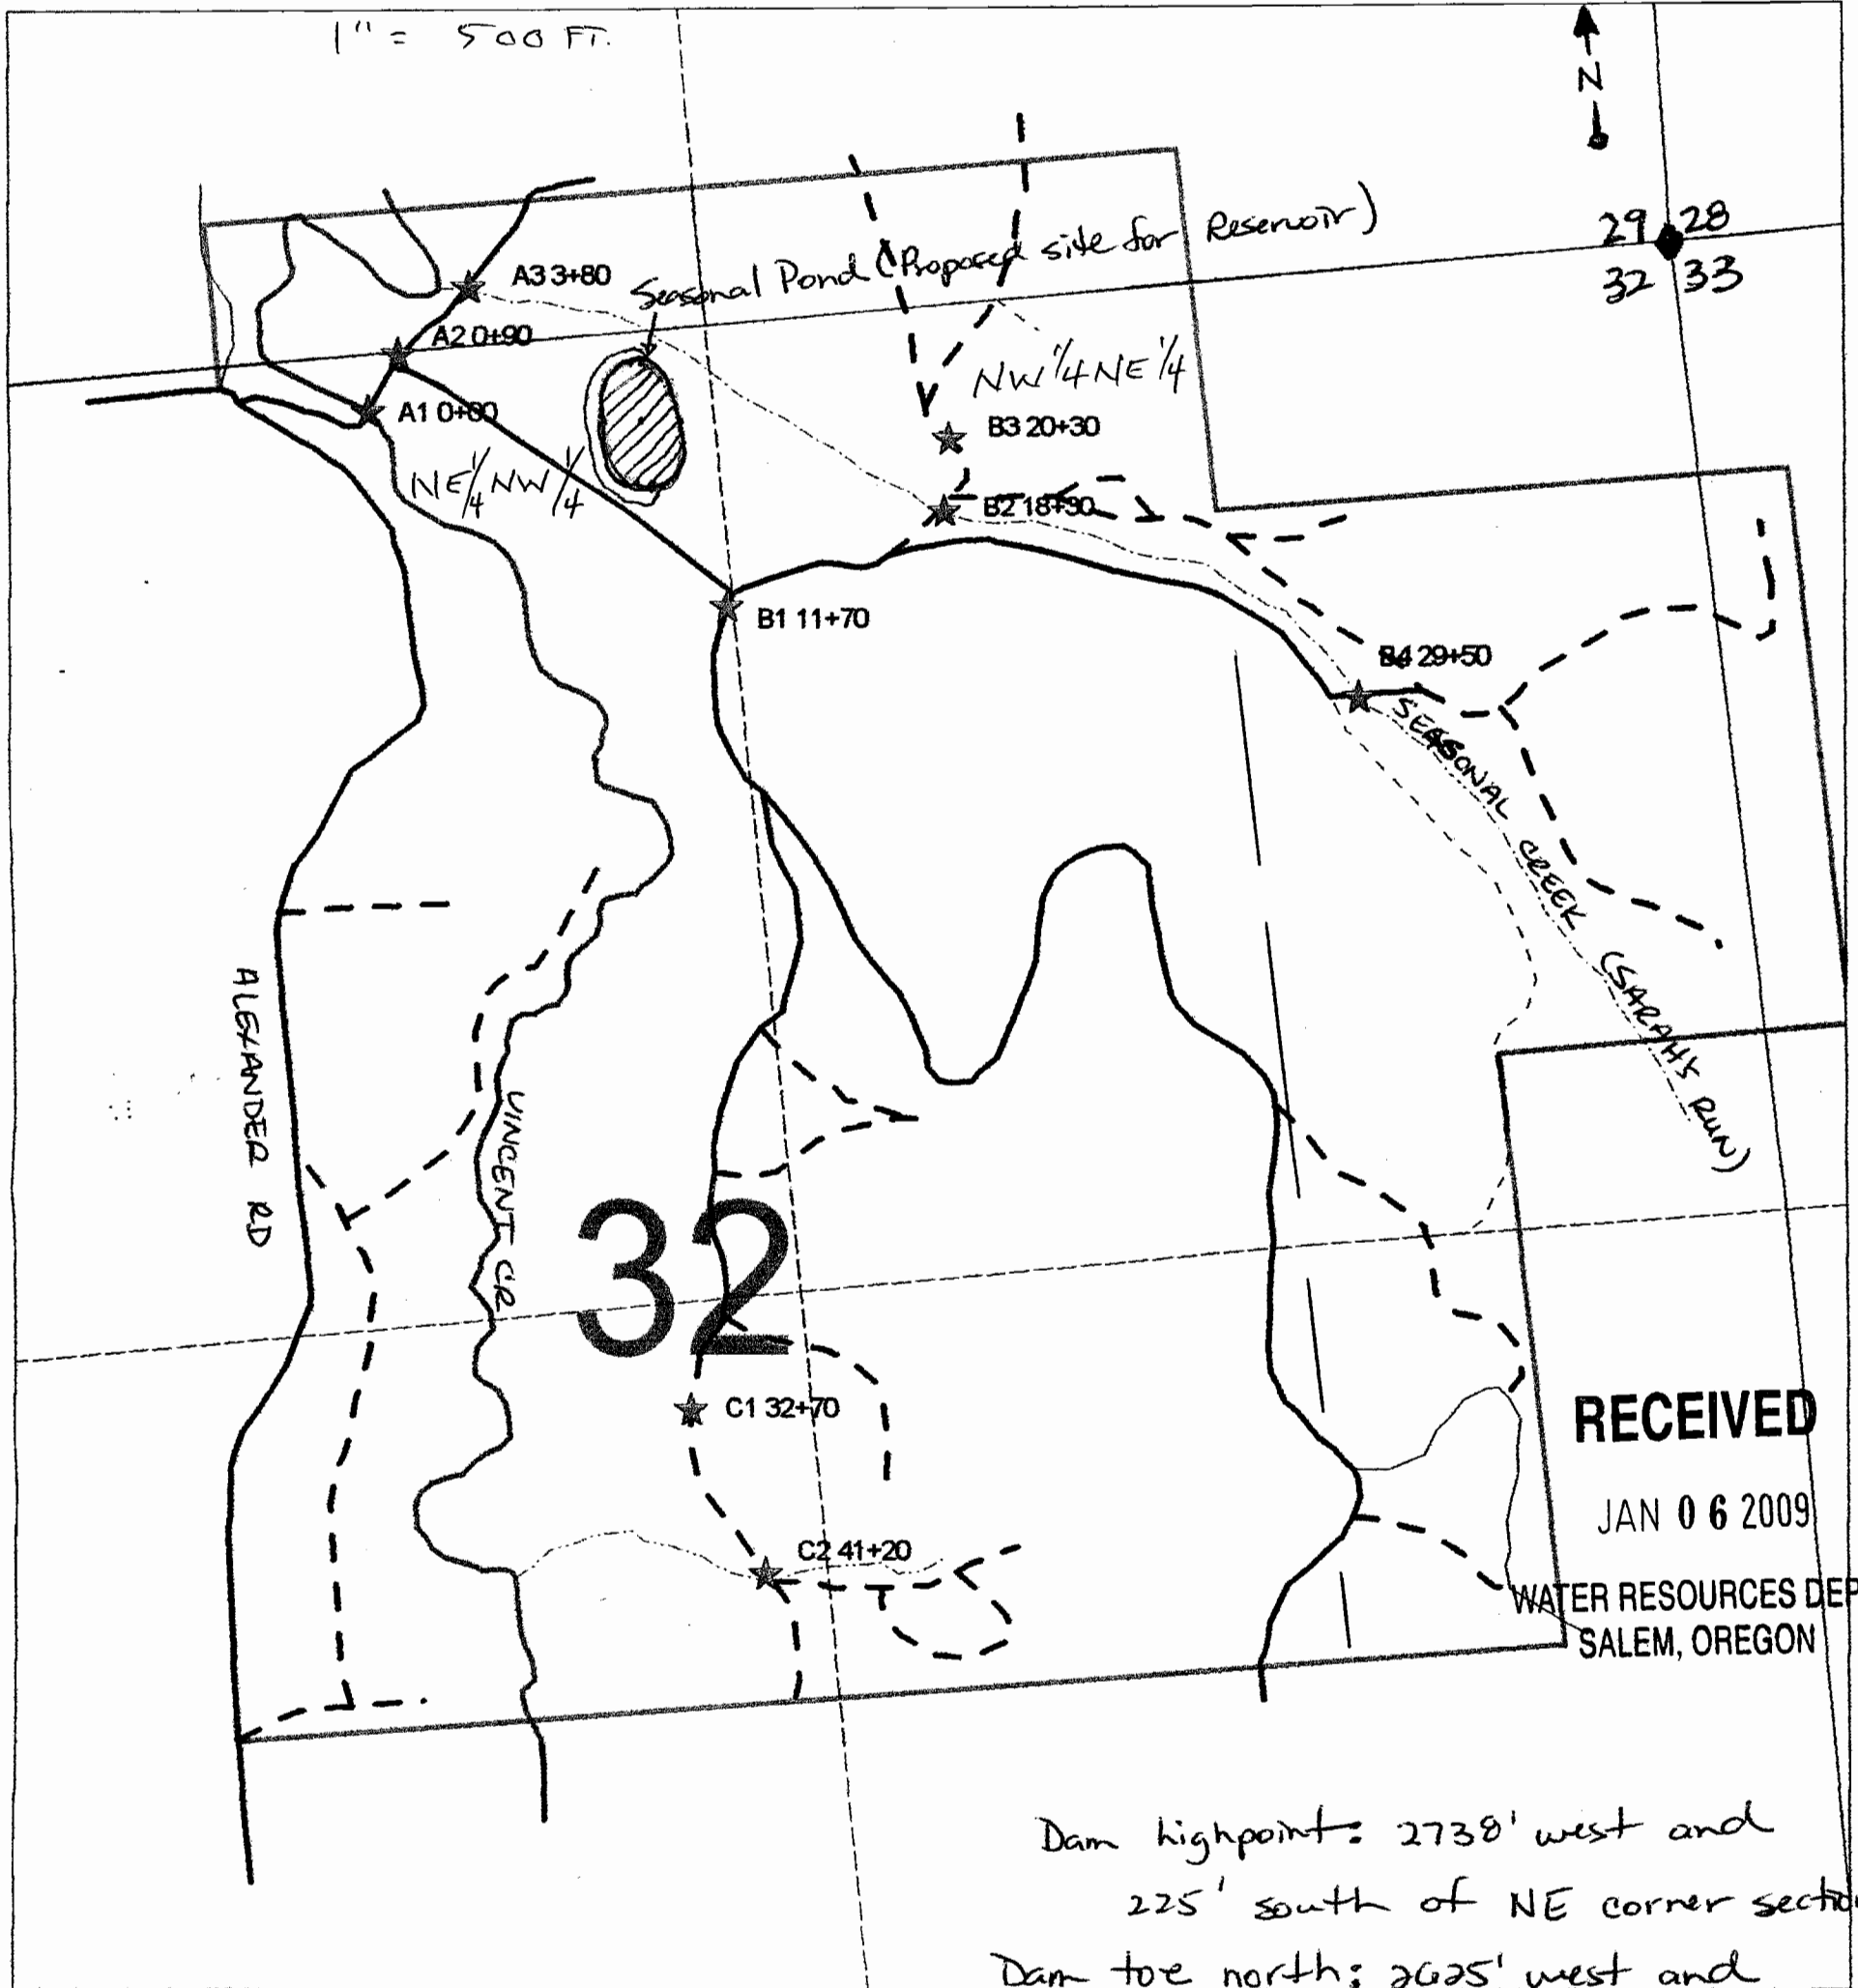

Dam highpoint: 2738' west and
225' south of NE corner section 32
Dam toe north: 2625' west and
75' south of NE corner section 32
Dam toe south: 2625' west and
375' south of NE corner section 32

POND: T10S
R6W
S 32
NW 1/4 NE 1/4
Tax Lot #100