CORRECTED MAP

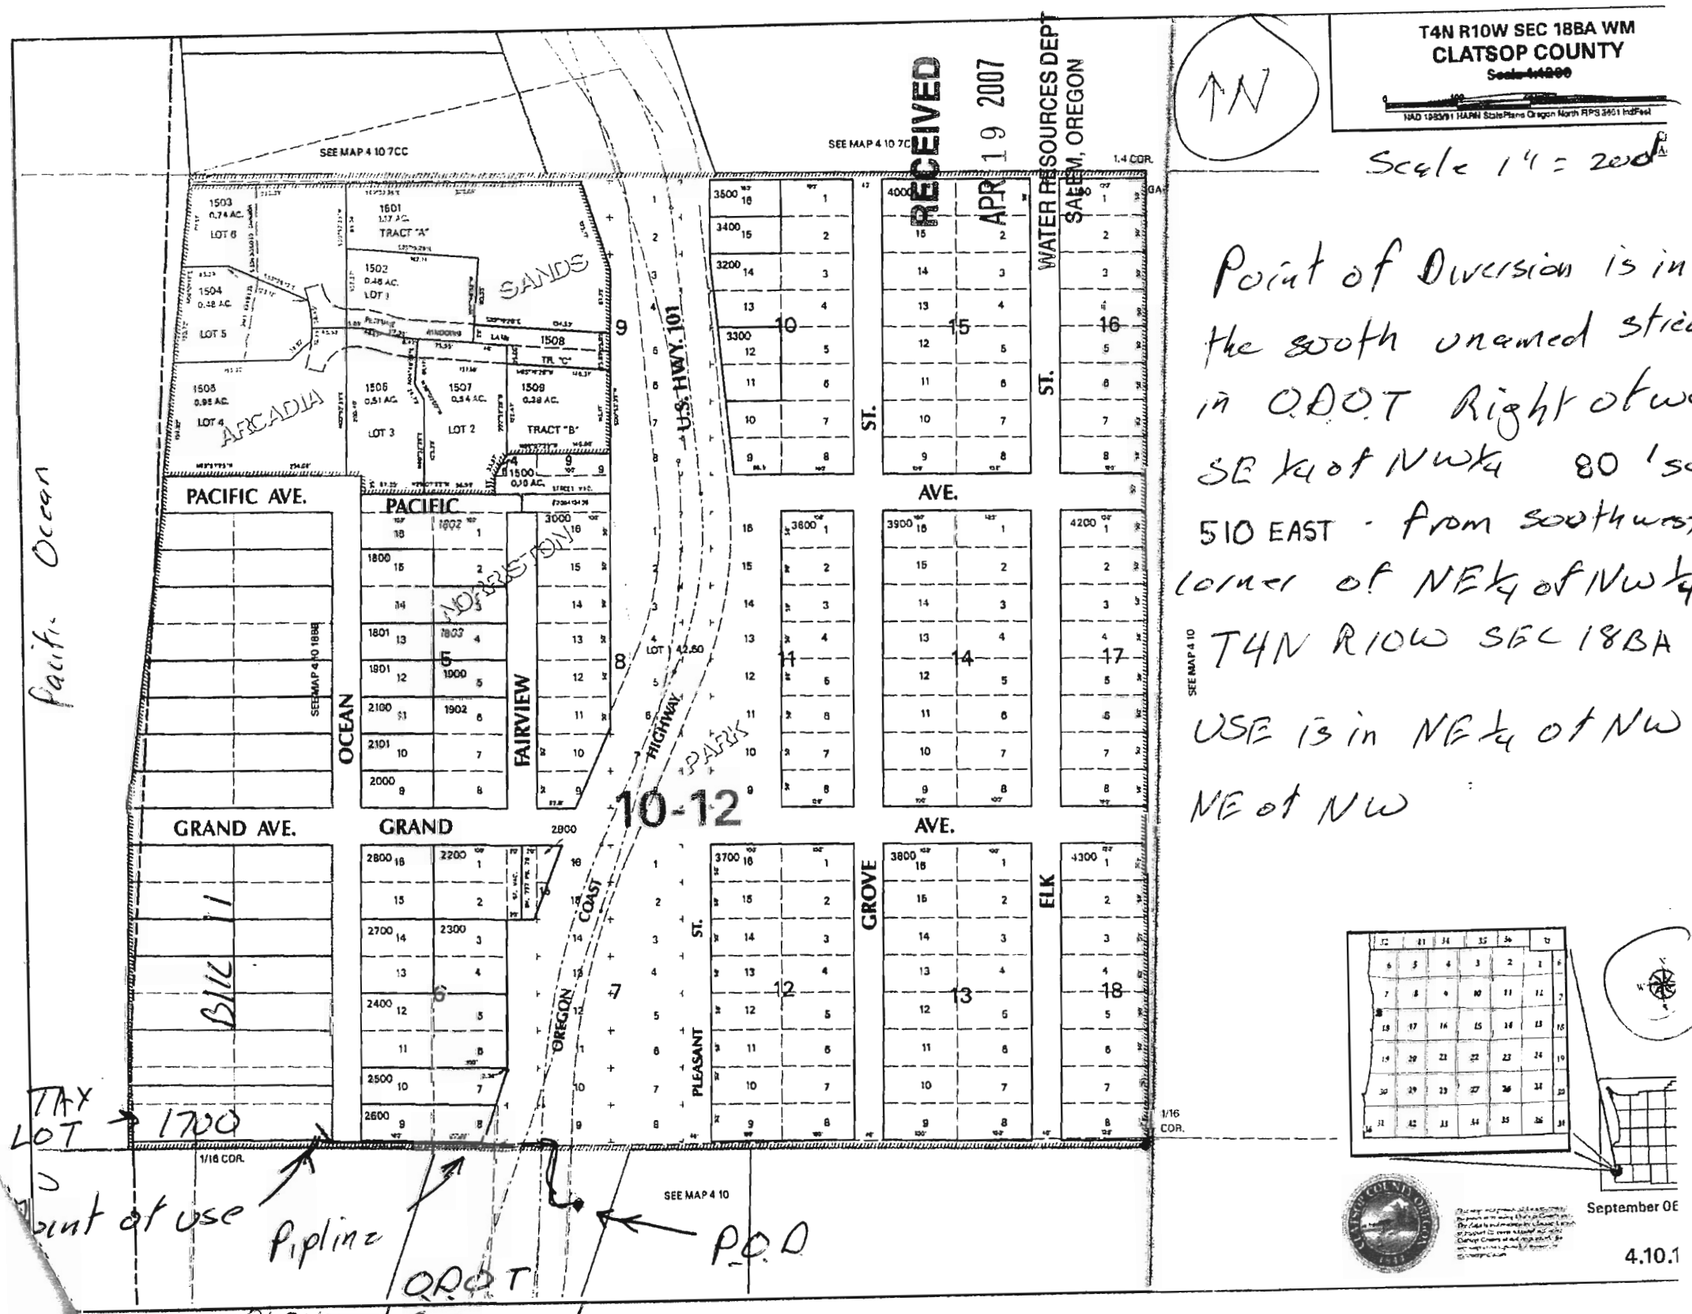


RECEIVED
APR 19 2007
WATER RESOURCES DEPT
SALEM, OREGON

N

Scale 1" = 200'

Point of Diversion is in the south unamed stream in ODOT Right of way SE ¼ of NW¼ 80' south 510 EAST - from southwest corner of NE¼ of NW¼ T4N R10W SEC 18BA

USE is in NE¼ of NW¼ NE of NW

I accept this map

John Manning

RECEIVED
MAY 07 2007
WATER RESOURCES DEPT
SALEM, OREGON