


SECTION PLAT

Section 5 Township 25-5 Range 33-E
County of Harney State of Oregon

NORTH

G-17169

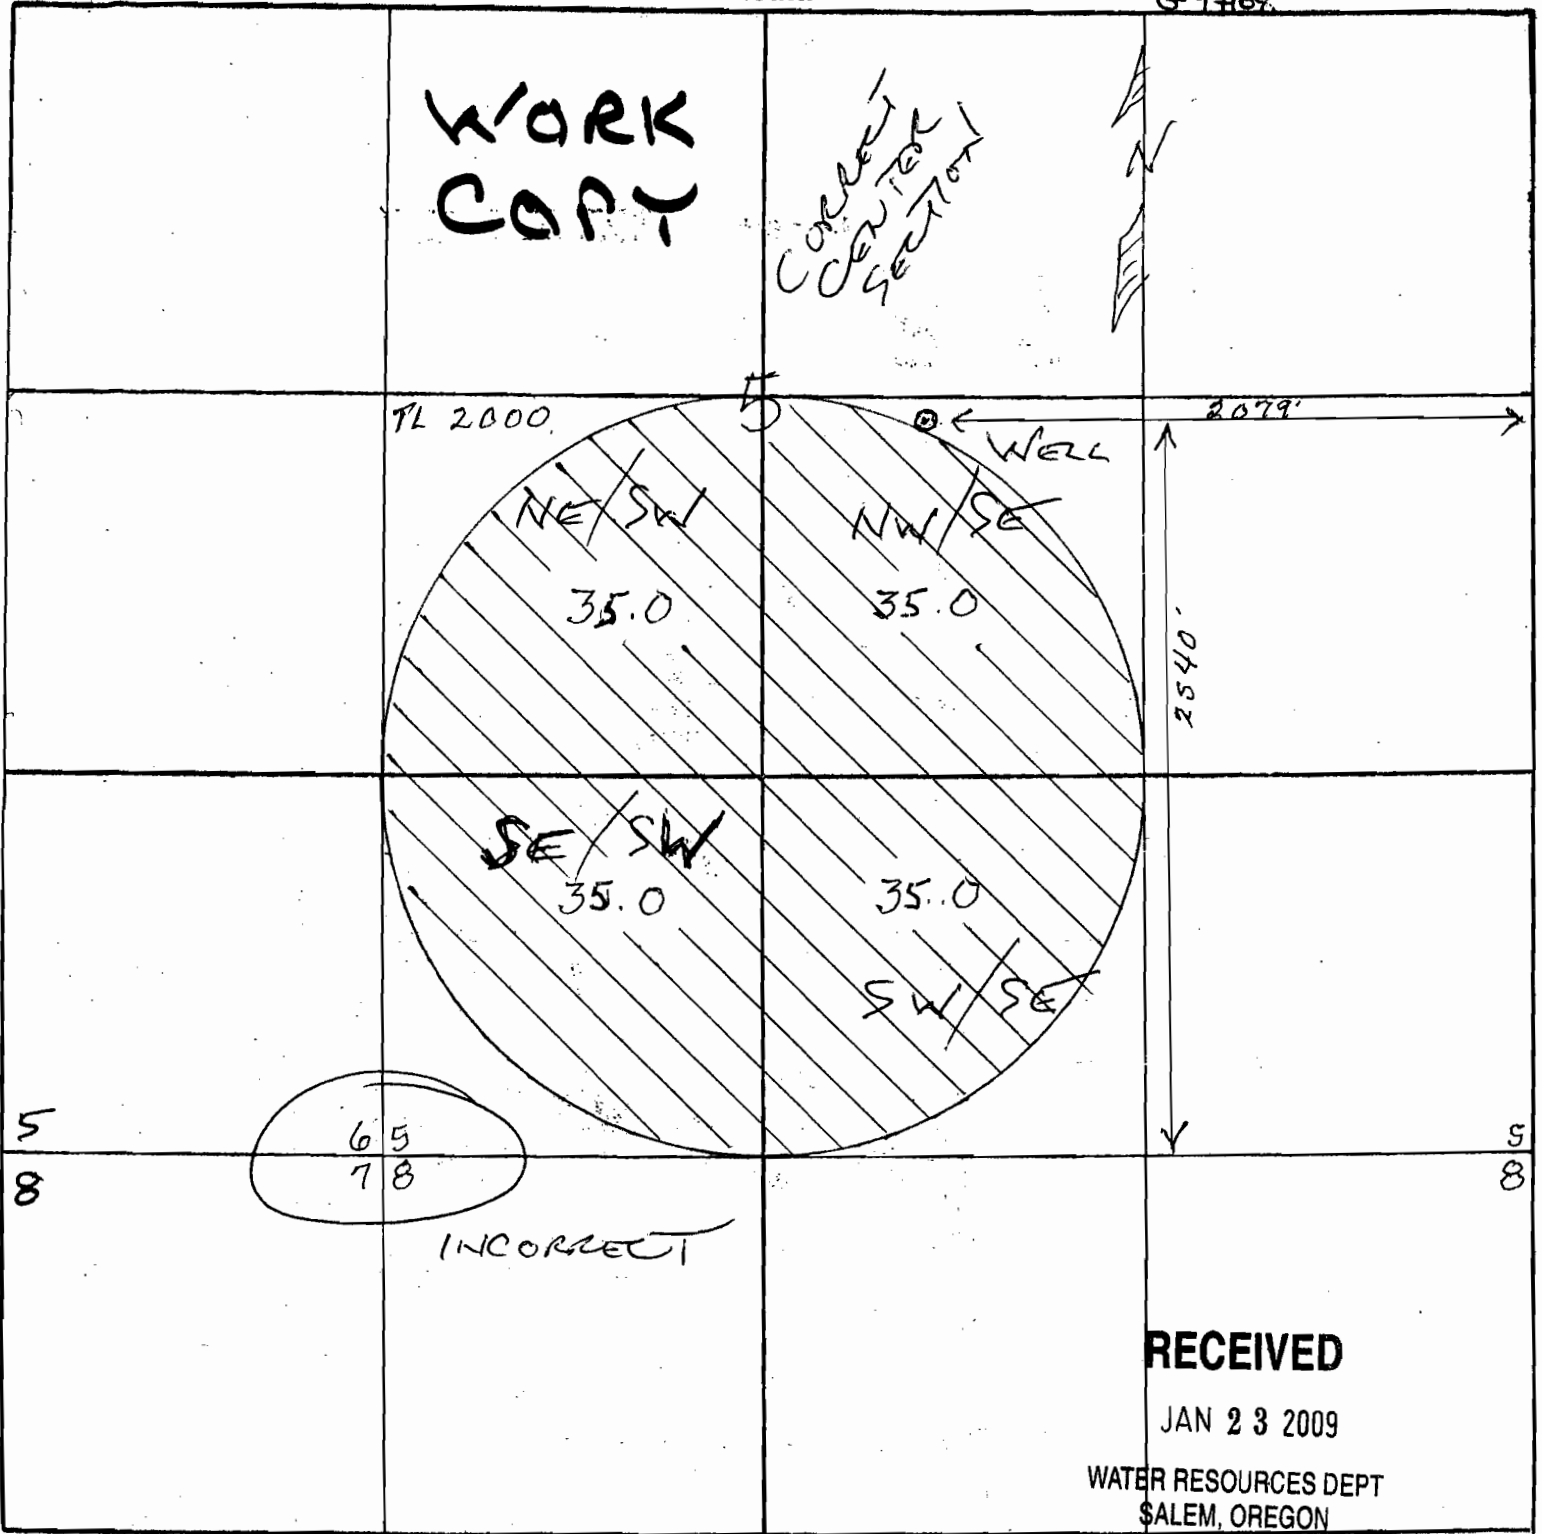

Remarks scale - 8" = 1 mile - 660) -


SECTION PLAT

Section 5 Township 25-S Range 33-E

County of Harney State of Oregon

NORTH

G-17168

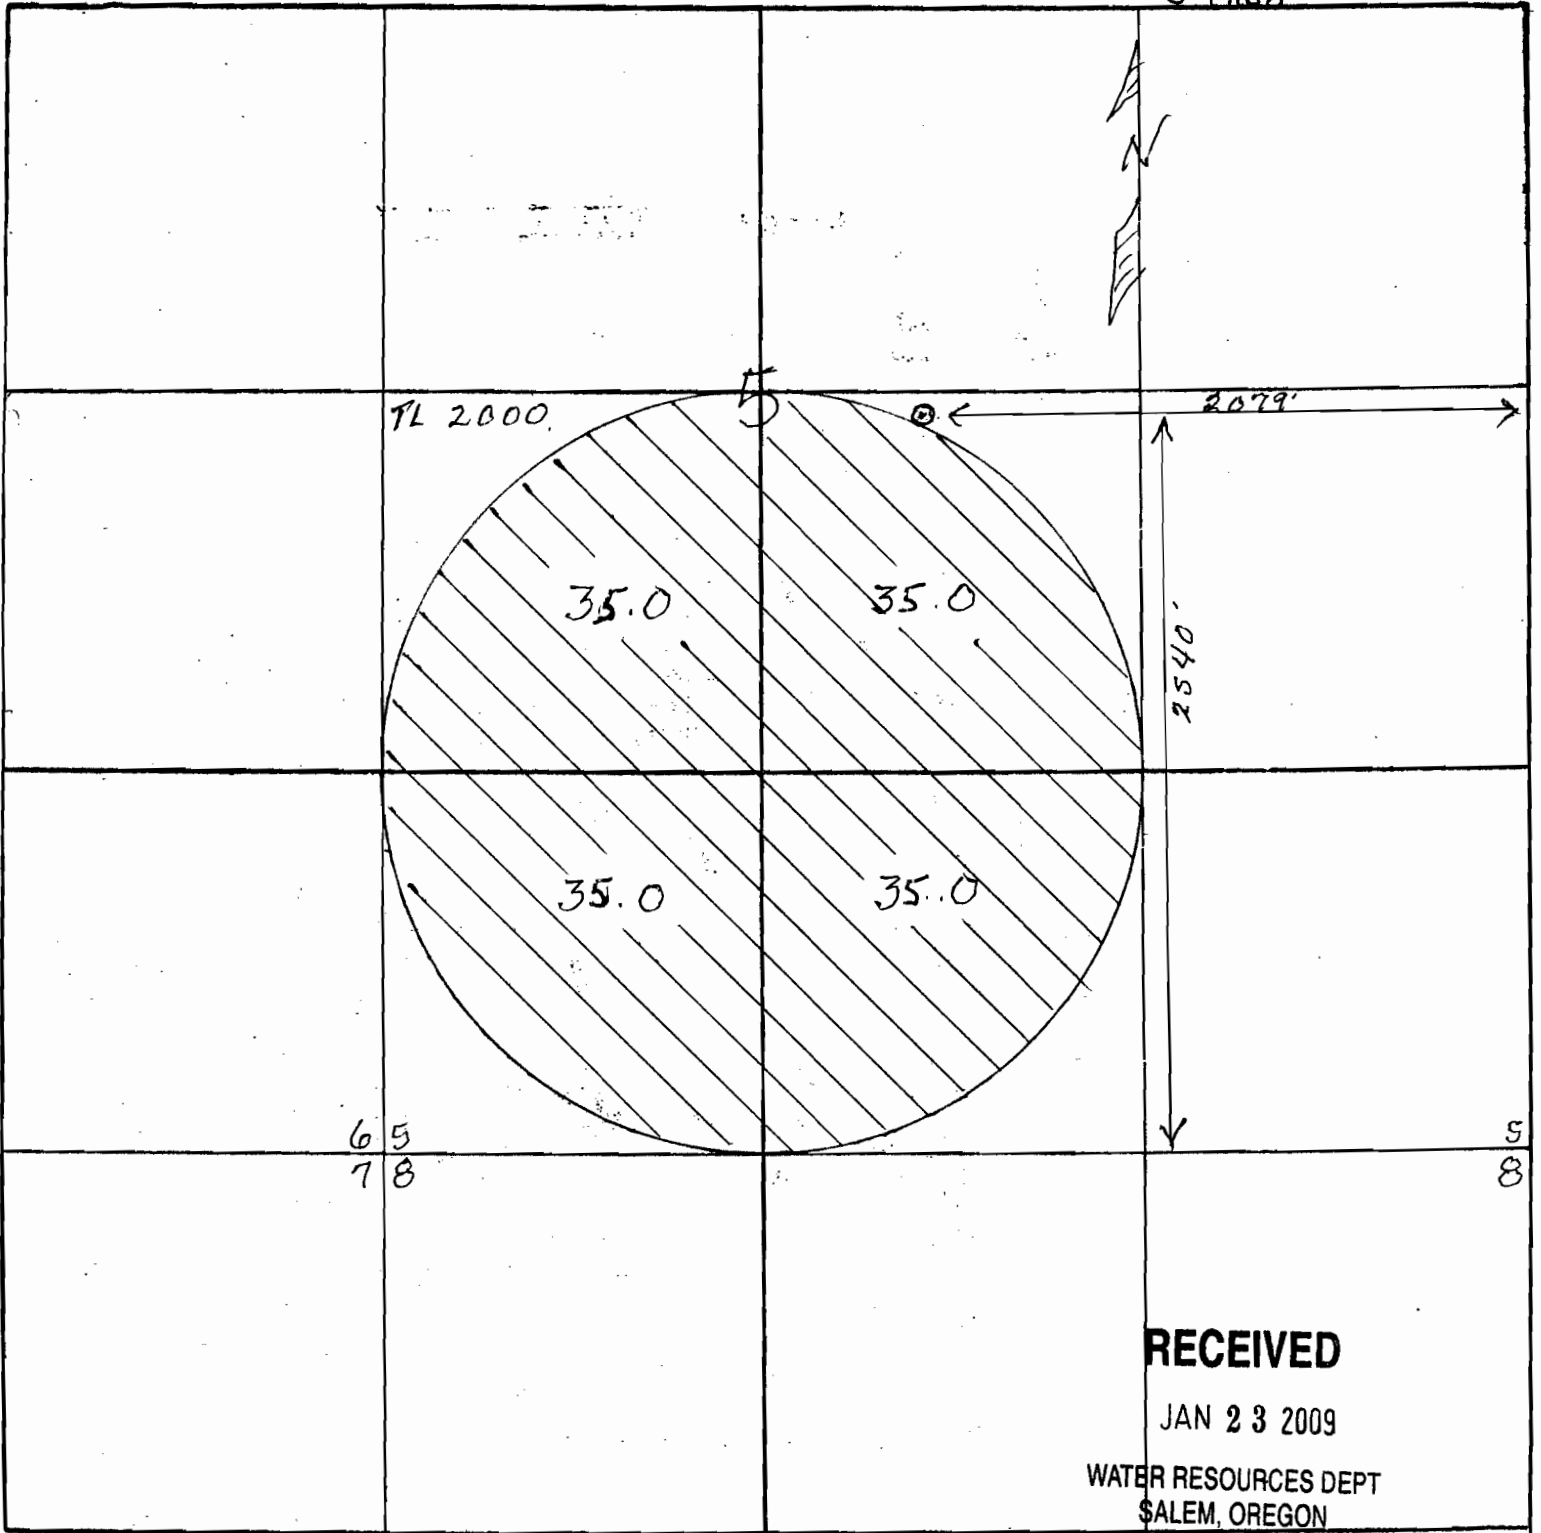

S

Remarks scale - 8" = 1 mile - 660' -