


R-87385-

T 14 S, R 1 W, Sec 1 B

Scale 1" = 400'

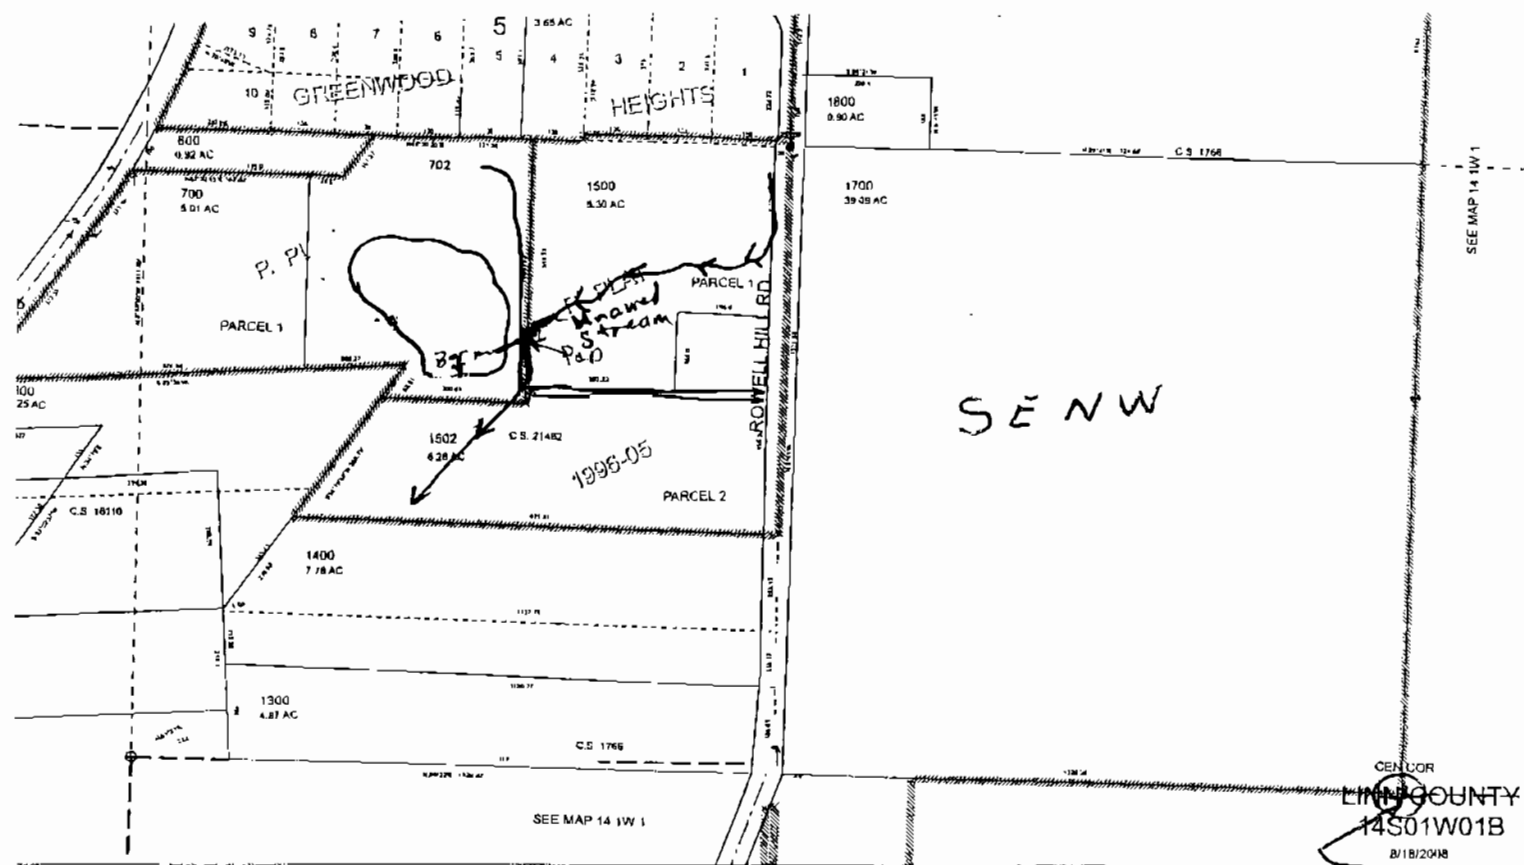

center 1/4 corner

Pond in SW 1/4, NW 1/4, tax lot 702

Berm of Pond is 800' ft. North and 2000' ft. West of Cntr 1/4 Cor.  
 Point of Diversion from  
 Unnamed Creek is 900' ft. North and 1850' ft. West of Cntr 1/4 Cor.  
 - section 1

RECEIVED

JAN 30 2009

WATER RESOURCES DEPT  
SALEM, OREGON